



BASTER

PARENT PARCEL: 06-24-114-000-009

CHILD PARCEL: 06-24-114-000-013, -014

STARTING POINT: CENTERLINE OF WEST RIVER RD & WEST 3RD ST

06-02091

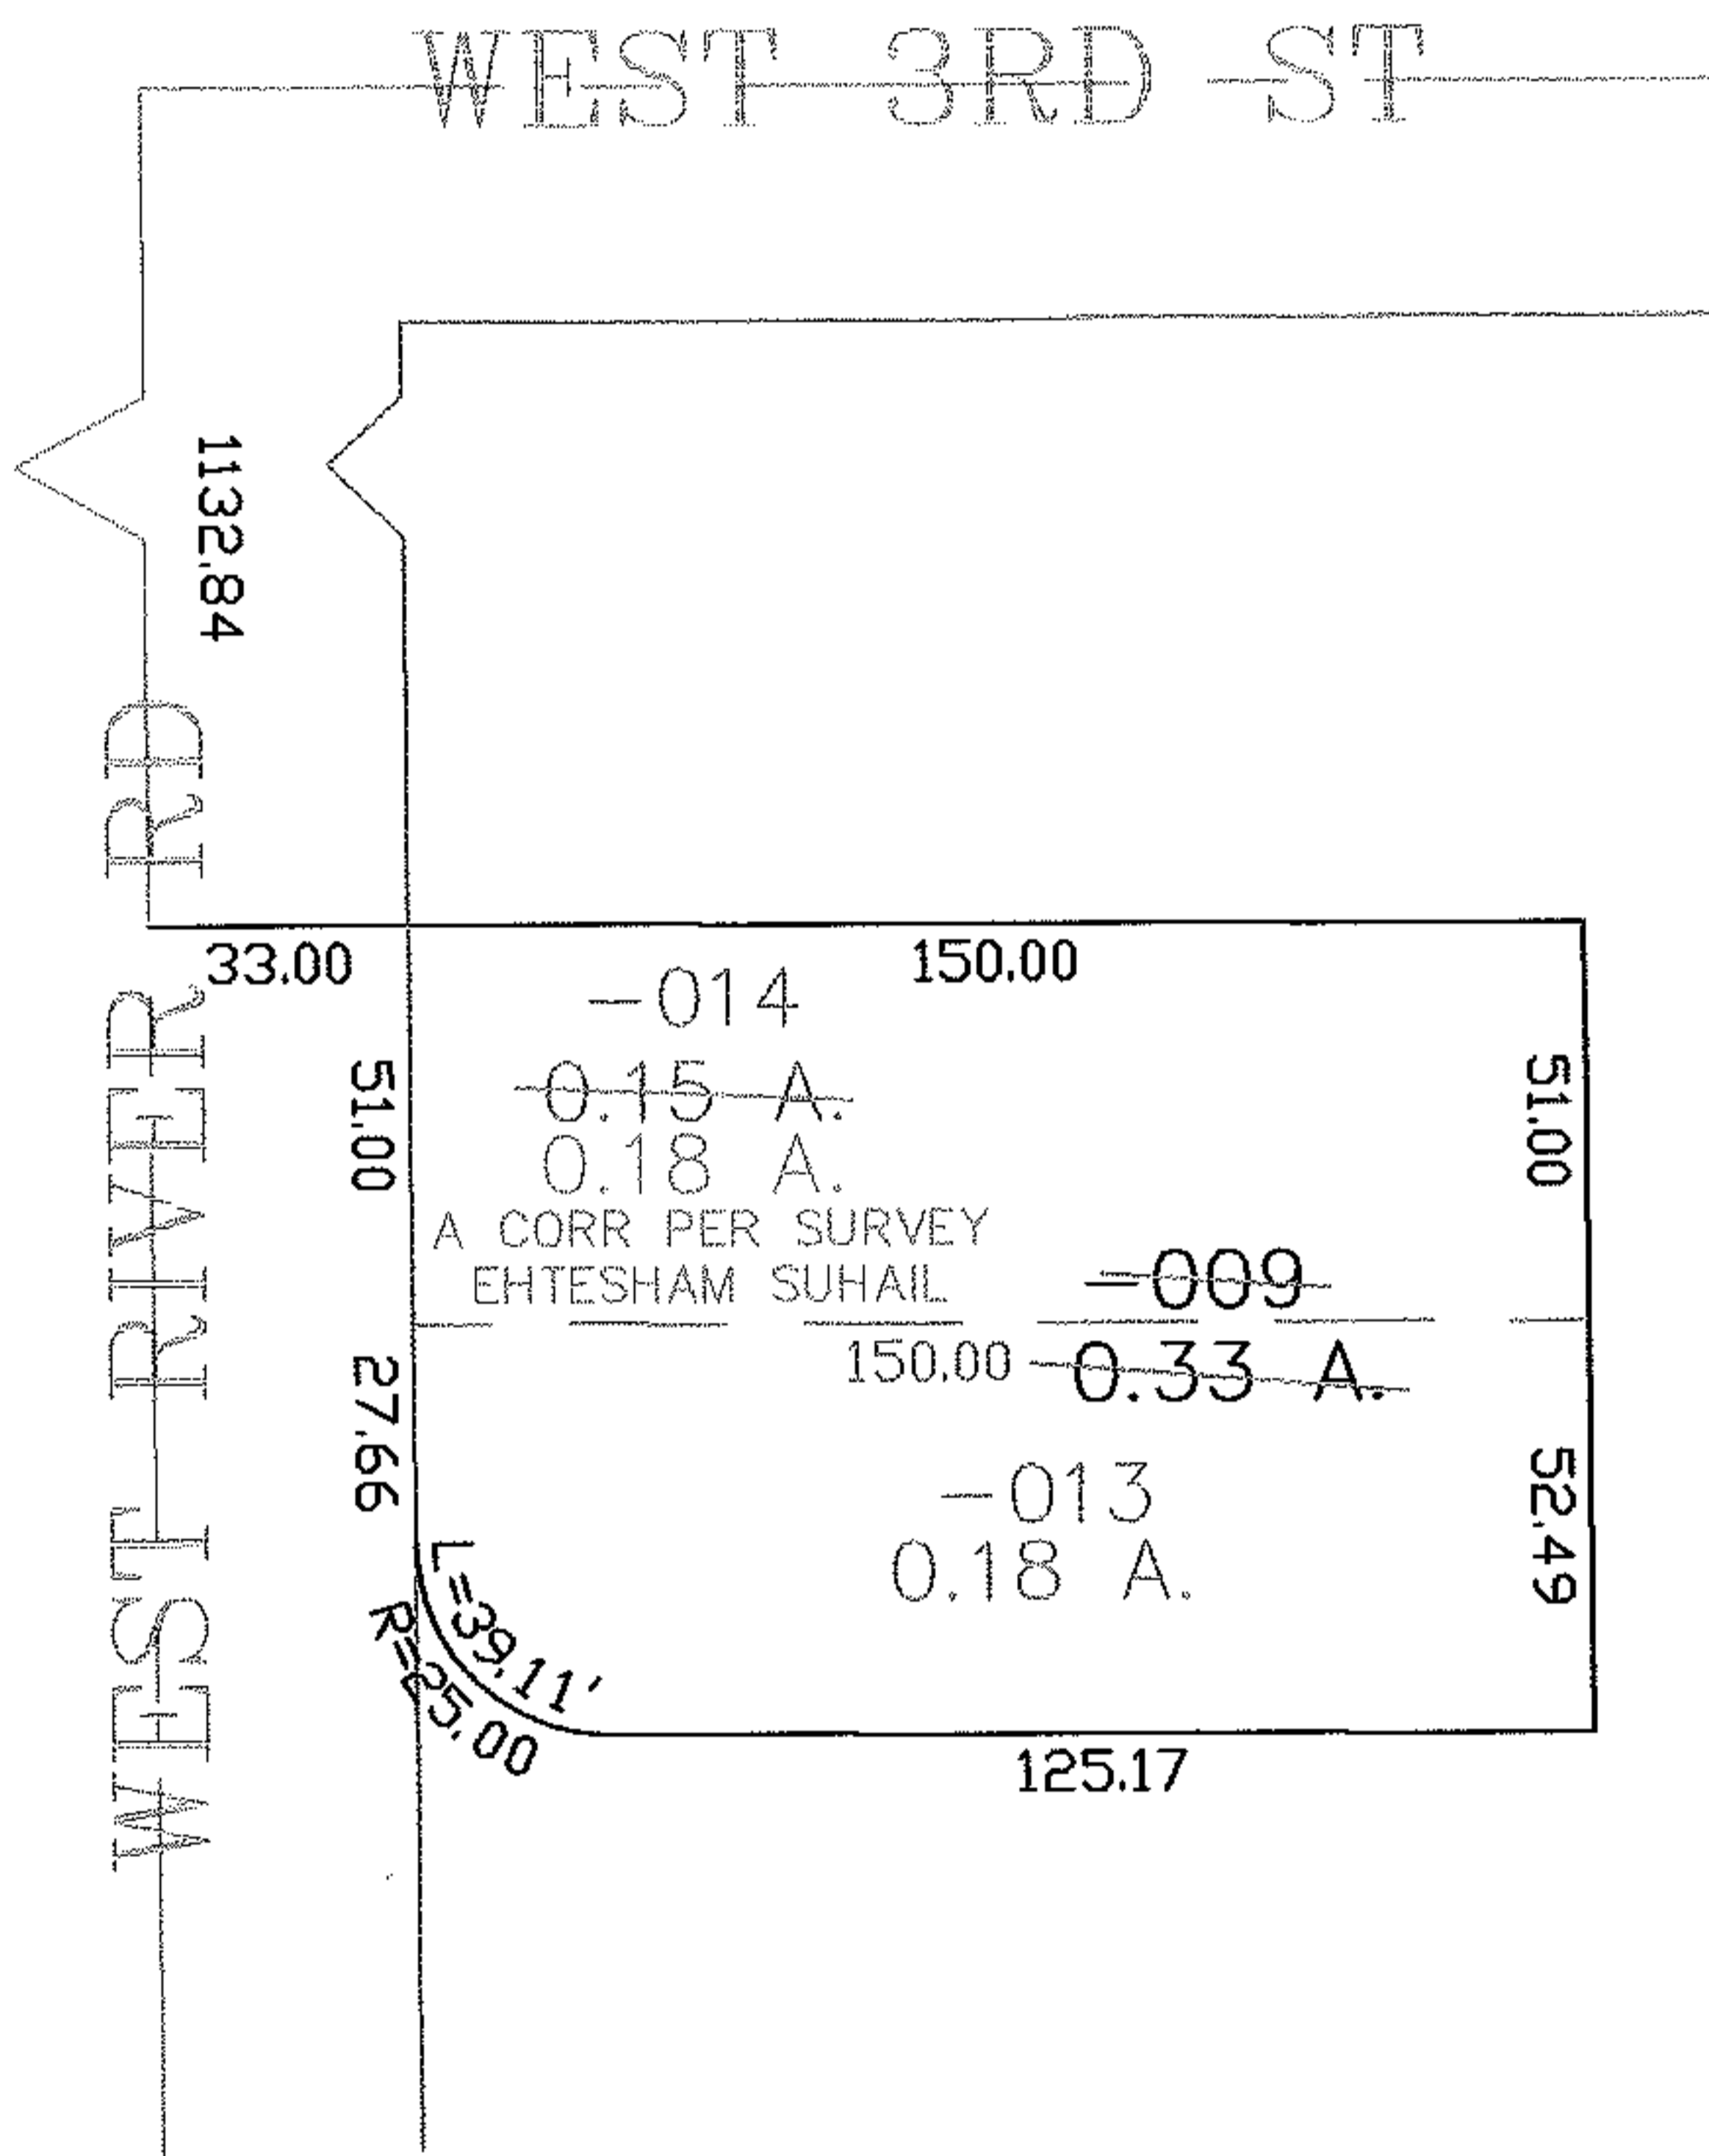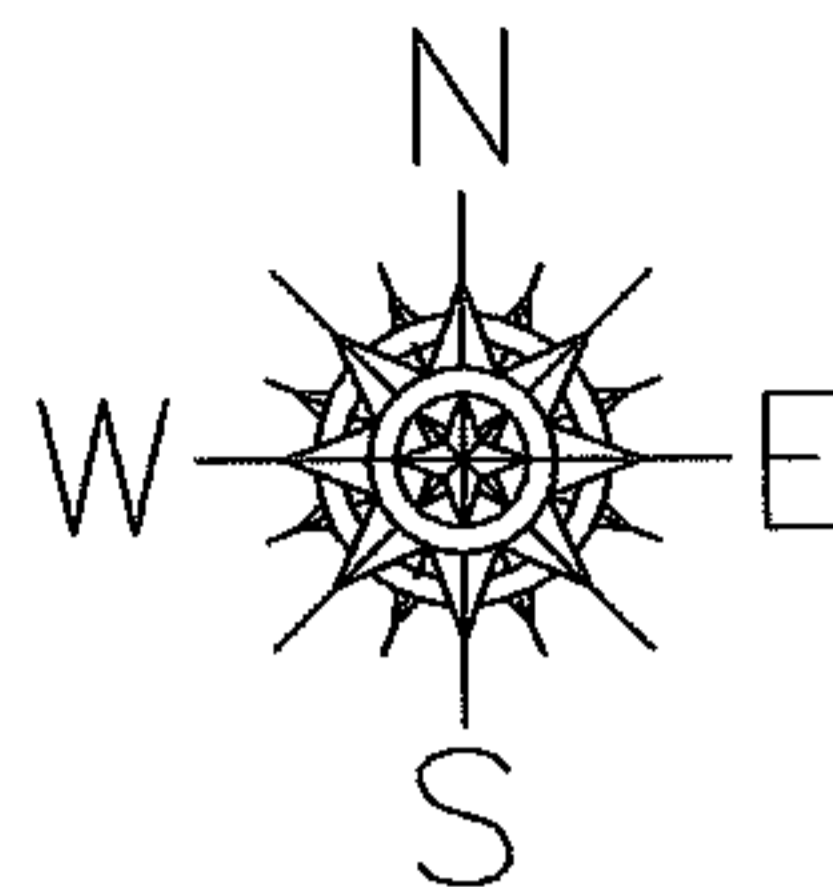

SPLITS/DEEDS PROCESSED

LORAIN COUNTY TAX MAP DEPARTMENT  
226 MIDDLE AVE. ELYRIA, OHIO

SURVEYED BY: EHTESHAM SUHAIL

CLOSURE: 0.00 : 10,000

MAP PAGE(S): 6-118

APPROVED BY: JAH DATE: 1-31-06

SCALE: 1" = 100' PRIOR INSTRUMENT: 20040036672