
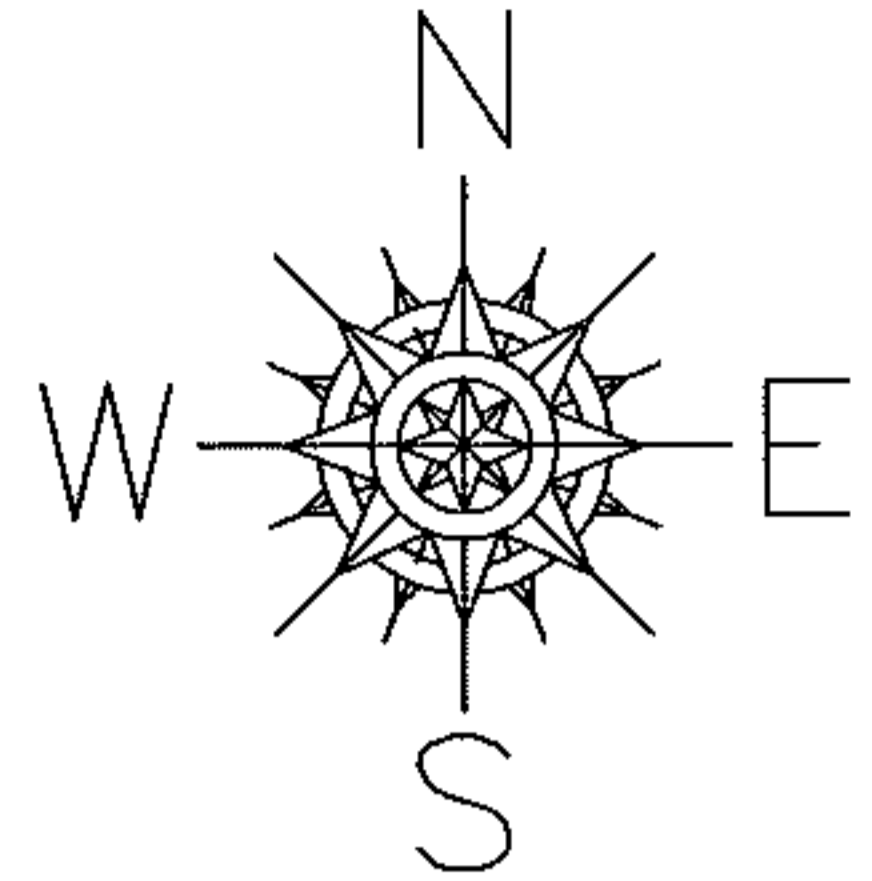


PARENT PARCEL: 04-00-006-101-068, -070

CHILD PARCEL: XX-XX-XXX-XXX-XXX

STARTING POINT: CL OF LAKE RD. & CL OF MOORE RD.

10-02092-C

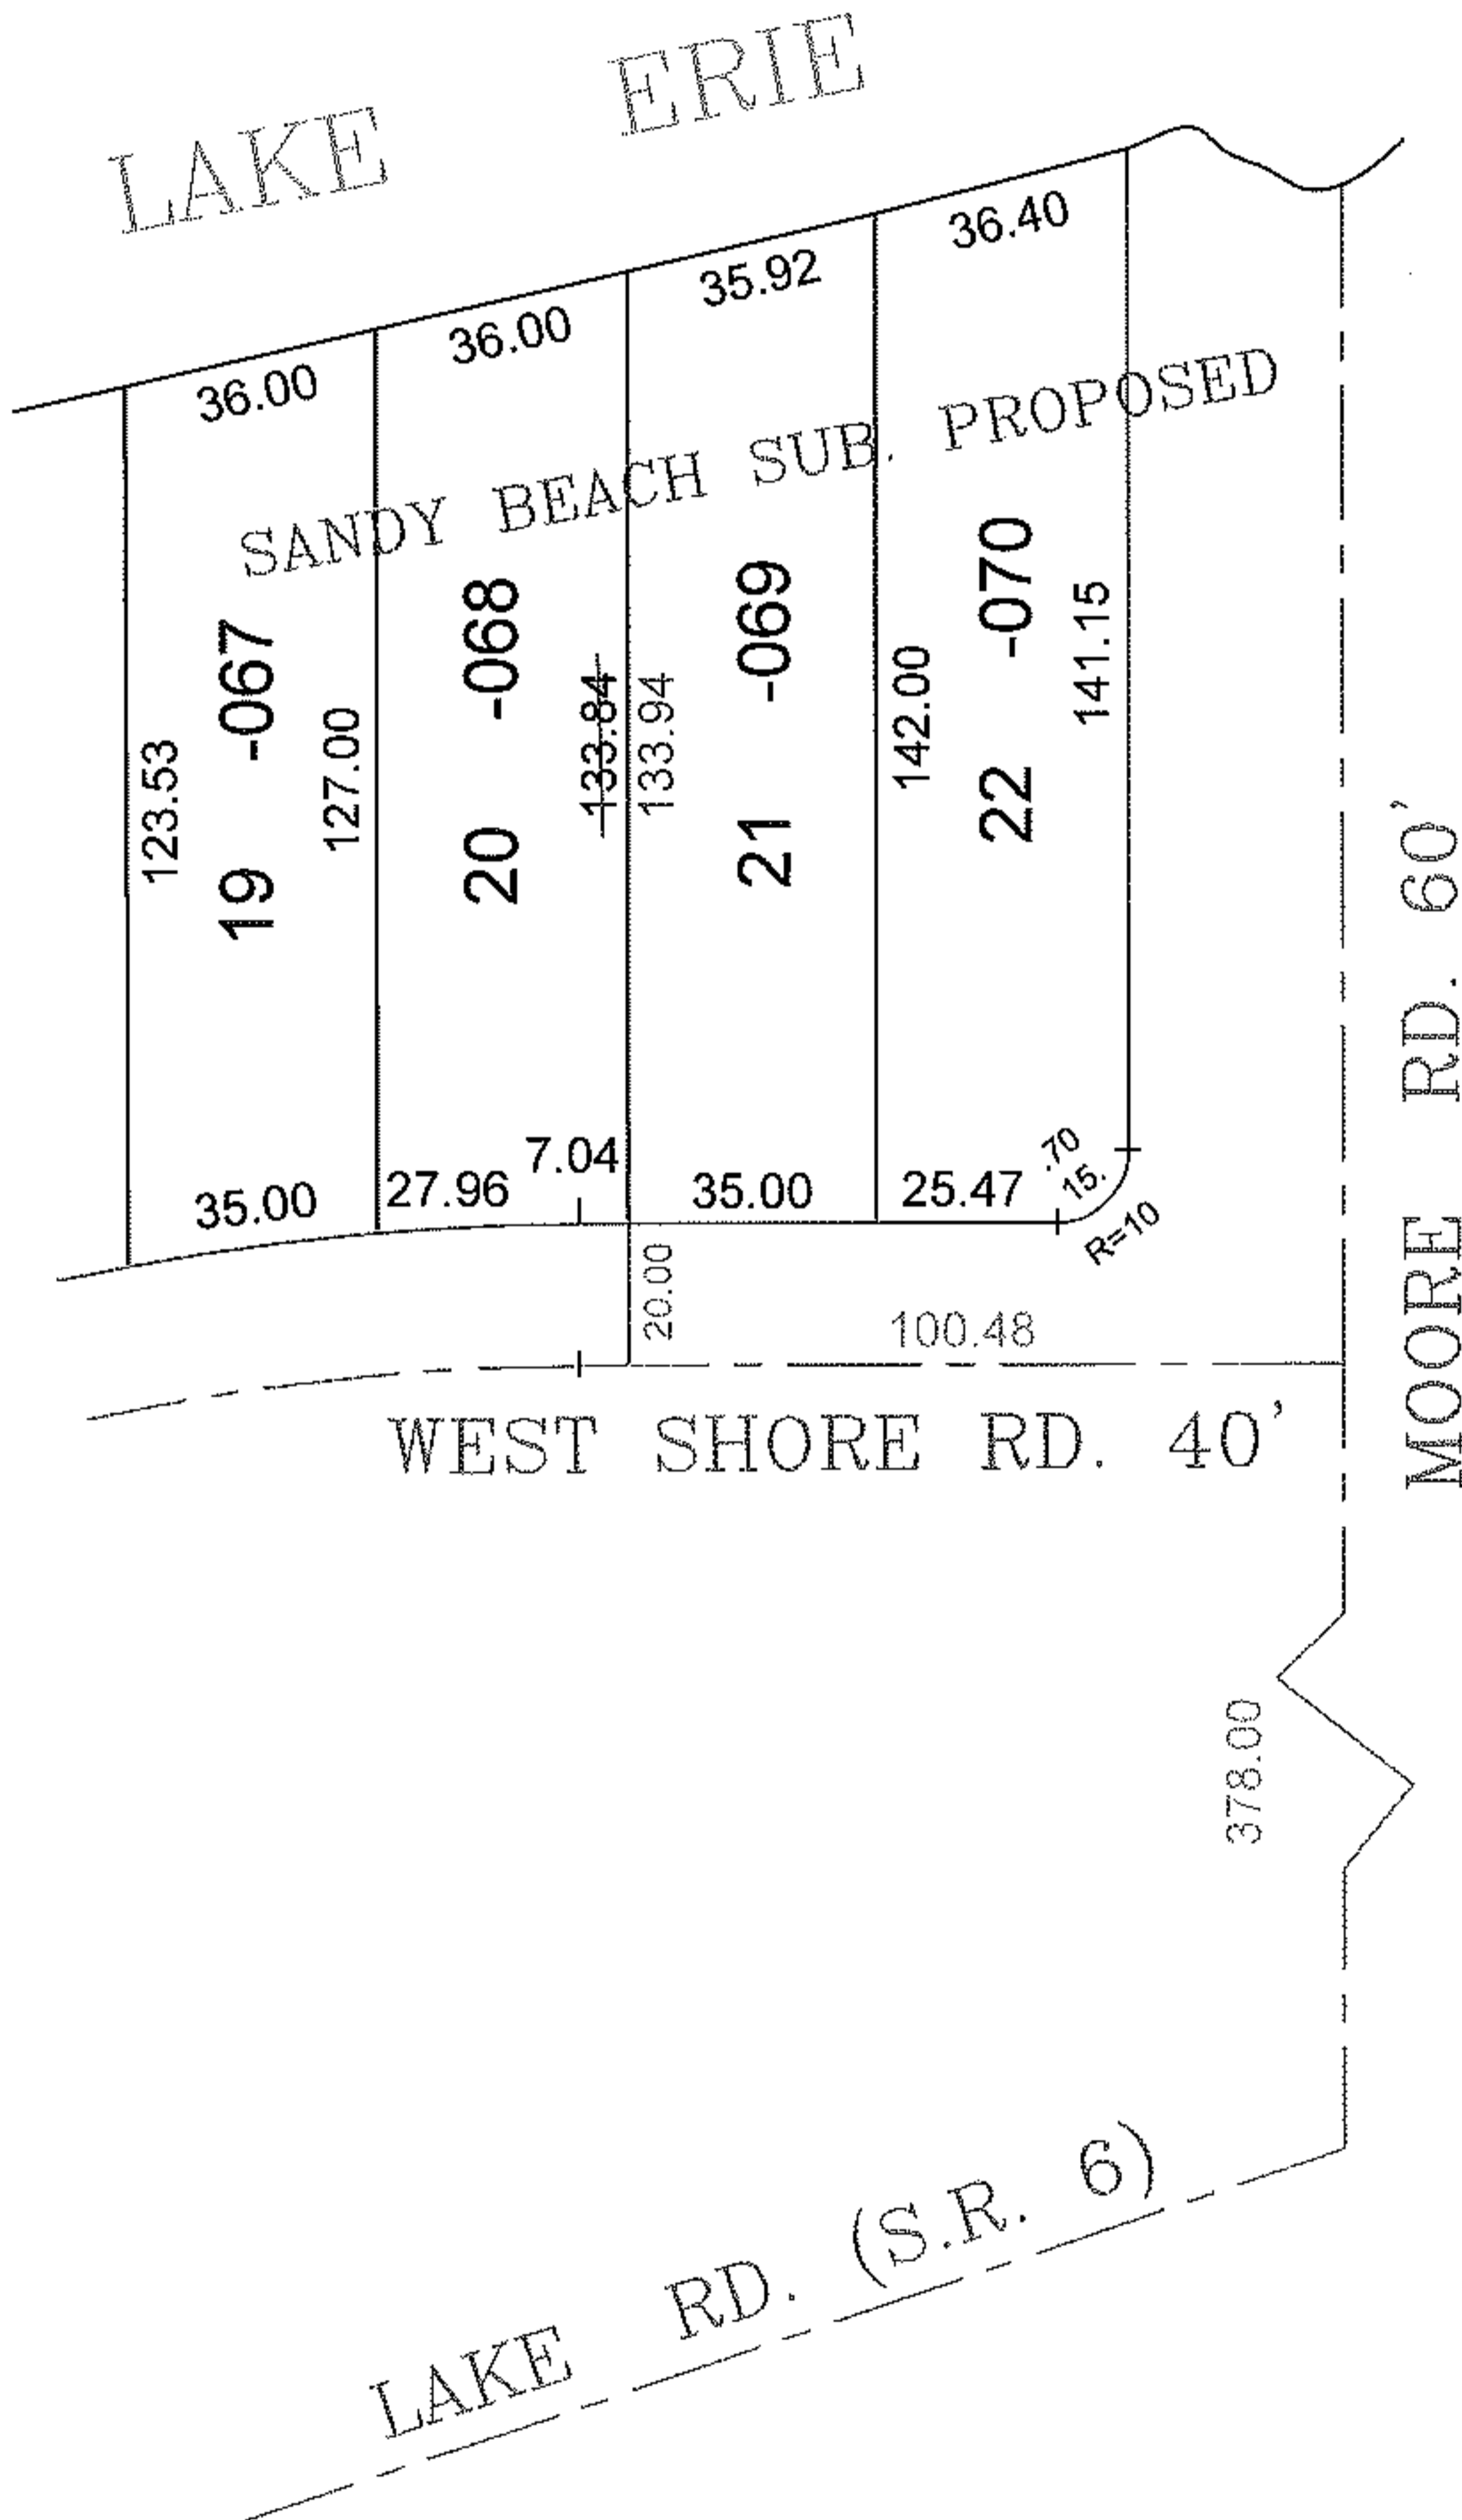

MAP  
FRONTAGE & DEPTH CORR.

04-00-006-101-068  
~~35 X 134~~  
35 X 133.94

04-00-006-101-070  
~~36.40 X 172~~  
35.47 X 142.00

CORR. PER SURV.  
HOLLAND ENGINEERING, 1919

SPLITS/DEEDS PROCESSED

LORAIN COUNTY TAX MAP DEPARTMENT  
226 MIDDLE AVE. ELYRIA, OHIO

SURVEYED BY: HOLLAND ENGINEERING, 1919  
CLOSURE: 1 : 46,000  
MAP PAGE(S): 4-00-006-D  
APPROVED BY: TJS DATE: 9/15/10  
SCALE: 1" = 50' PRIOR INST.: DV 1302/836