




RASTER

PARENT PARCEL: 06-24-035-101-047  
CHILD PARCEL: XX-XX-XXX-XXX-XXX  
STARTING POINT: XXXXXX

10-02094-C

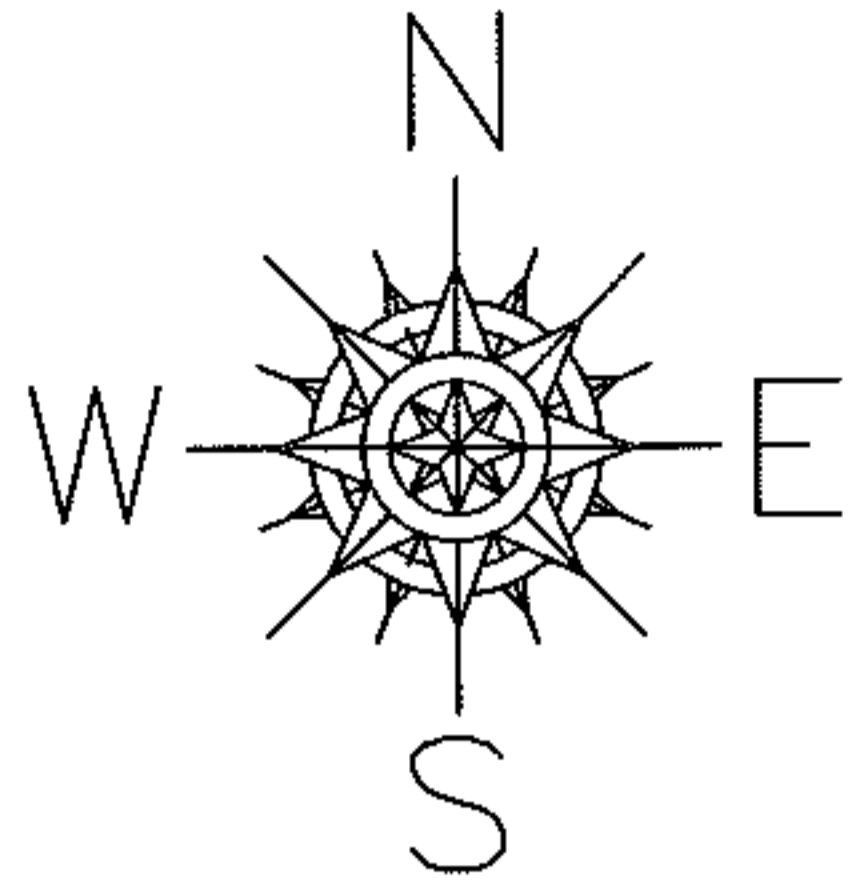

MAP CORRECTION ONLY

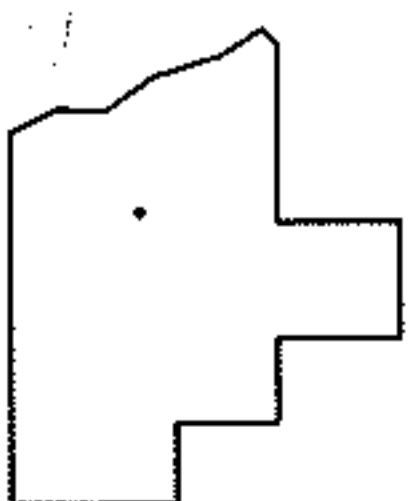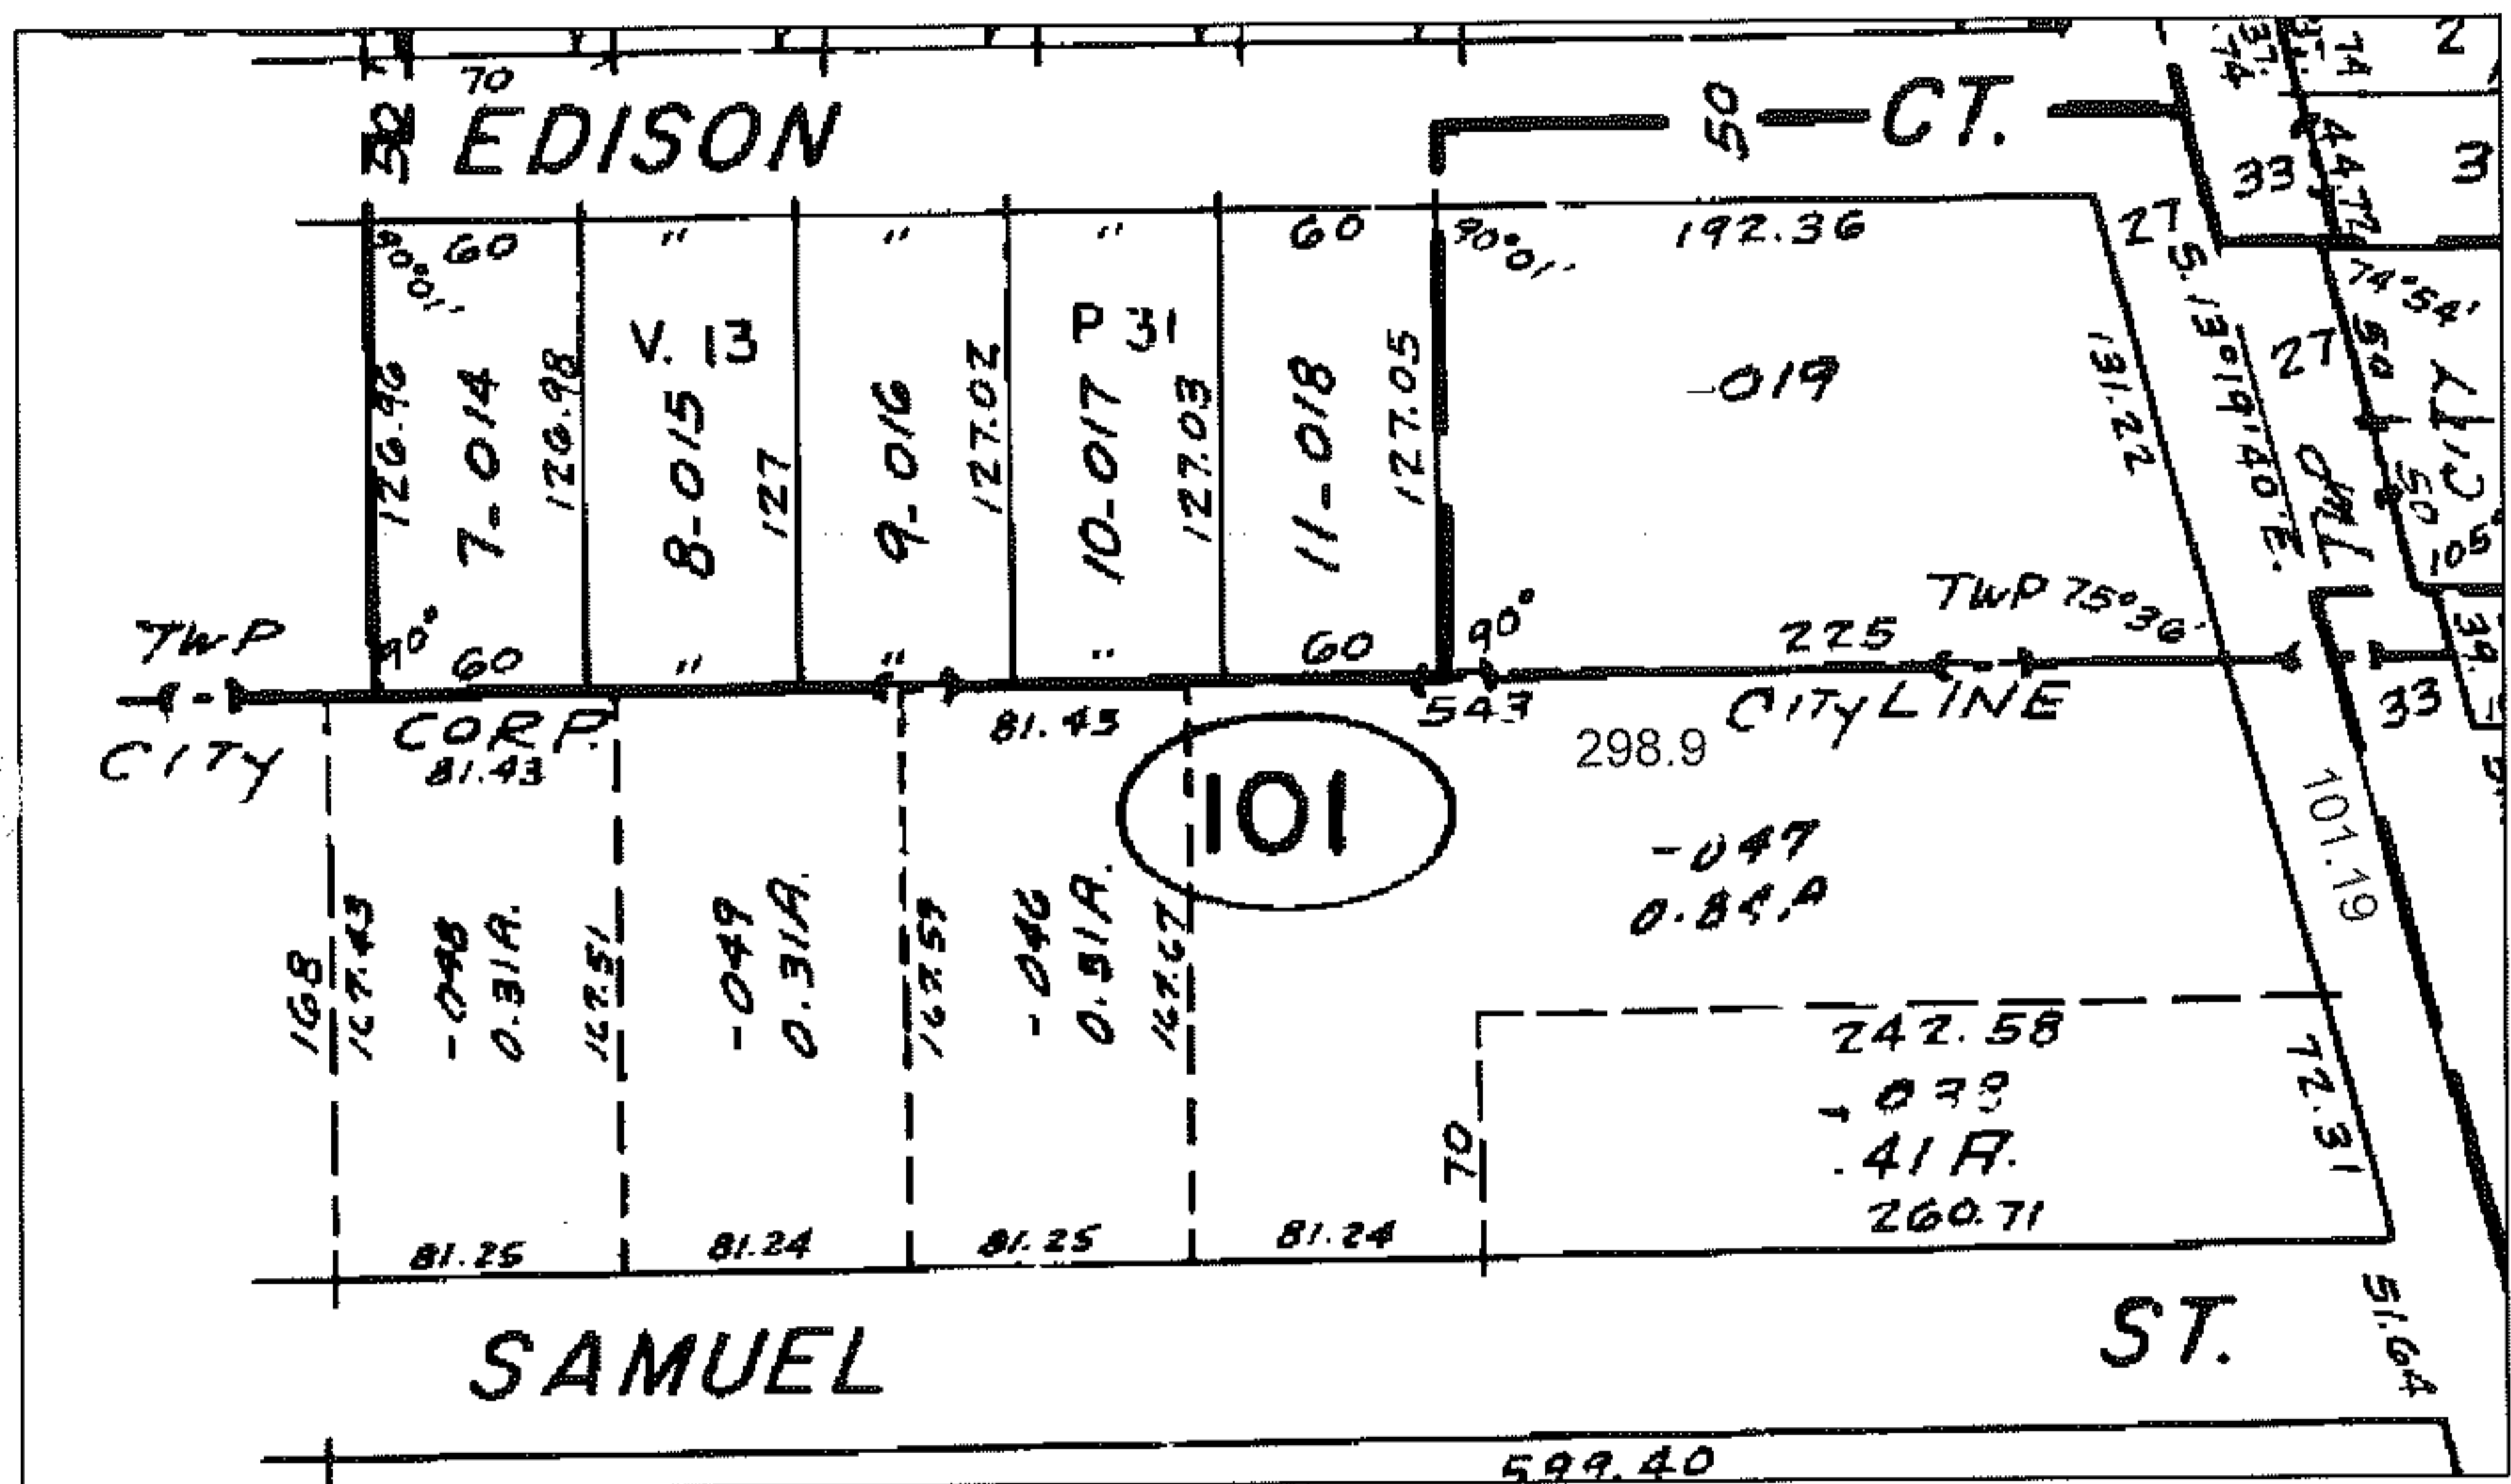

SPLITS/DEEDS PROCESSED  
LORAIN COUNTY TAX MAP DEPARTMENT  
226 MIDDLE AVE. ELYRIA, OHIO

SURVEYED BY: XXXXXXXXXXXX  
CLOSURE: NA  
MAP PAGE(S): 6-61  
APPROVED BY: TJS DATE: 9/20/10  
SCALE: 1"=100 PRIOR INST.: 20080265746