




RASTER

PARENT PARCEL: 18-00-029-000-034

CHILD PARCEL: 18-00-029-000-059, -060

STARTING POINT: CENTERLINE OF PECK WADSWORTH RD & ASHLAND - OBERLIN RD

06-02094

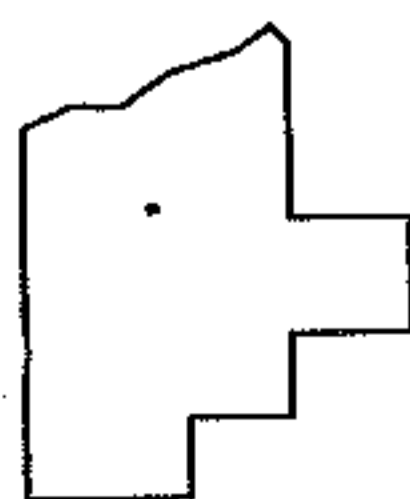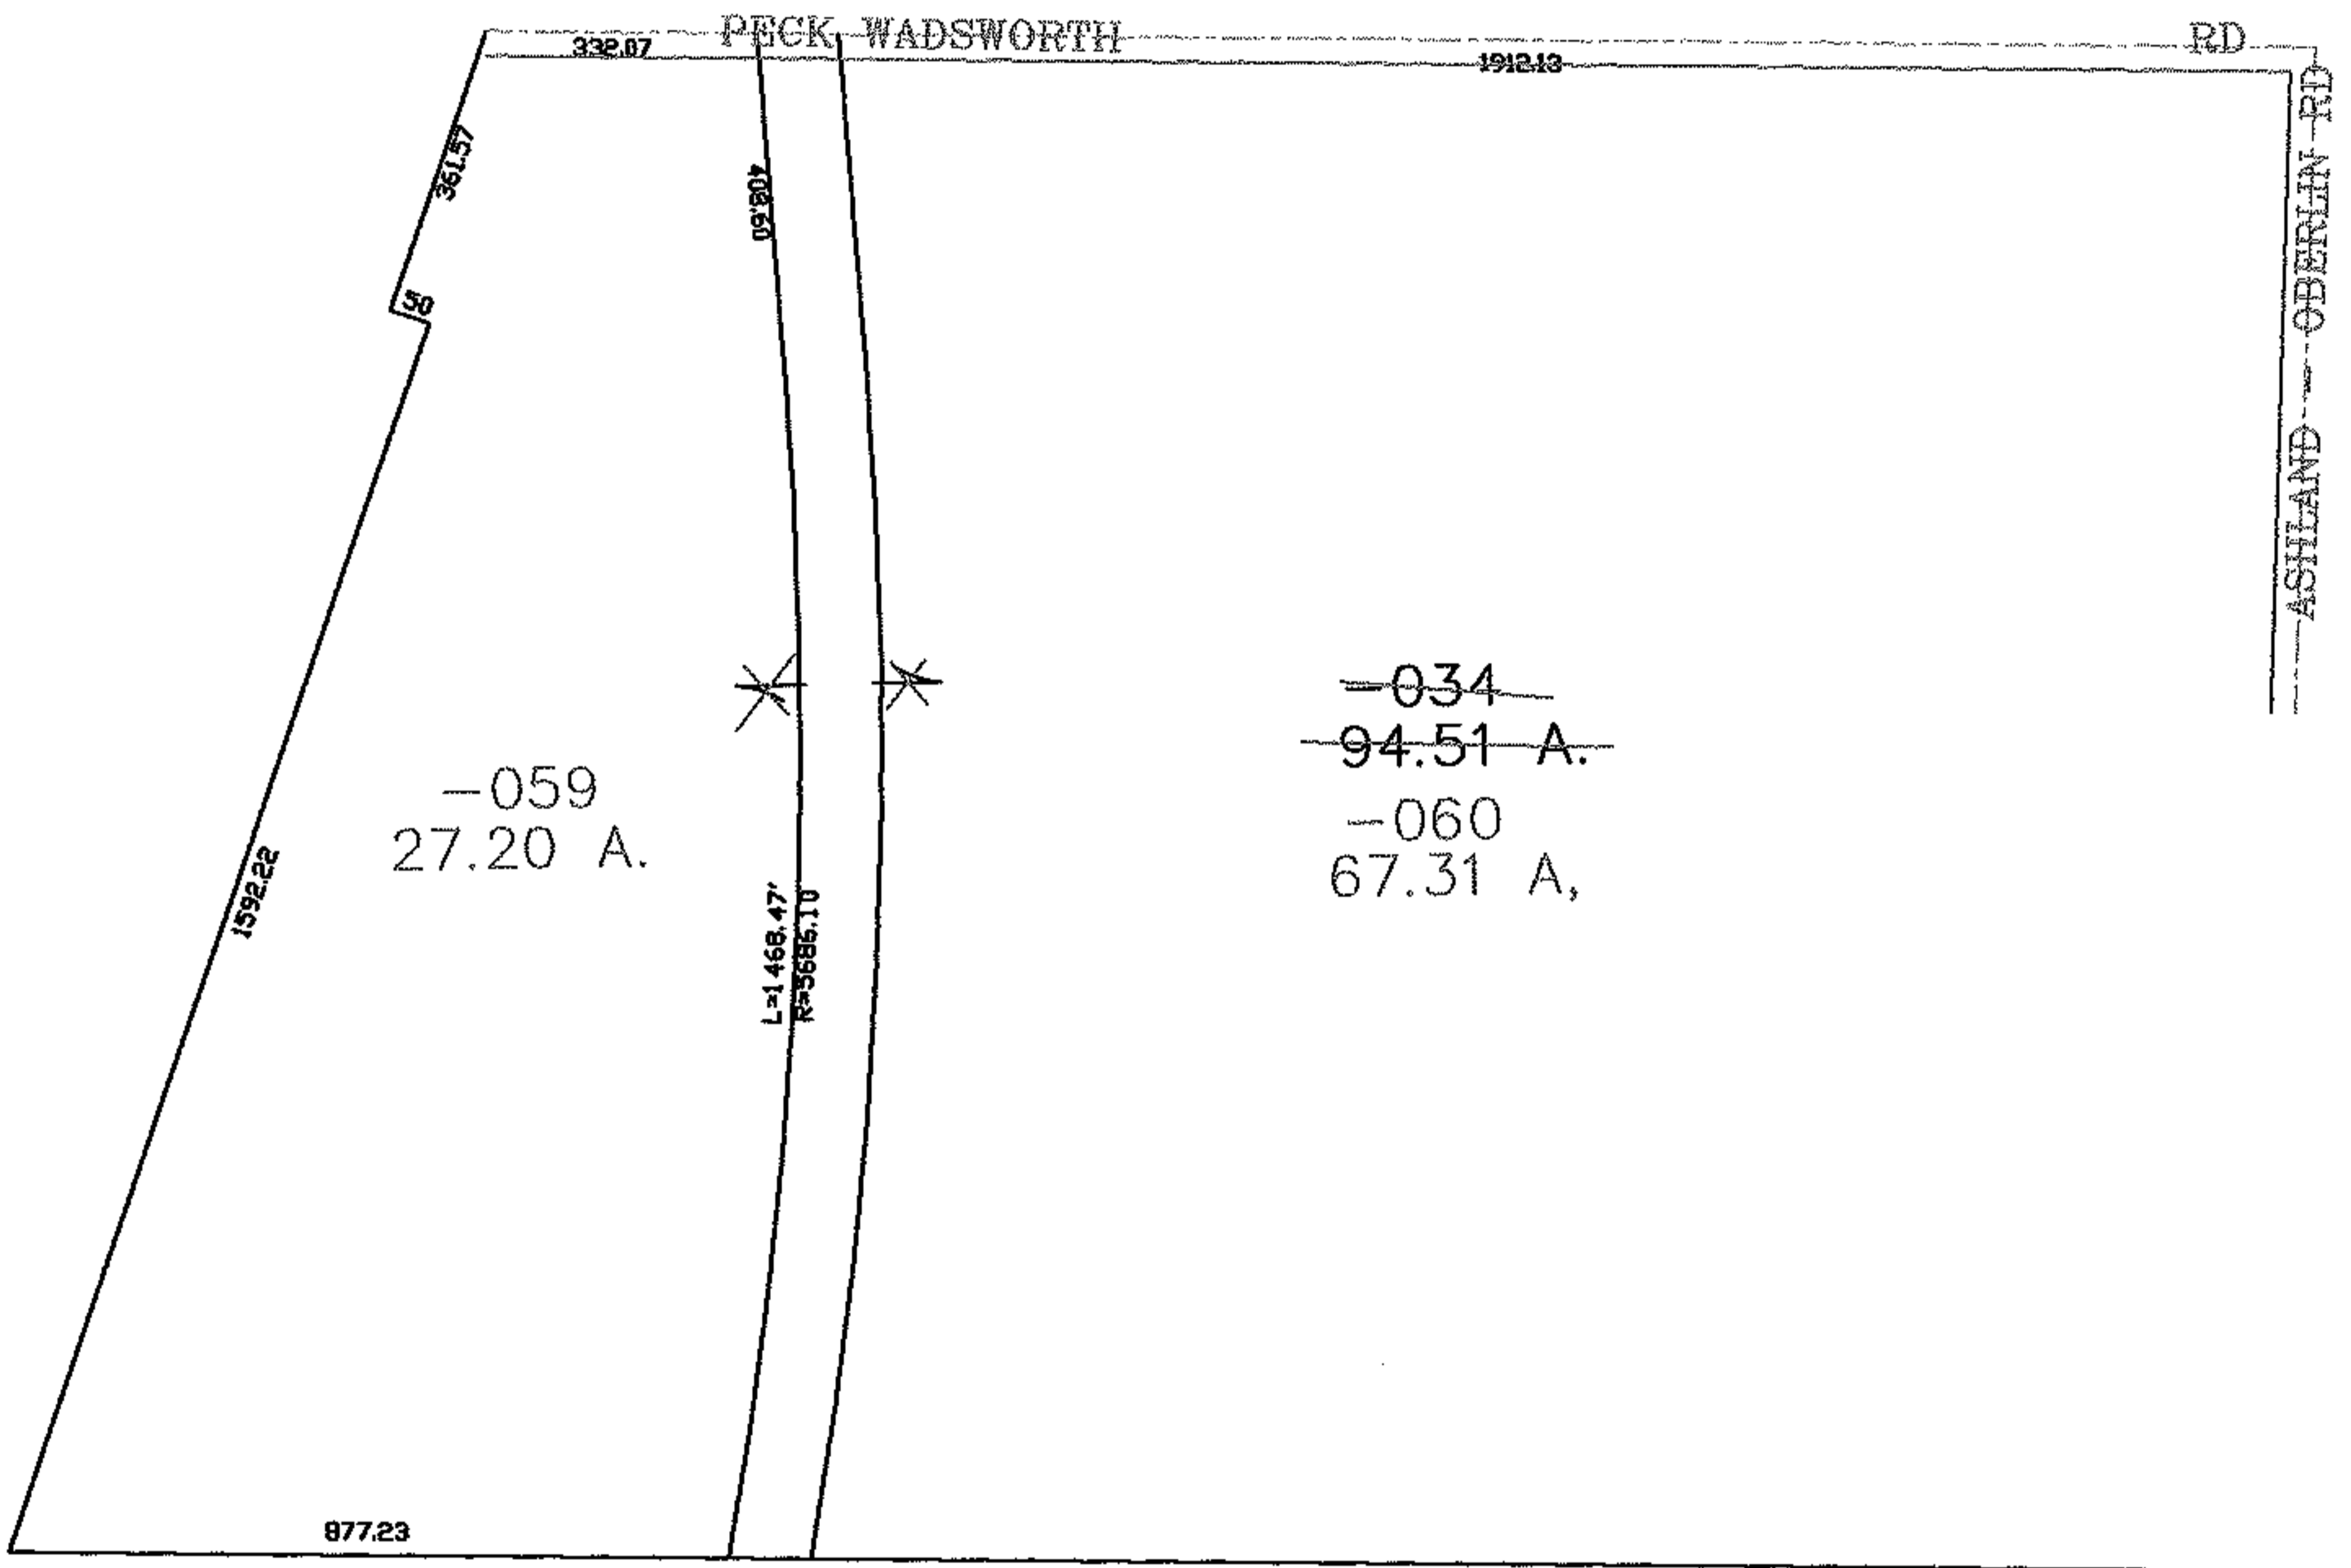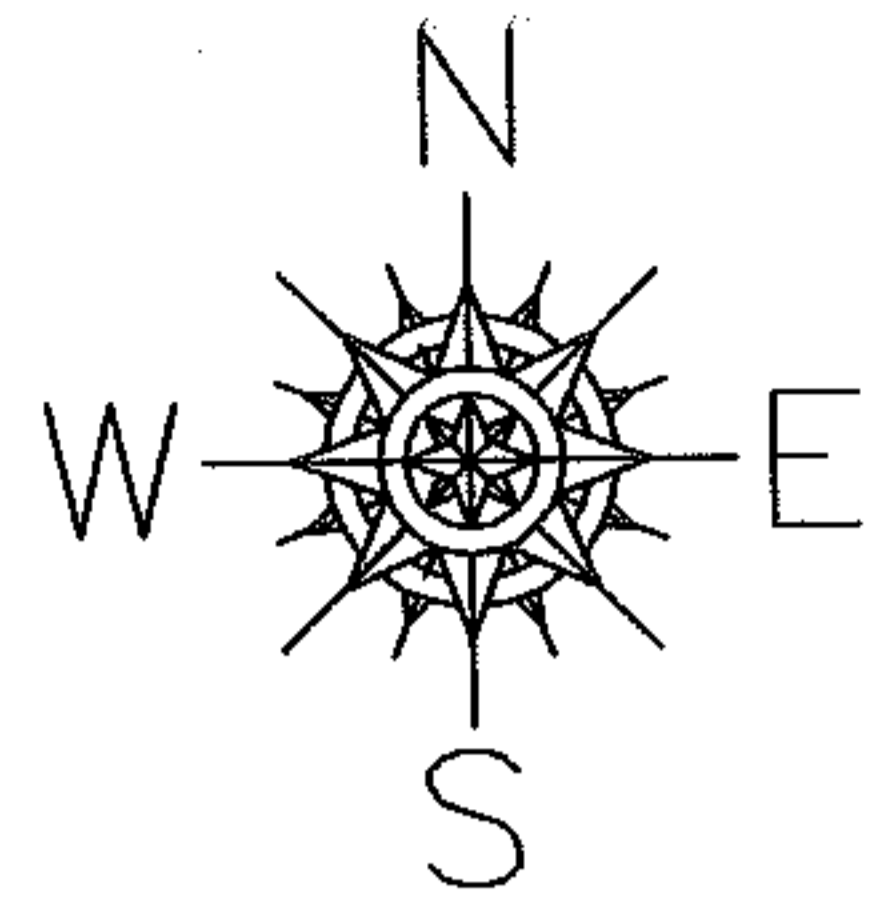

SPLITS/DEEDS PROCESSED
 LORAIN COUNTY TAX MAP DEPARTMENT
 226 MIDDLE AVE. ELYRIA, OHIO

SURVEYED BY: THOMAS SIMON
 CLOSURE: 0.00 : 10,000
 MAP PAGE(S): 18-B
 APPROVED BY: JAH DATE: 2-6-06
 SCALE: 1" = 400 PRIOR INSTRUMENT: 20050083860