
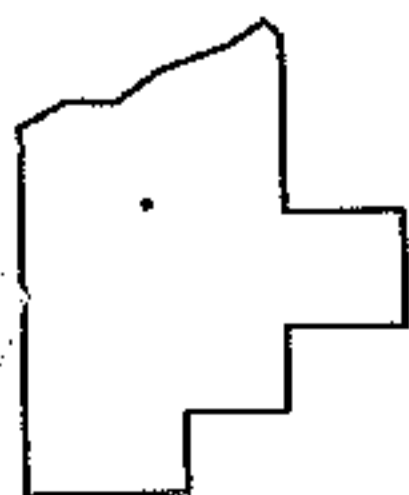
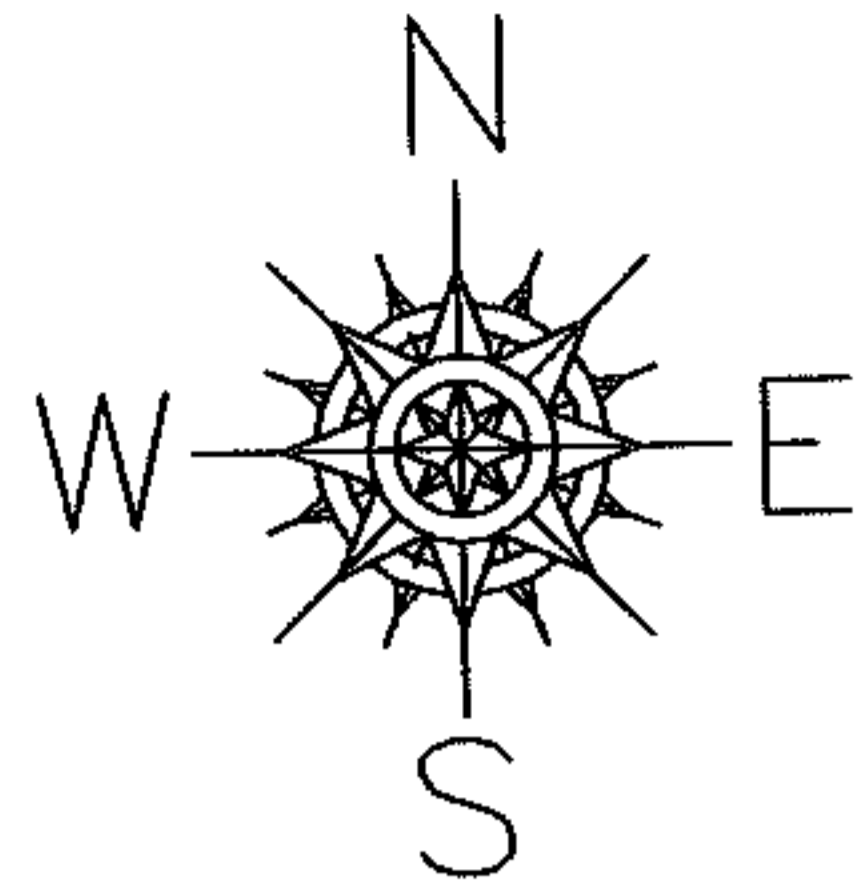


PARENT PARCEL: 04-00-027-101-174, -039

CHILD PARCEL: 04-00-027-101-175 THRU -177

STARTING POINT: CENTERLINE OF PINE COURT & WALNUTDR

06-02098

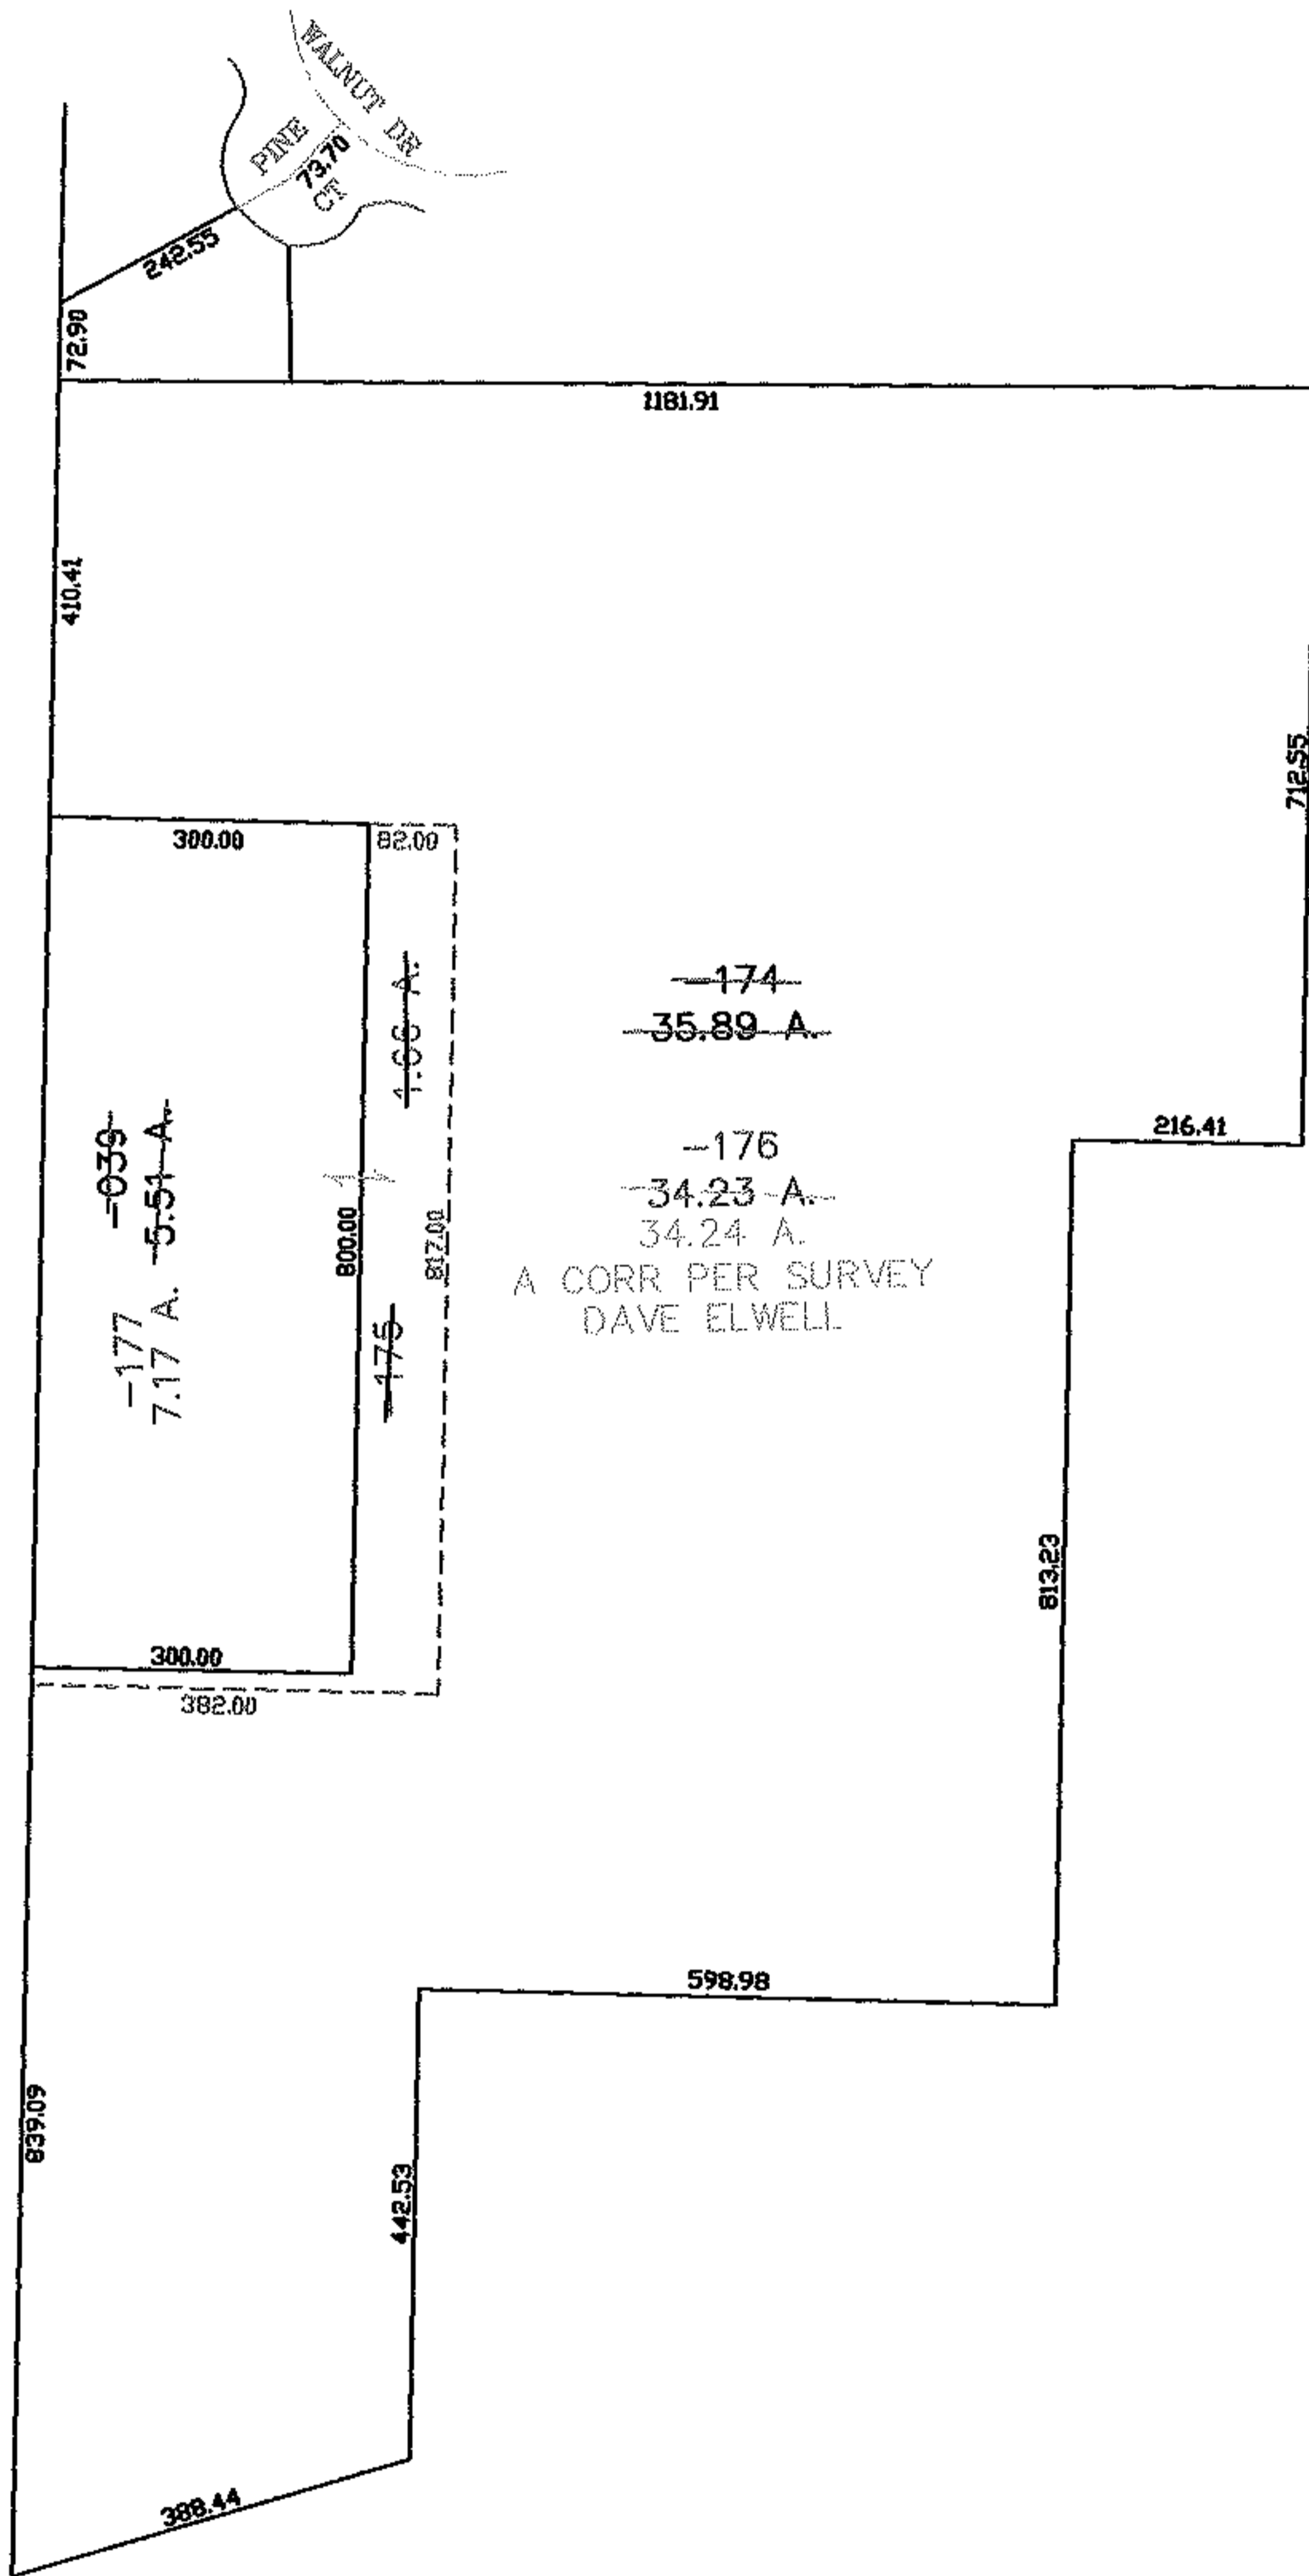

SPLITS/DEEDS PROCESSED
LORAIN COUNTY TAX MAP DEPARTMENT
 226 MIDDLE AVE. ELYRIA, OHIO

SURVEYED BY: DAVE ELWELL
 CLOSURE: 0.00 : 10.000
 MAP PAGE(S): 04-00-027-B
 APPROVED BY: JAH DATE: 2-14-06
 SCALE: 1" = 300 PRIOR INSTRUMENT: OR 1403/826