


PARENT PARCEL: 18-00-021-112-050, -062, -063, -066, -072, -074, -076, -089, -103  
CHILD PARCEL: XX-XX-XXX-XXX-XXX  
STARTING POINT: XXXXXX

10-02100-C

UPDATE LEGAL

18-00-021-112-062  
18-00-021-112-063  
18-00-021-112-074  
18-00-021-112-103  
18-00-021-112-089

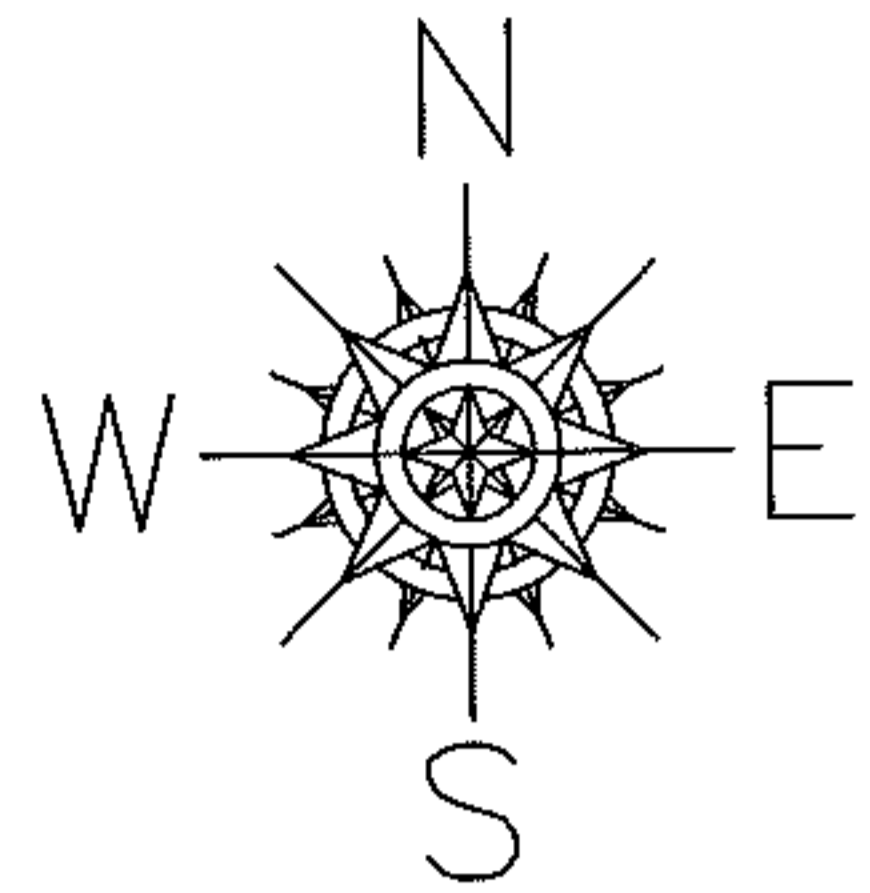

SURVEY BEFORE NEXT TRANSFER,

ORIGINAL D.D. ANDRUS SURVEY INCORRECT  
MAKES CALL FOR SOUTH LINE OF CHURCH,

SOUTH LINE IS 165' SOUTH OF THE N.W. CORNER OF S/L 24  
S/L WAS DRAWN WRONG ON OLD MAP AND BAD SURVEY FOLLOWED  
INCORRECT SUBLOT DRAWING  
SEE DV 746/160

UPDATE LEGAL

18-00-021-112-076  
REVERT LEGAL BACK TO  
PRIOR, DV. 842/434

UPDATE LEGAL

18-00-021-112-066  
REVERT LEGAL BACK TO  
PRIOR, DV. 317/99-100

UPDATE LEGAL

18-00-021-112-050  
SHOULD BE PART OF S/L 25 ALSO

UPDATE LEGAL

18-00-021-112-072  
SURVEY BEFOR NEXT TRANSFER  
PRIORS NEVER HAD DIMENSIONS  
NEW DEED DOES  
CALLS FOR 62.25' DEED, CALC. 59.75'

PG. 2 OF 2

SPLITS/DEEDS PROCESSED

LORAIN COUNTY TAX MAP DEPARTMENT  
226 MIDDLE AVE. ELYRIA, OHIO

SURVEYED BY: NONE  
CLOSURE: NONE  
MAP PAGE(S): 18-00-021-D  
APPROVED BY: TJS DATE: 9/27/10  
SCALE: 1"= 200' PRIOR INSTRUMENT: DV XXXX/XXX