
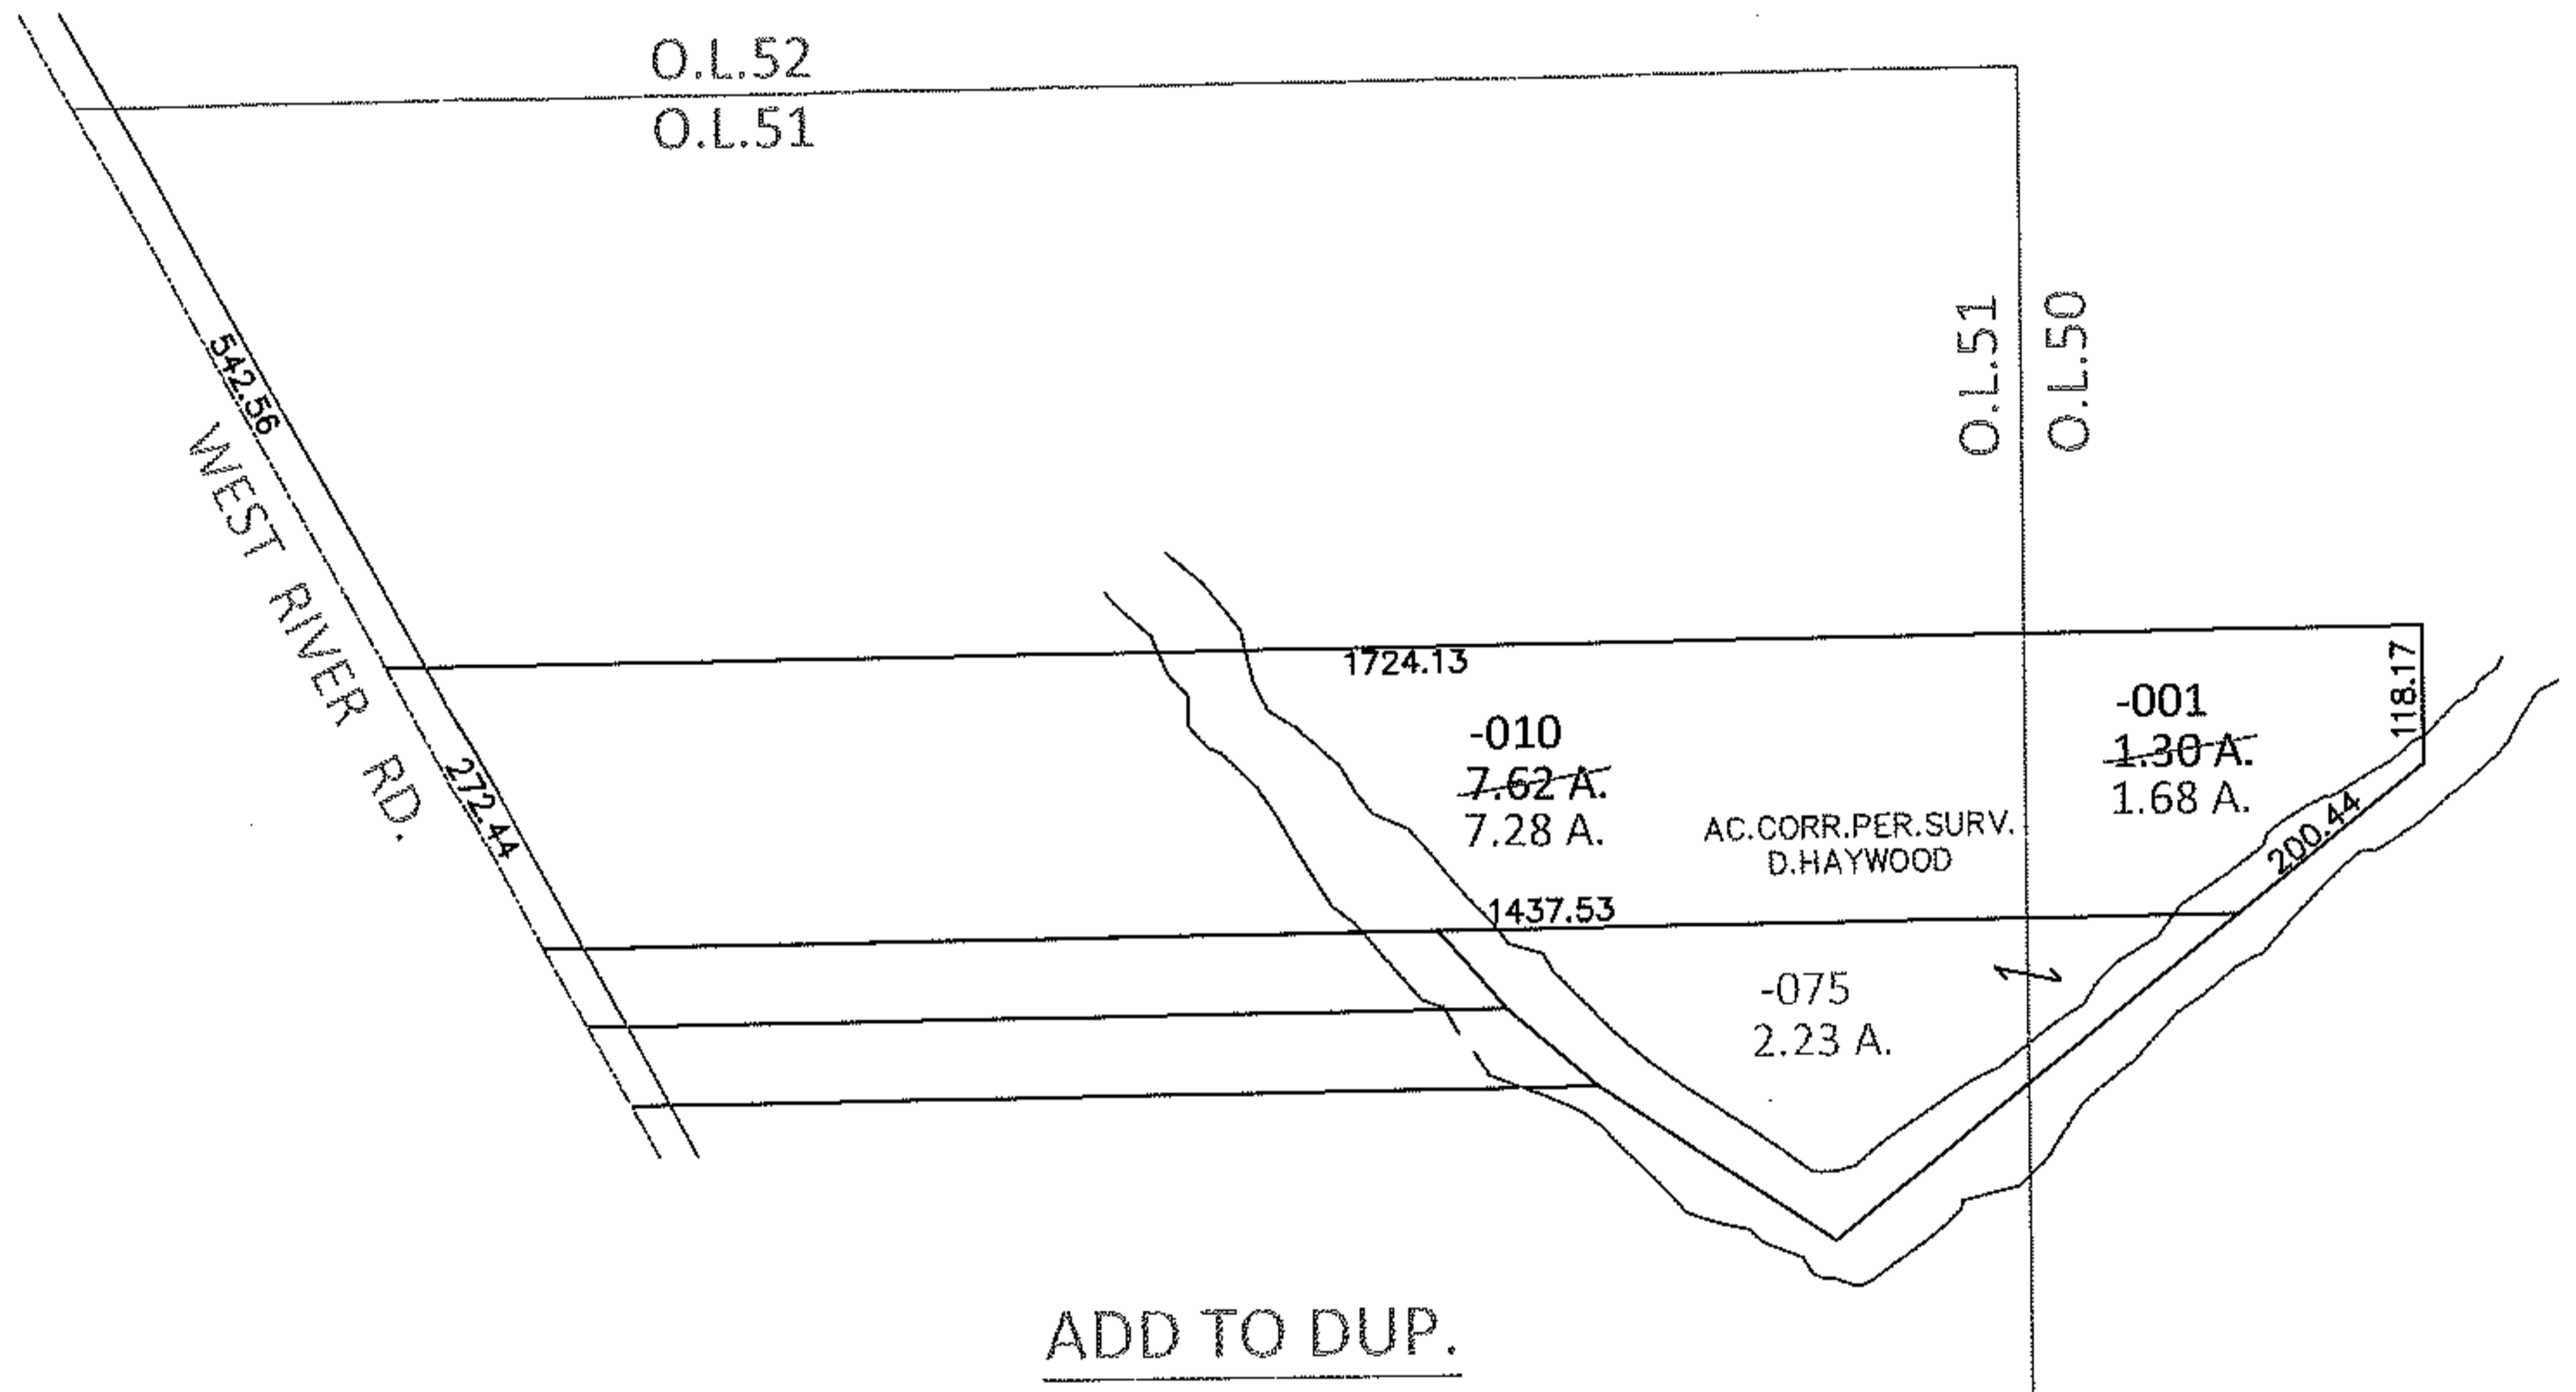


PARENT PARCEL: 12-00-051-000-010, 12-00-050-000-001

CHILD PARCEL: 12-00-051-000-075

10-02103-C

STARTING POINT: INTERSECTION OF C/L OF WEST RIVER RD. AND NORTH LINE OF O.L.51

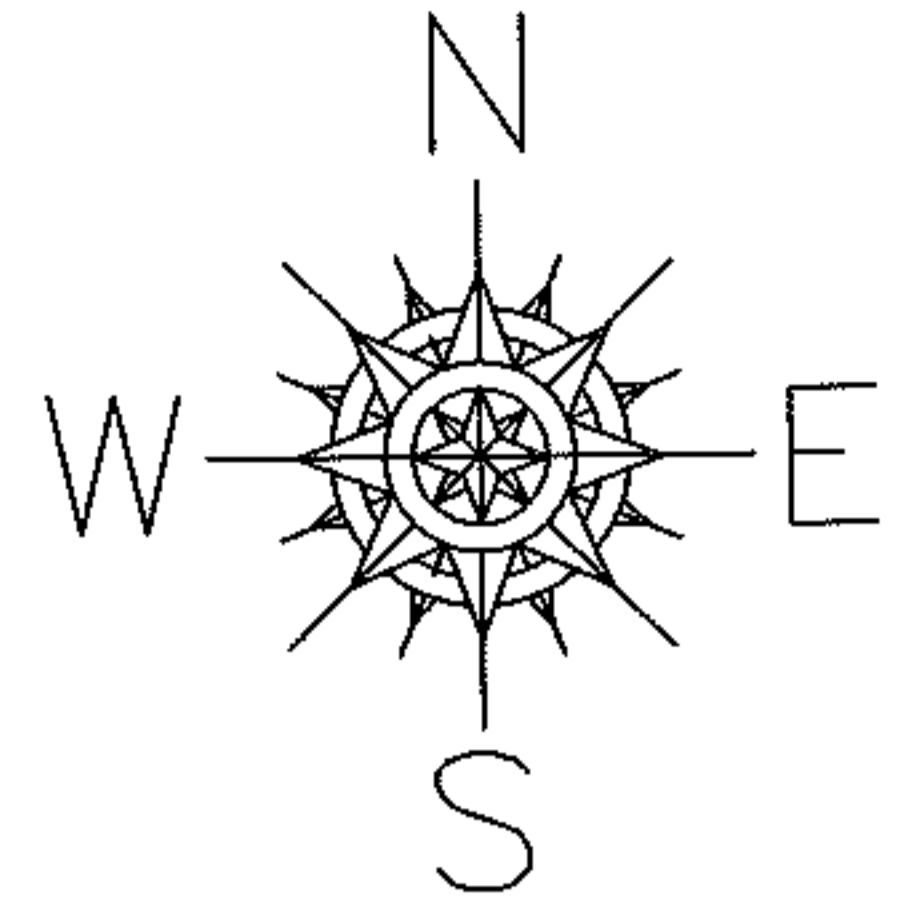


ADD TO DUP.

12-00-051-000-075

2.23 A.

PER. DV 317/16-18

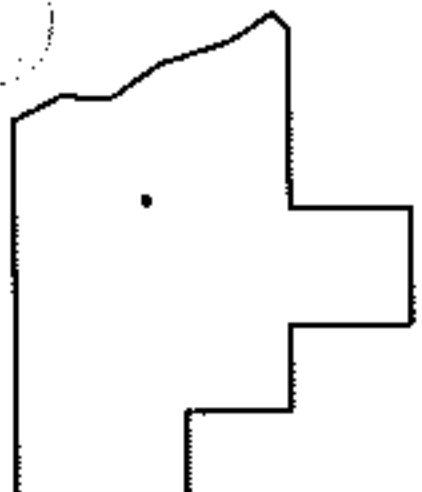

SPLITS/DEEDS PROCESSED

LORAIN COUNTY TAX MAP DEPARTMENT  
226 MIDDLE AVE. ELYRIA, OHIO

SURVEYED BY: DALE R. HAYWOOD

CLOSURE: .01:10,000

MAP PAGE(S): 12-F, 12-G

APPROVED BY: RRM DATE: 9-29-10

SCALE: 1"= 300 PRIOR INST.: 20090320713