
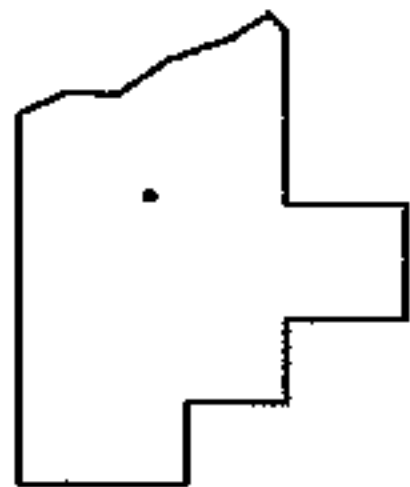
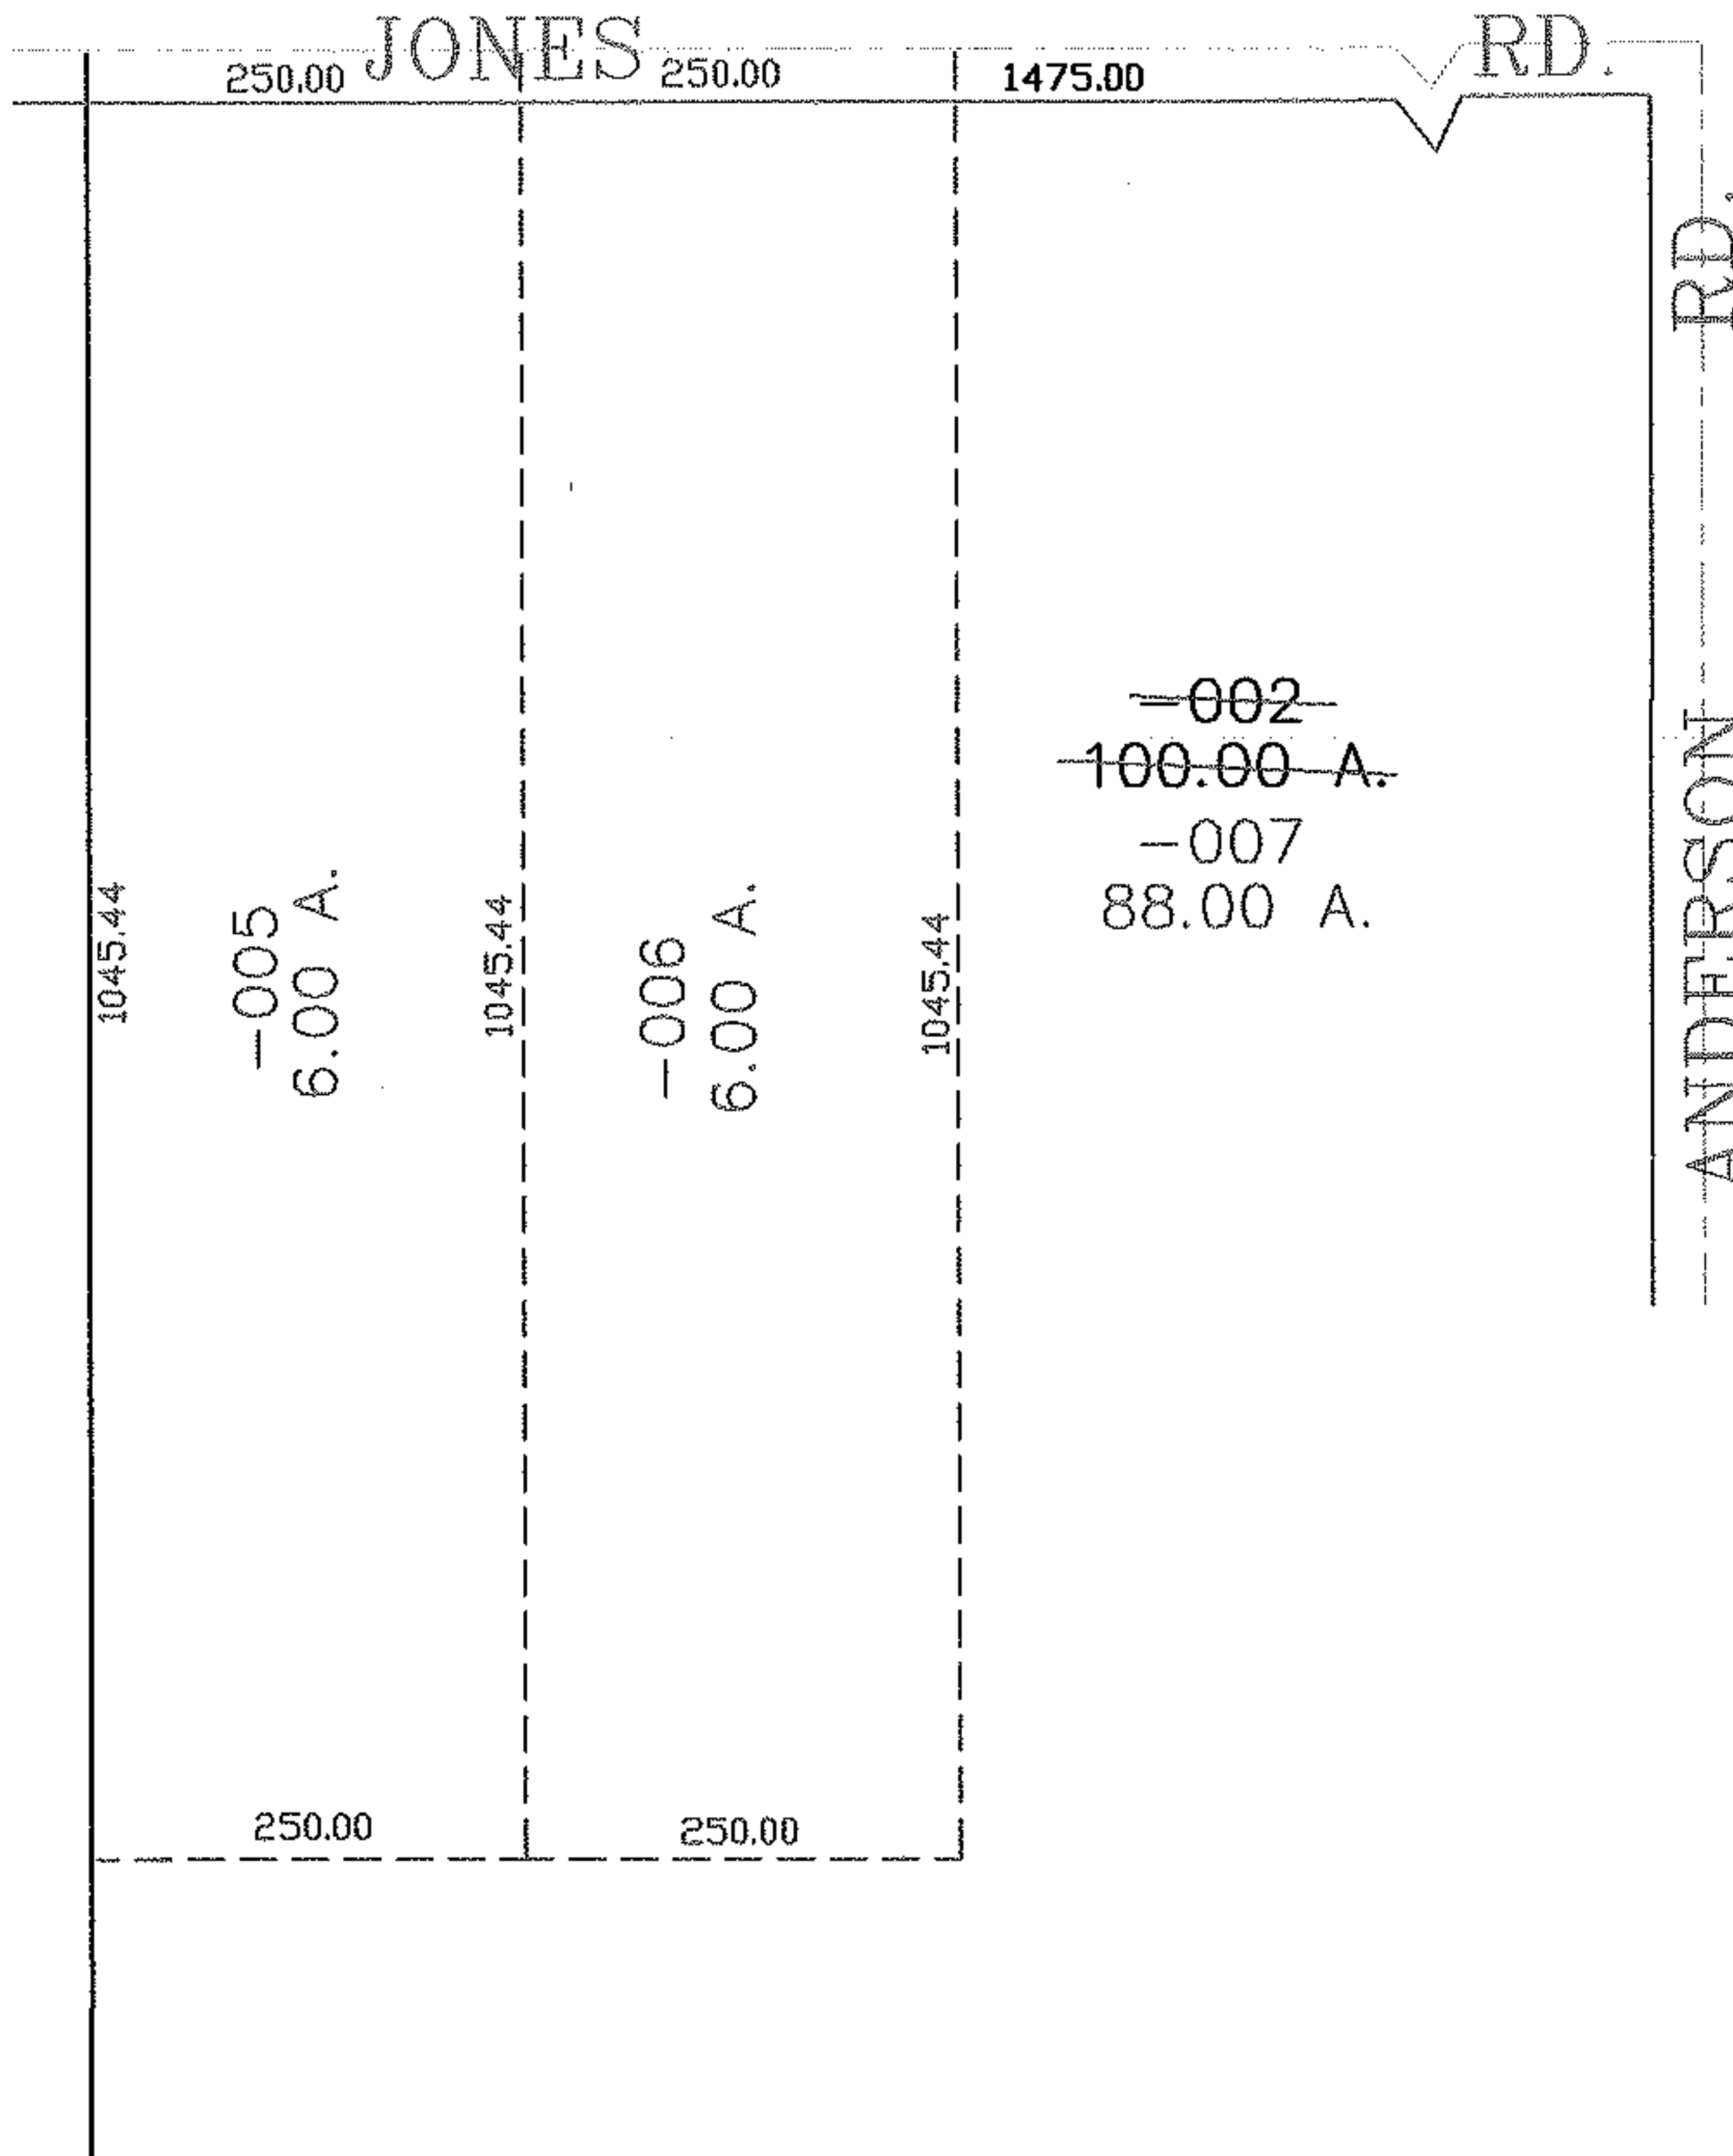


PARENT PARCEL: 17-06-023-000-002

CHILD PARCEL: 17-06-023-000-005 THRU -007

STARTING POINT: CENTERLINE JONES RD & ANDERSON RD

06-02103

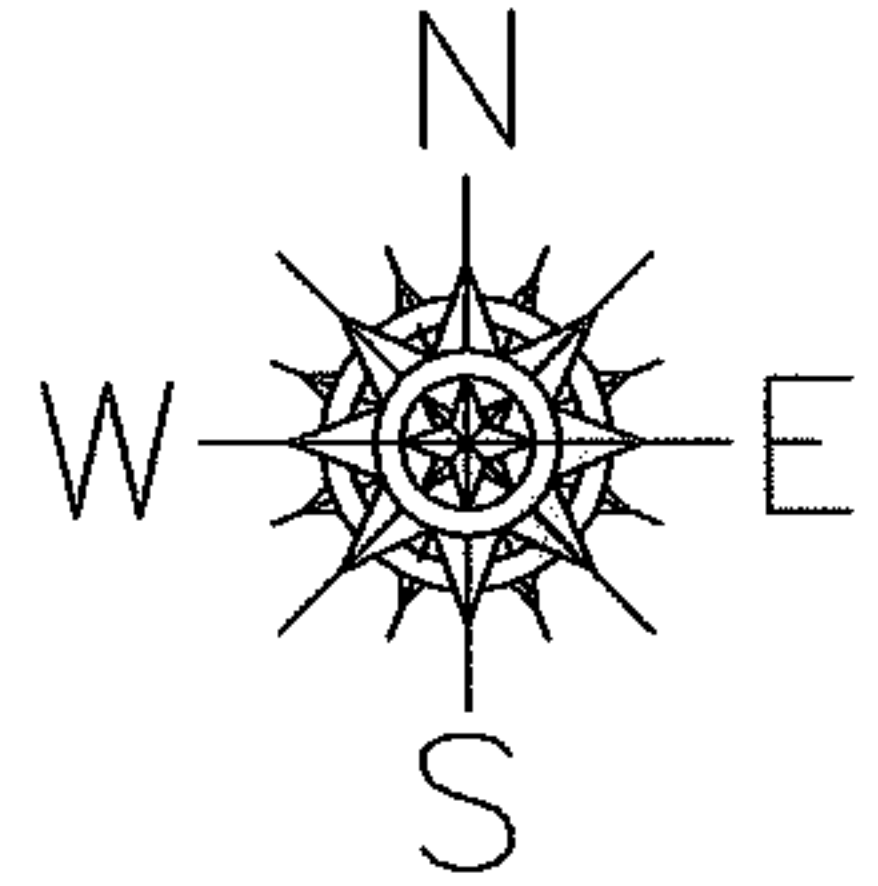

**SPLITS/DEEDS PROCESSED**  
 LORAIN COUNTY TAX MAP DEPARTMENT  
 226 MIDDLE AVE. ELYRIA, OHIO

SURVEYED BY: RICHARD CARLSON  
 CLOSURE: 0.00 : 10.000  
 MAP PAGE(S): 17-G  
 APPROVED BY: JAH DATE: 2-15-06  
 SCALE: 1" = 200 PRIOR INSTRUMENT: DV 1318/477