




RASTER

PARENT PARCEL: 01-00-052-000-044

CHILD PARCEL: 01-00-052-000-045 -046

STARTING POINT: INTERSECTION OF C/L OF VERMILION RD. AND C/L OF NORTH RIDGE RD.

06-02104

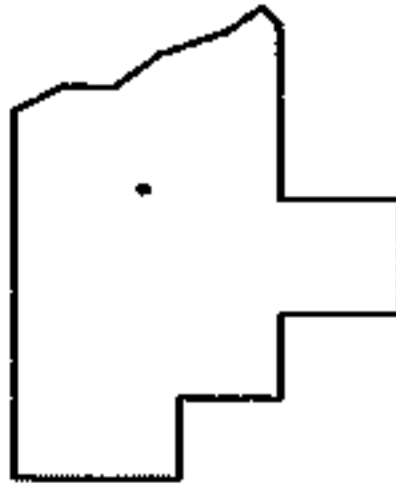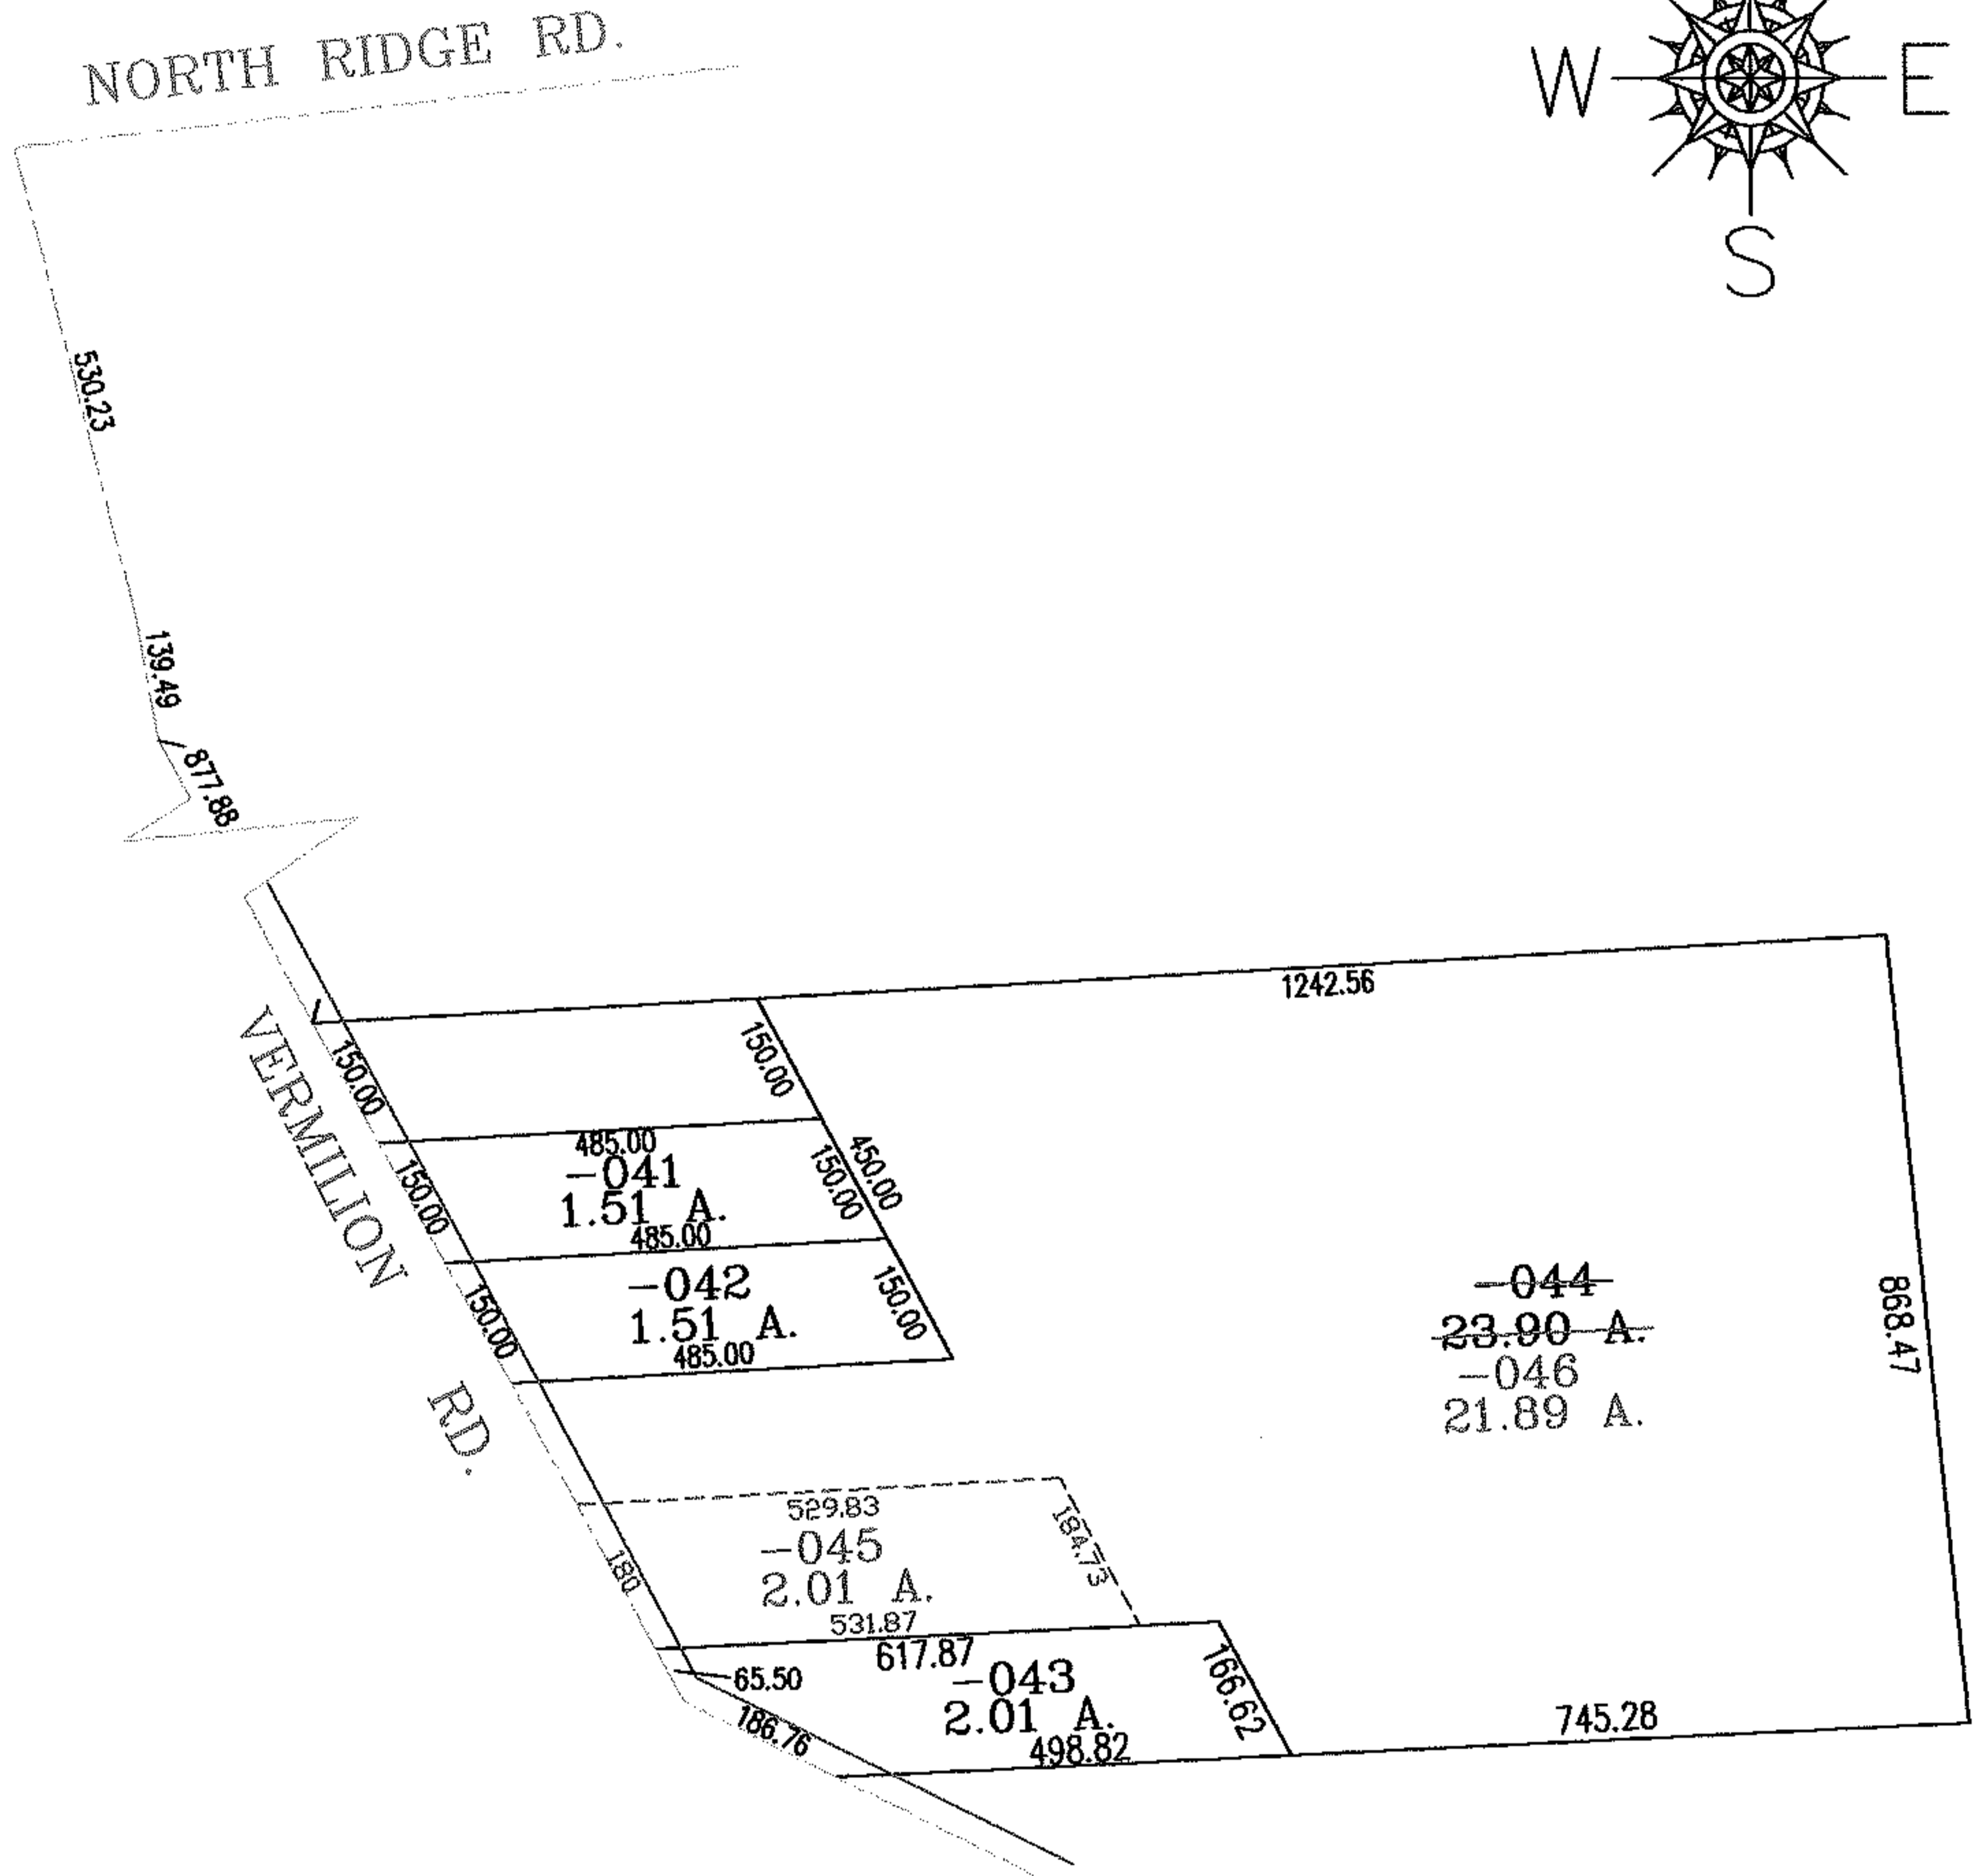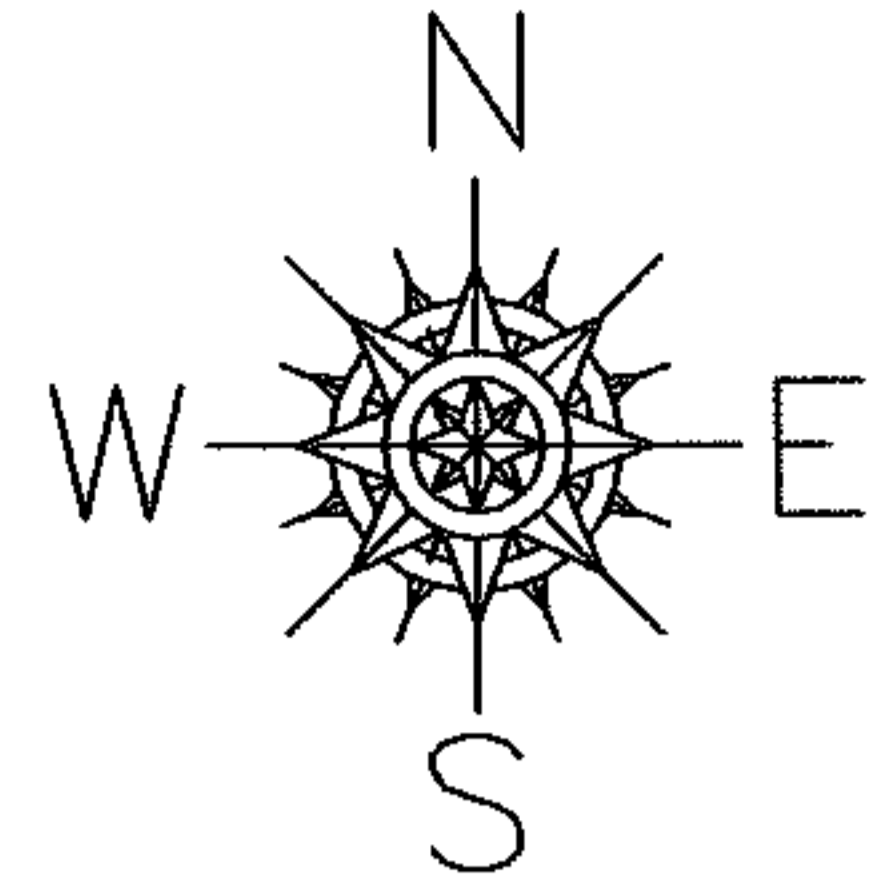

**SPLITS/DEEDS PROCESSED**  
 LORAIN COUNTY TAX MAP DEPARTMENT  
 226 MIDDLE AVE. ELYRIA, OHIO

SURVEYED BY: THOMAS A. SIMON  
 CLOSURE: .00:10.000  
 MAP PAGE(S): 1-J  
 APPROVED BY: JAH DATE: 2-15-06  
 SCALE: 1" = 300 PRIOR INSTRUMENT: 20040012691