



PARENT PARCEL: 05-00-024-121-005
CHILD PARCEL: 05-00-024-121-027
STARTING POINT: NORTHWEST CORNER OF S/L 164 IN JOSIAH HARRIS HEIRS SUB.(VOL.2 PG.3)

10-02106-C

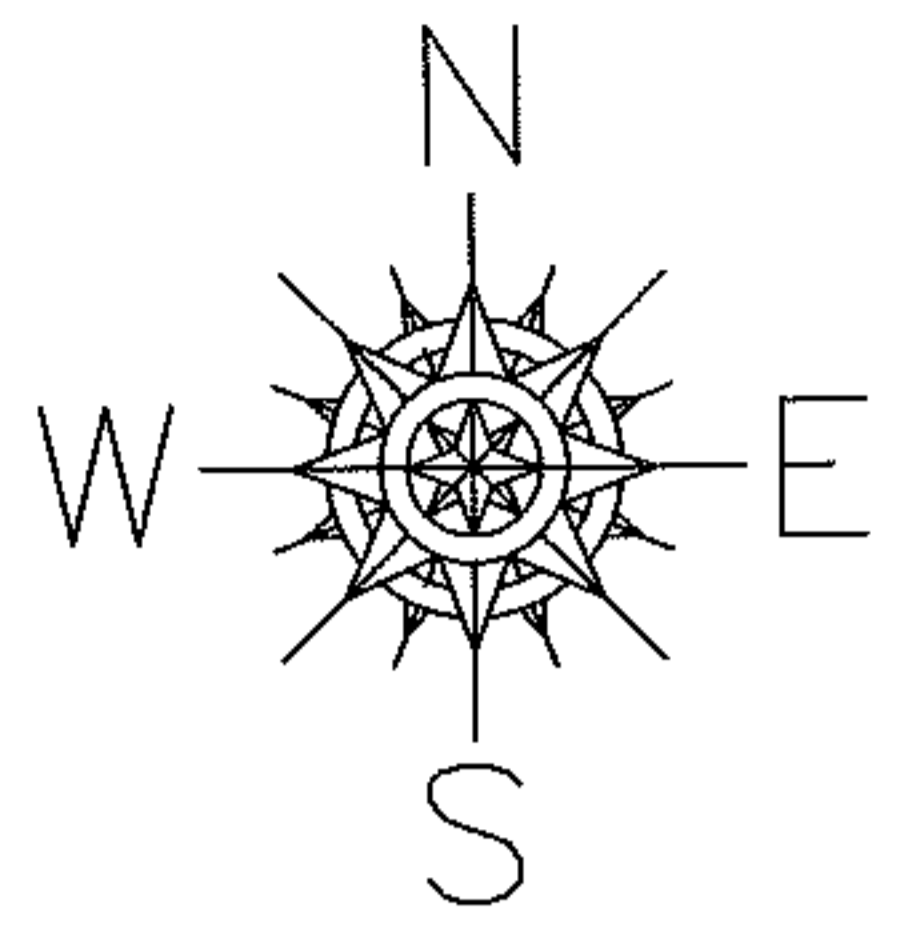


EAST ST.

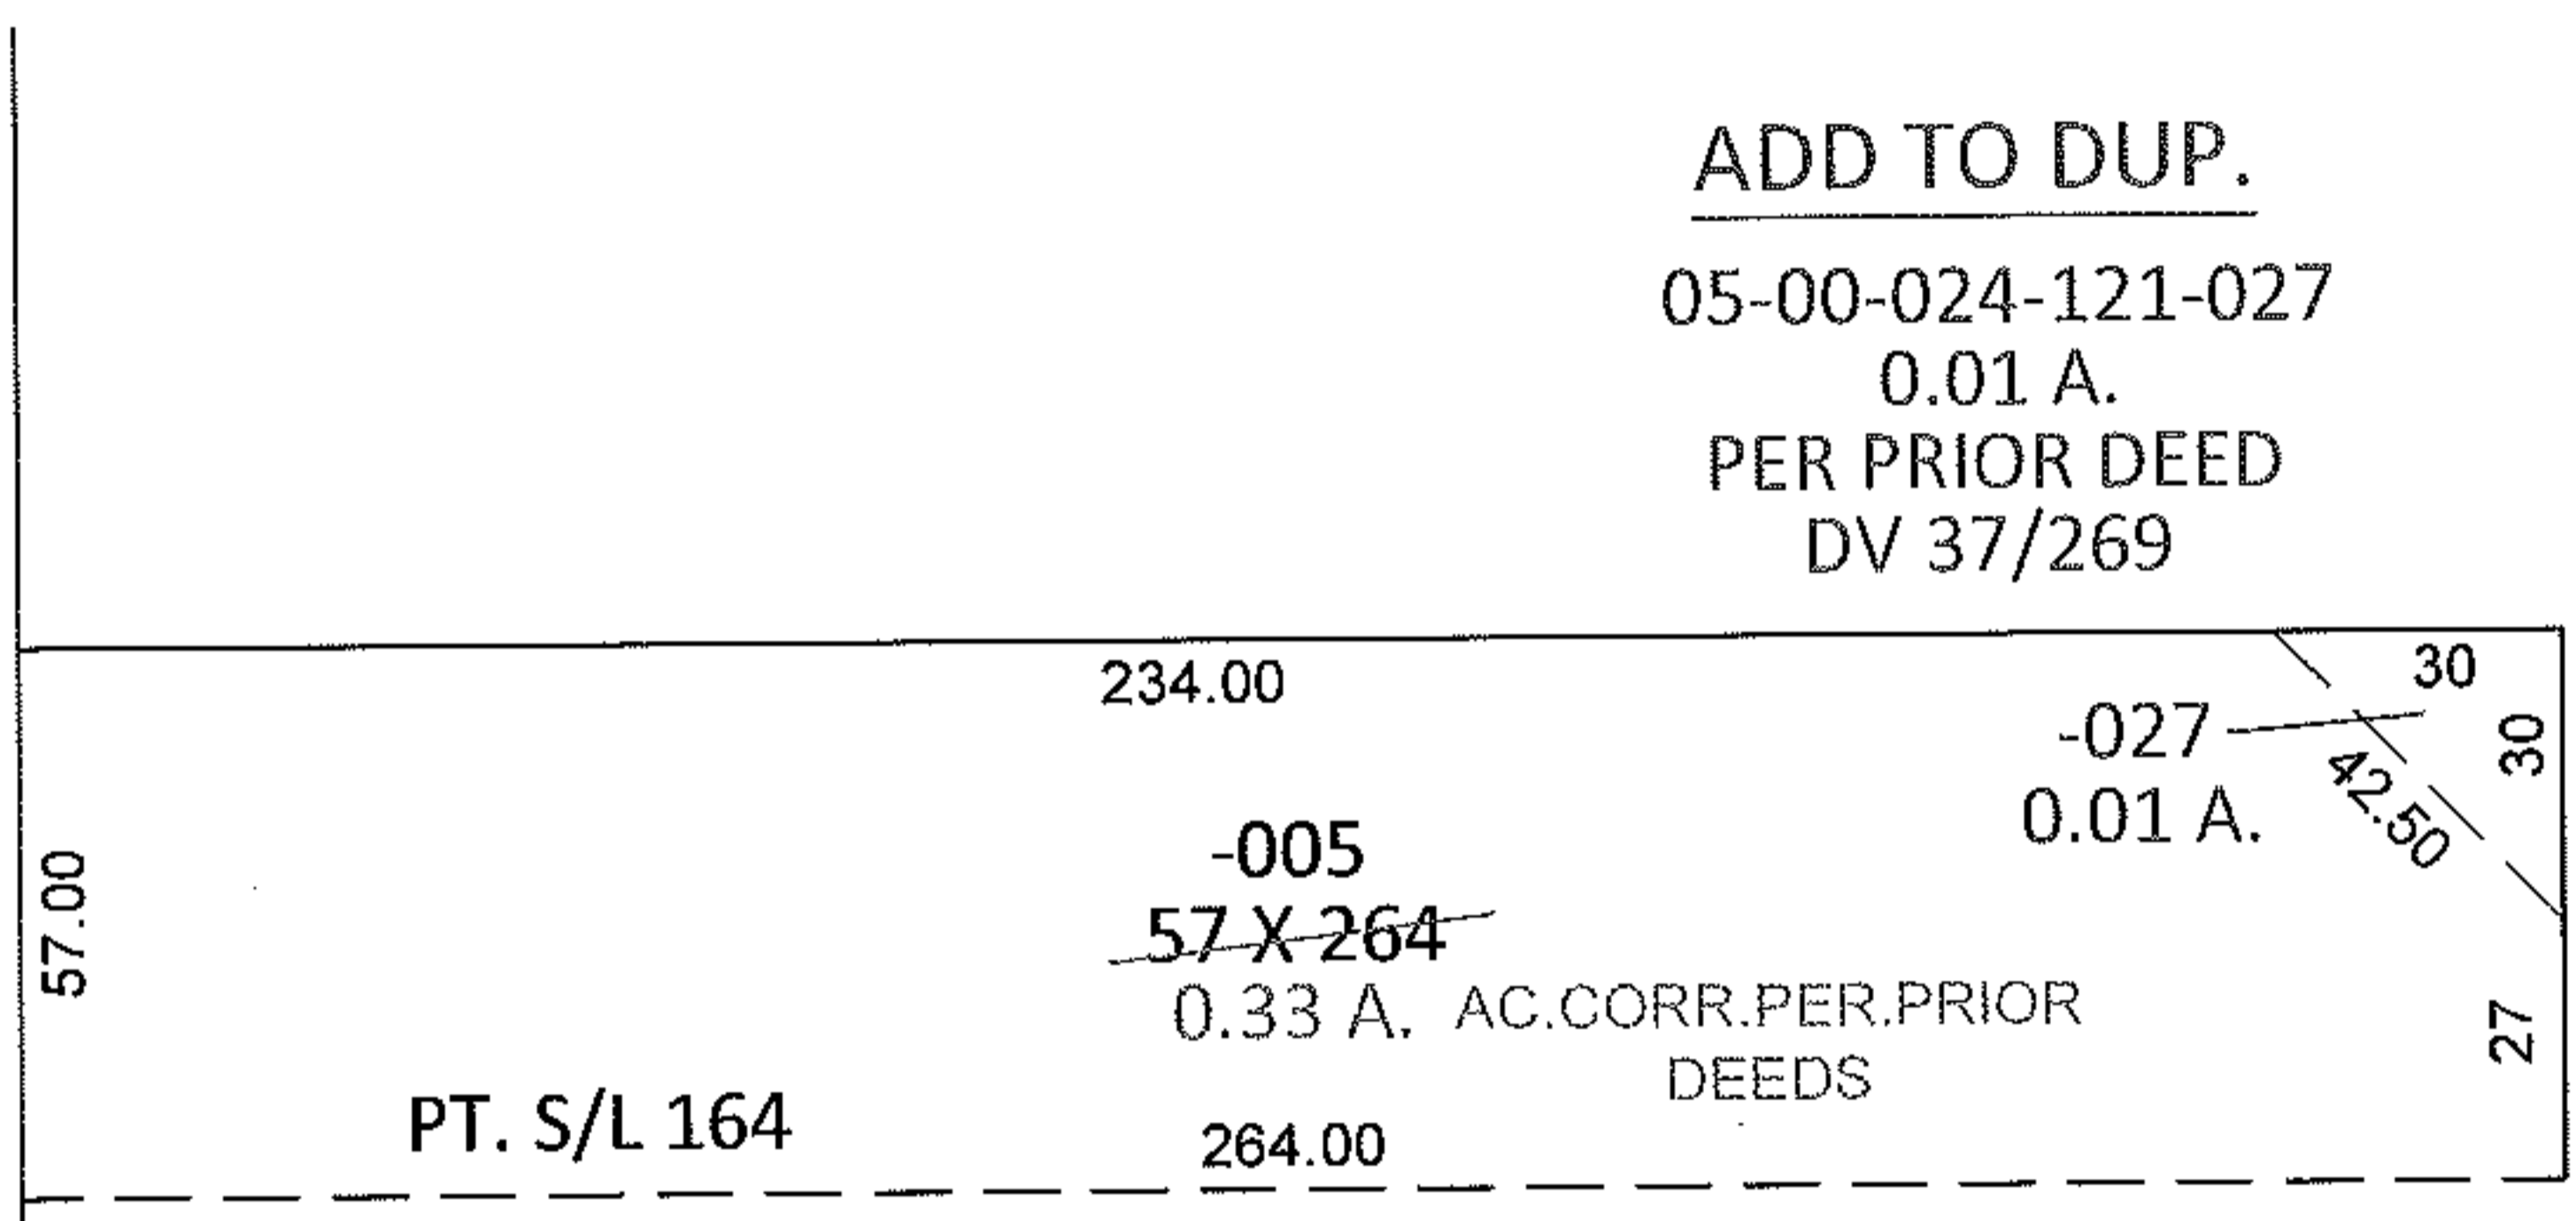

ADD TO DUP.
05-00-024-121-027
0.01 A.
PER PRIOR DEED
DV 37/269

ACERAGE CORR.
05-00-024-121-005
~~57 X 264~~
0.33 A.
PER PRIOR DEEDS
20100342542
20050069541
DV 1059/41

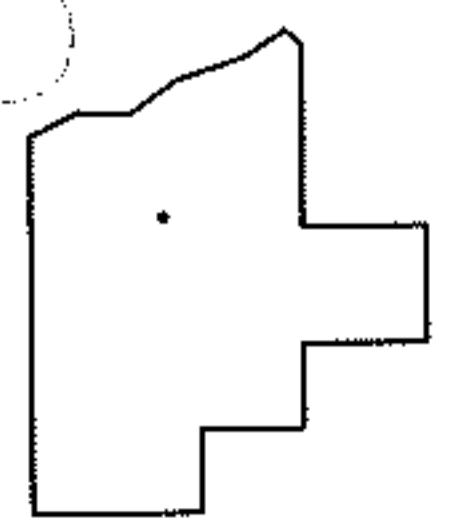

SPLITS/DEEDS PROCESSED
LORAIN COUNTY TAX MAP DEPARTMENT
226 MIDDLE AVE. ELYRIA, OHIO

SURVEYED BY: N/A
CLOSURE: N/A
MAP PAGE(S): 5-00-024-B
APPROVED BY: RRM DATE: 9-30-10
SCALE: 1"= 50' PRIOR INST.: SEE ABOVE