
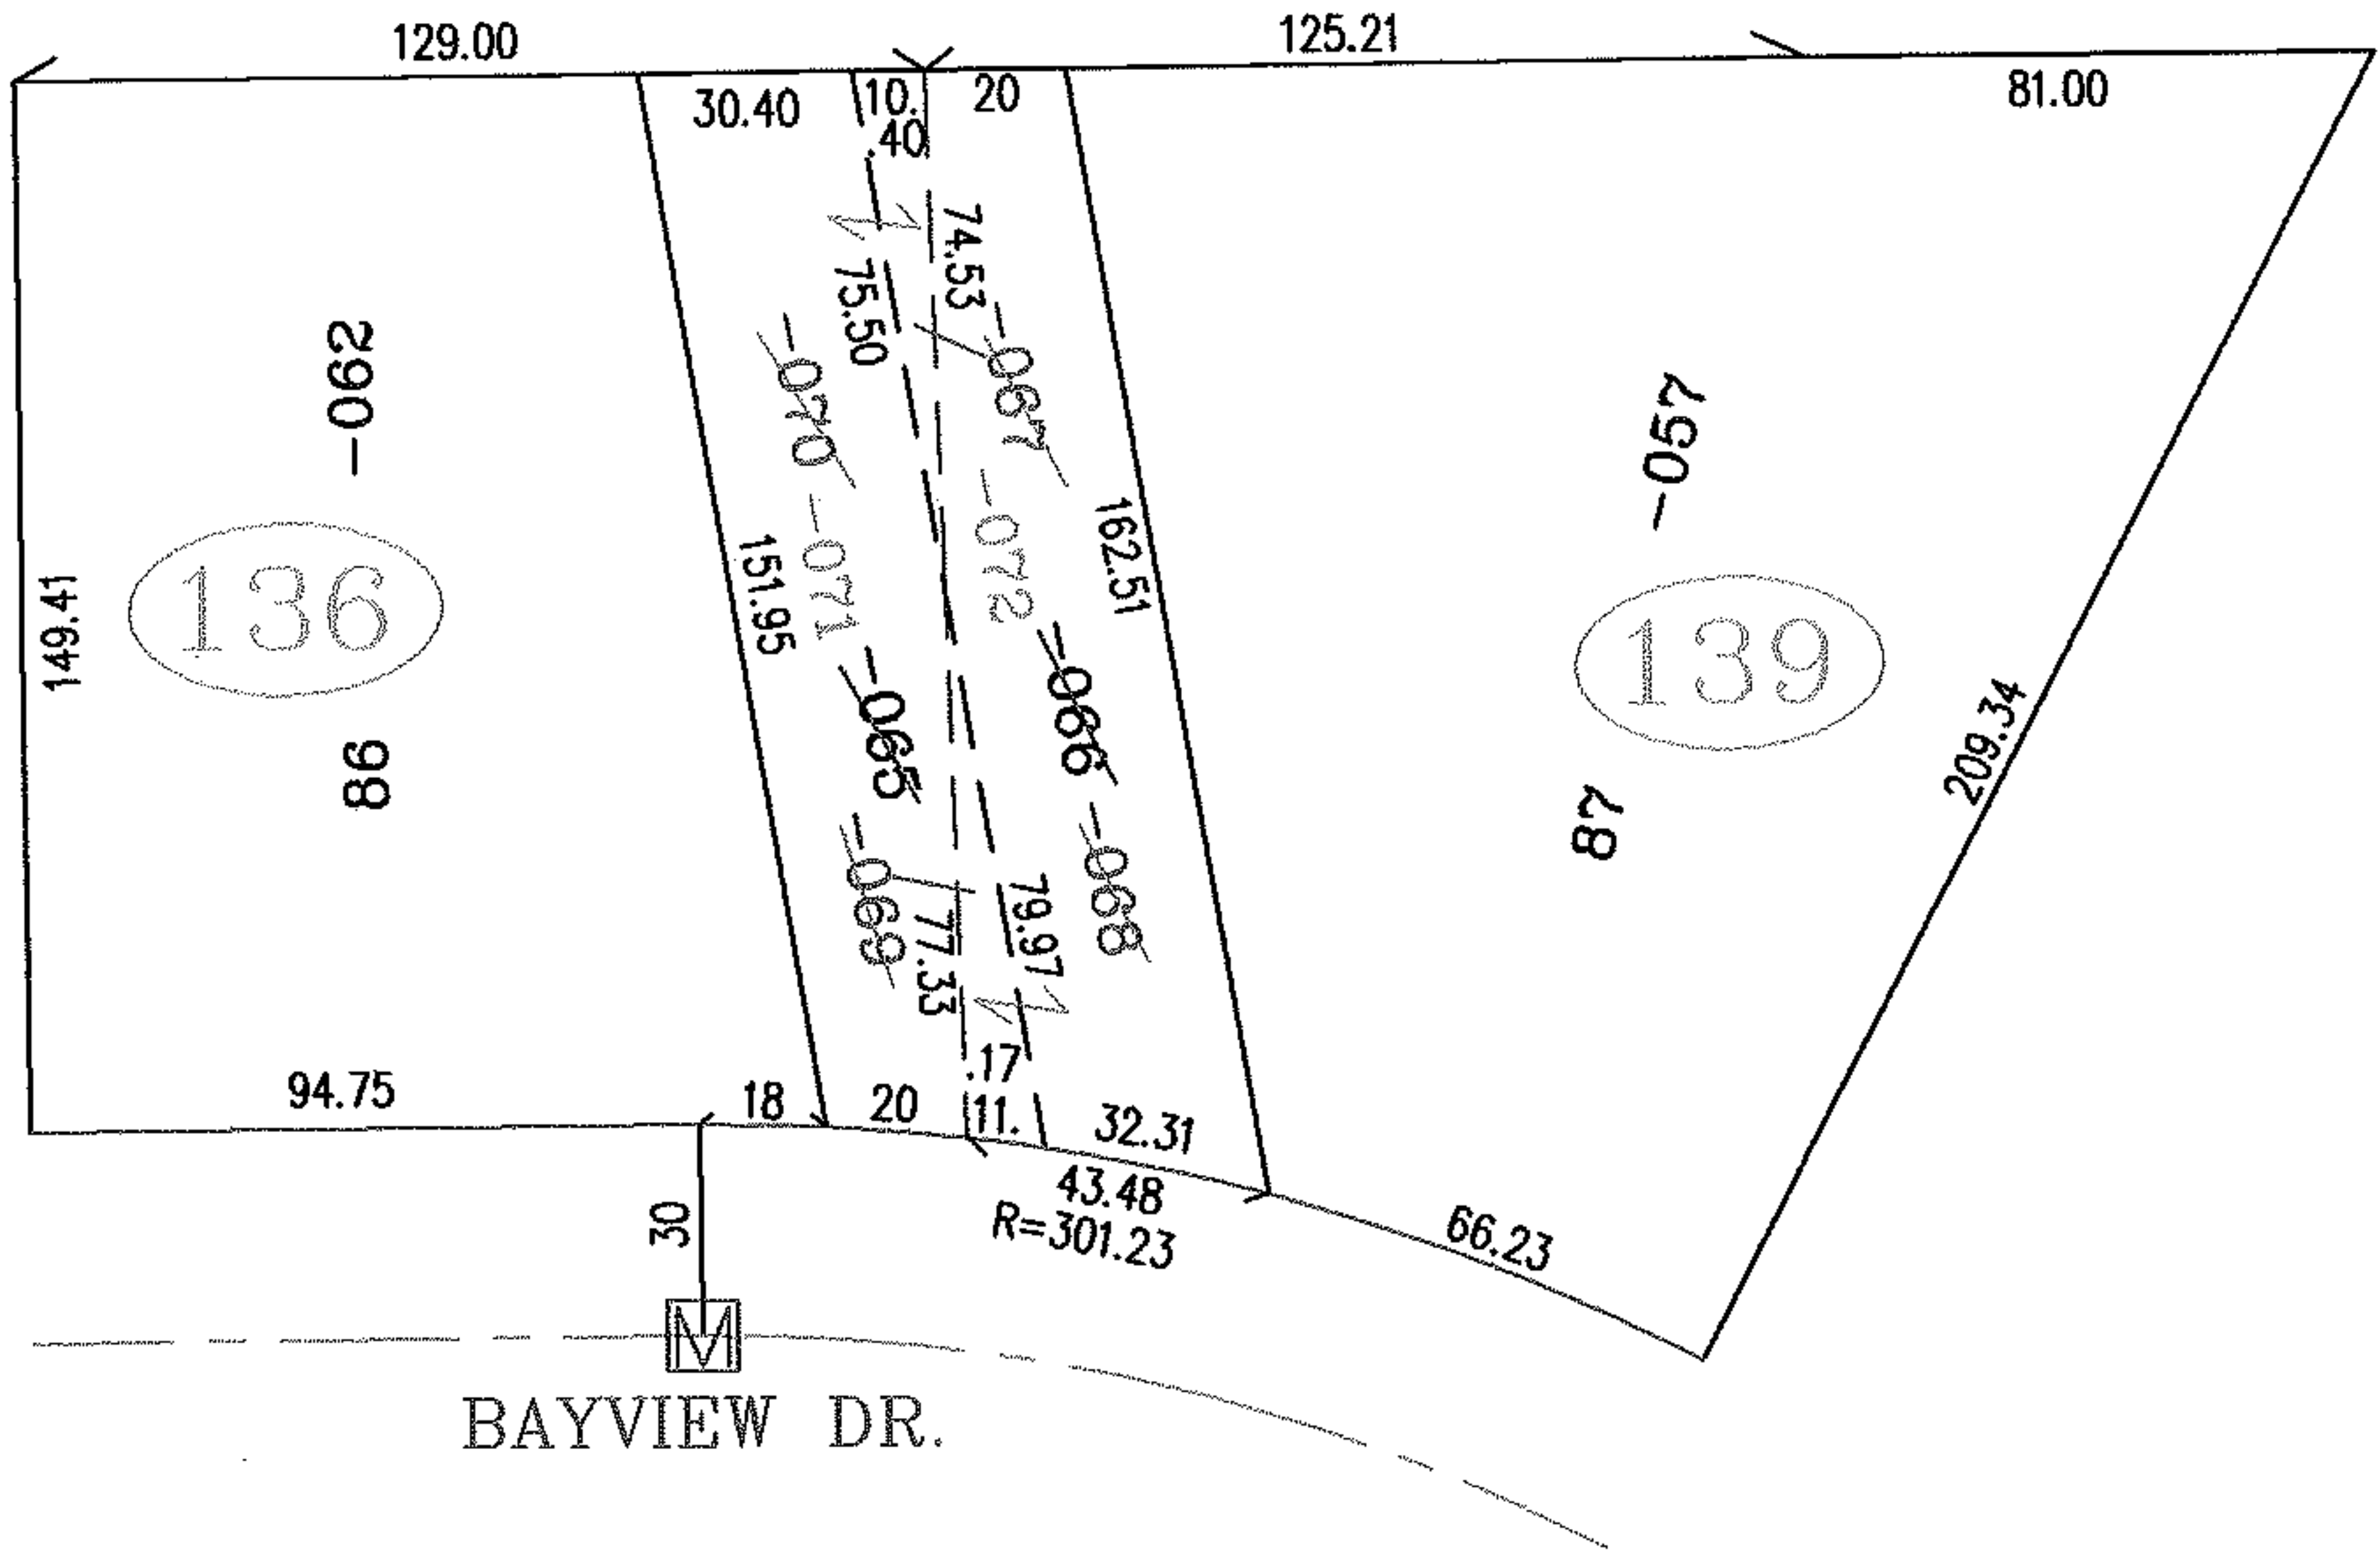


PARENT PARCEL: 04-00-030-136-062,-065,-066,04-00-030-139-057


06-02107

CHILD PARCEL: 04-00-030-136-067 THRU -072

STARTING POINT: MON BOX SOUTH OF S/L 86 IN WESTWINDS SUB. NO. 6

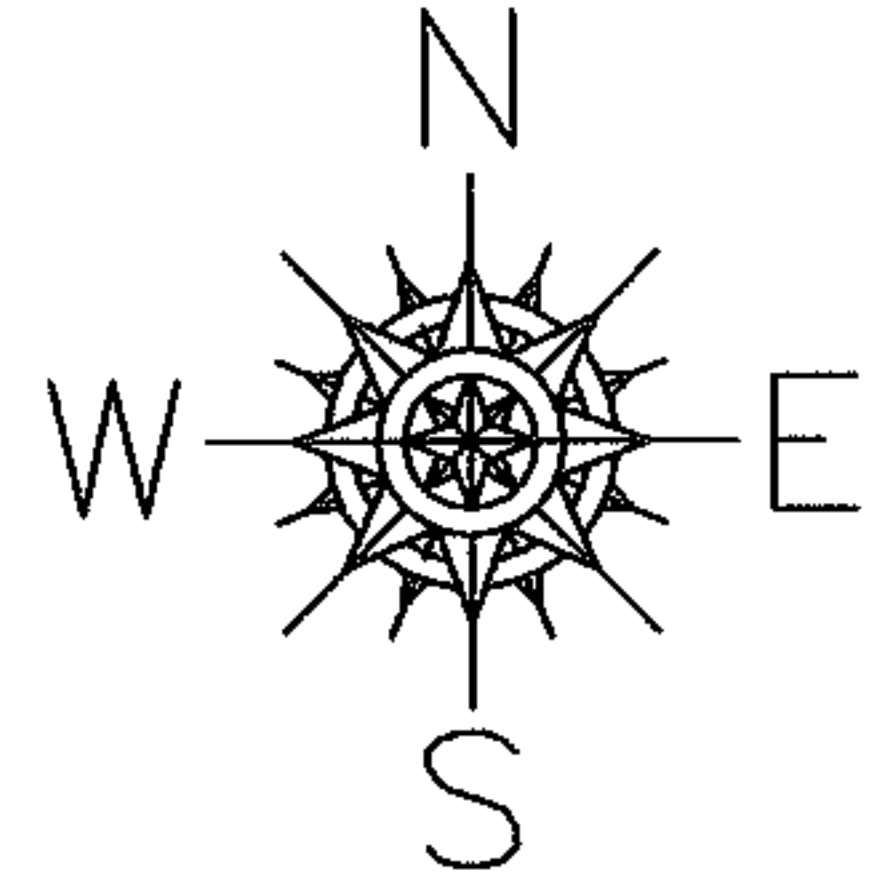

2000663722
19980541422

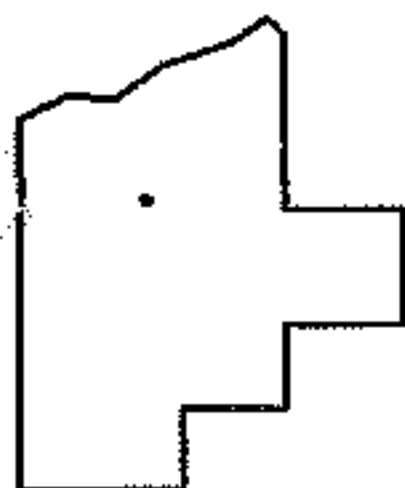

SPLITS/DEEDS PROCESSED

LORAIN COUNTY TAX MAP DEPARTMENT
226 MIDDLE AVE. ELYRIA, OHIO

SURVEYED BY: DANE HAPONER
 CLOSURE: .01:10.000
 MAP PAGE(S): 04-00-030-G
 APPROVED BY: RRM DATE: 4/21/06
 SCALE: 1" = 50' PRIOR INSTRUMENT: SEE ABOVE