
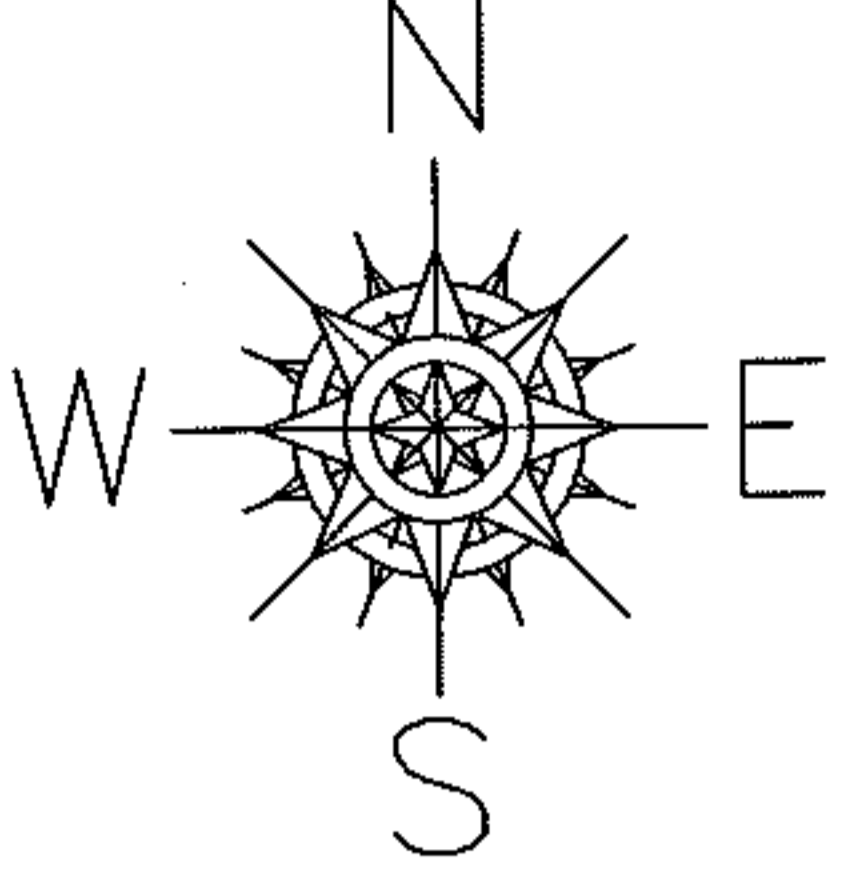


ROSTER

PARENT PARCEL: XX-XX-XXX-XXX-XXX
CHILD PARCEL: XX-XX-XXX-XXX-XXX
STARTING POINT: CHAMBERLAIN RD. 60' WIDE, FROM DUNHAM RD. NORTH TO LAW RD.

10-02109-X

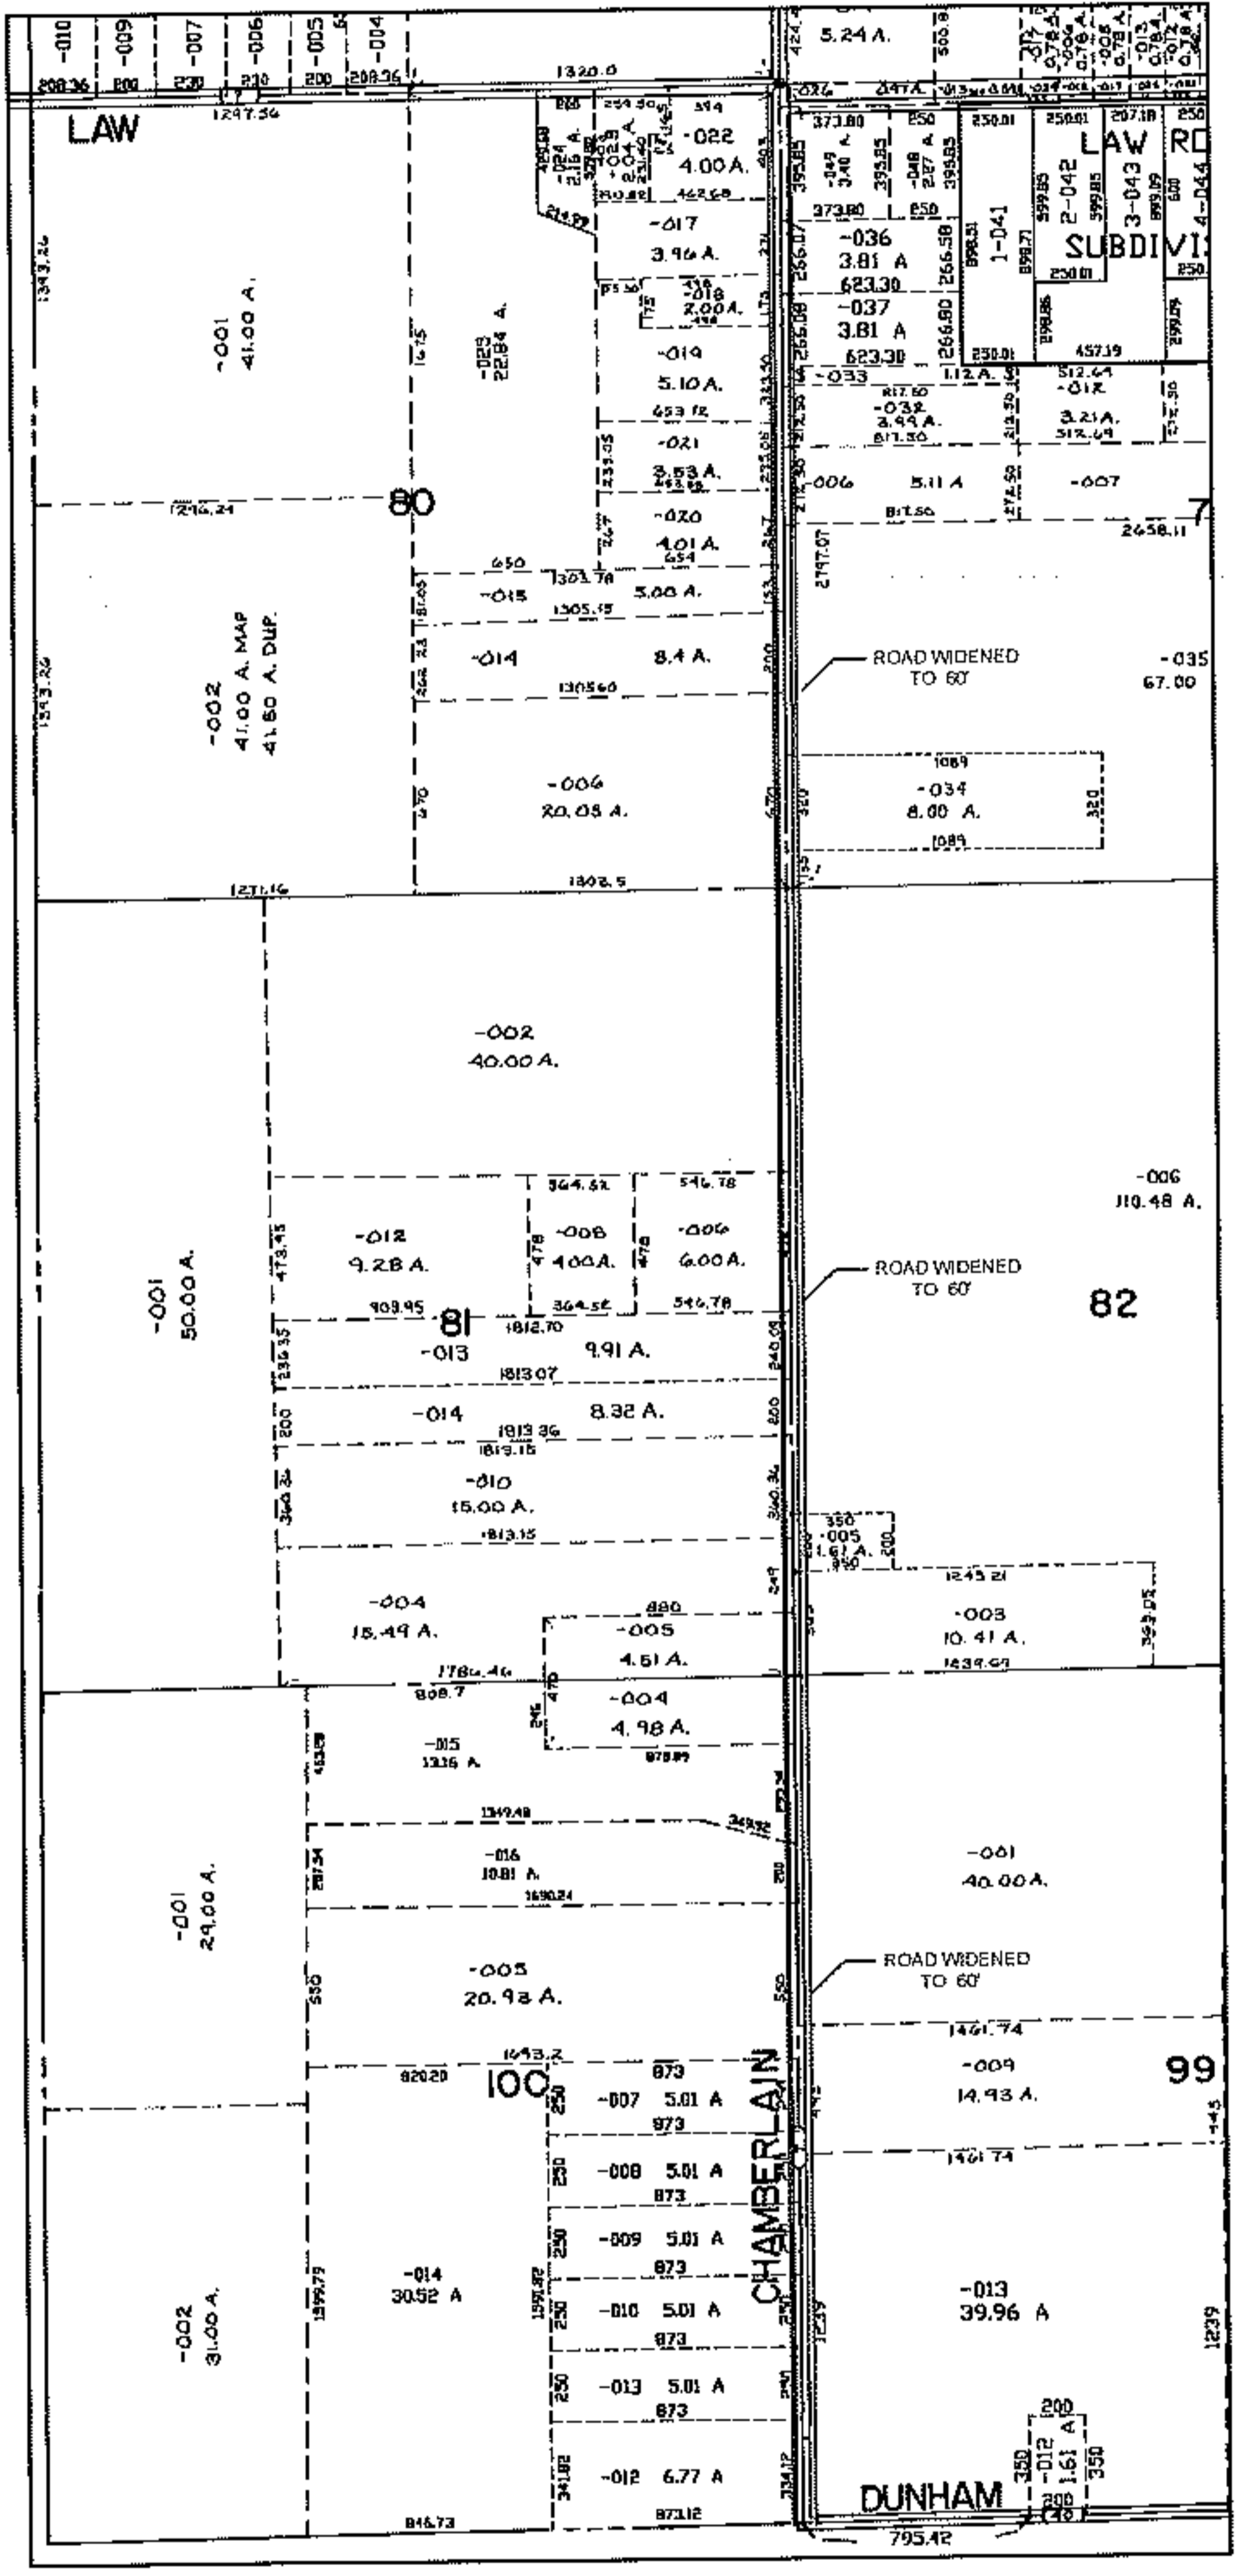

MAP CORRECTION

CHAMBERLAIN ROAD WIDENED TO 60'

FROM DUNHAM RD. NORTH TO LAW RD.
PER RESOLUTION #10-510
JULY 21, 2010

SPLITS/DEEDS PROCESSED

LORAIN COUNTY TAX MAP DEPARTMENT
226 MIDDLE AVE. ELYRIA, OHIO

SURVEYED BY: NONE
 CLOSURE: NONE
 MAP PAGE(S): 16-E
 APPROVED BY: TJS DATE: 10/1/10
 SCALE: 1"= 1200 PRIOR INST.: DV XXXX/XXX