


RASTER

PARENT PARCEL: 05-00-002-000-044

CHILD PARCEL: 05-00-002-000-190, -191



STARTING POINT: CENTERLINE OF COOPER FOSTER PK RD & NORTH LAKE ST.

06-02112

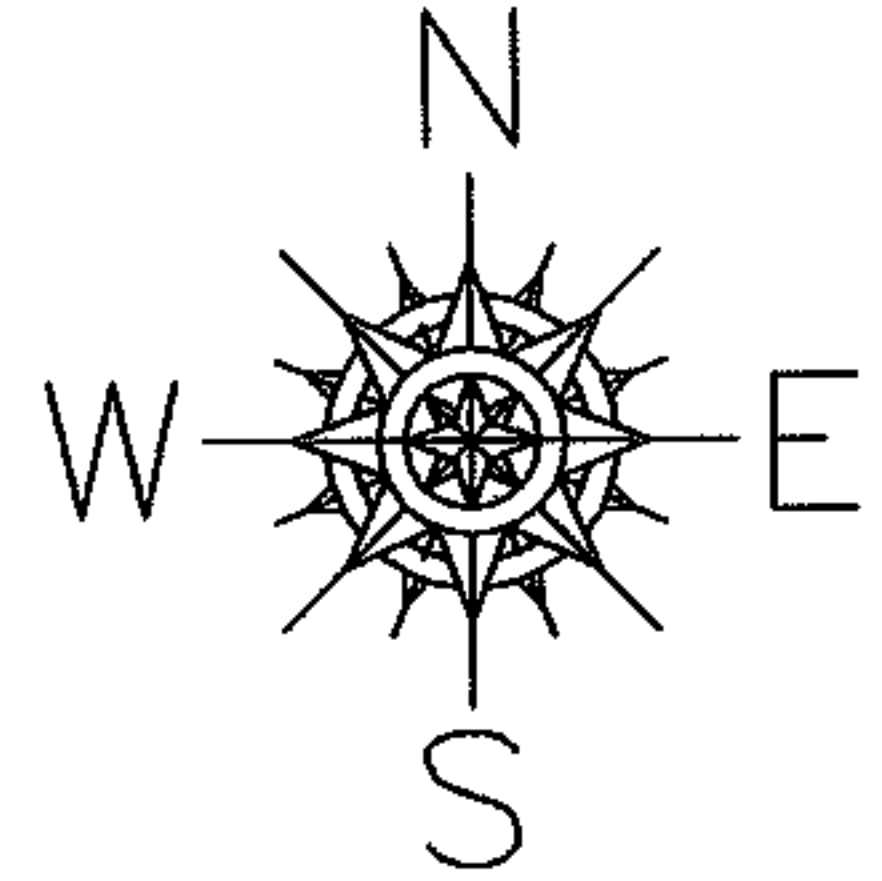

COOPER FOSTER PARK

RD

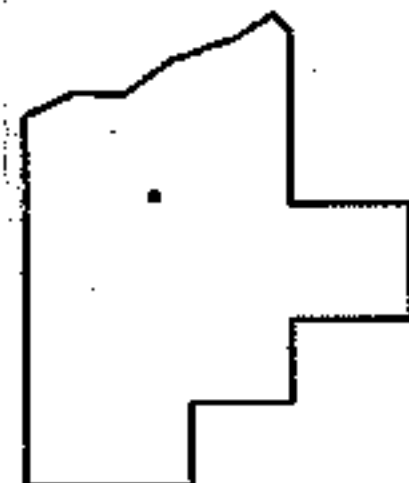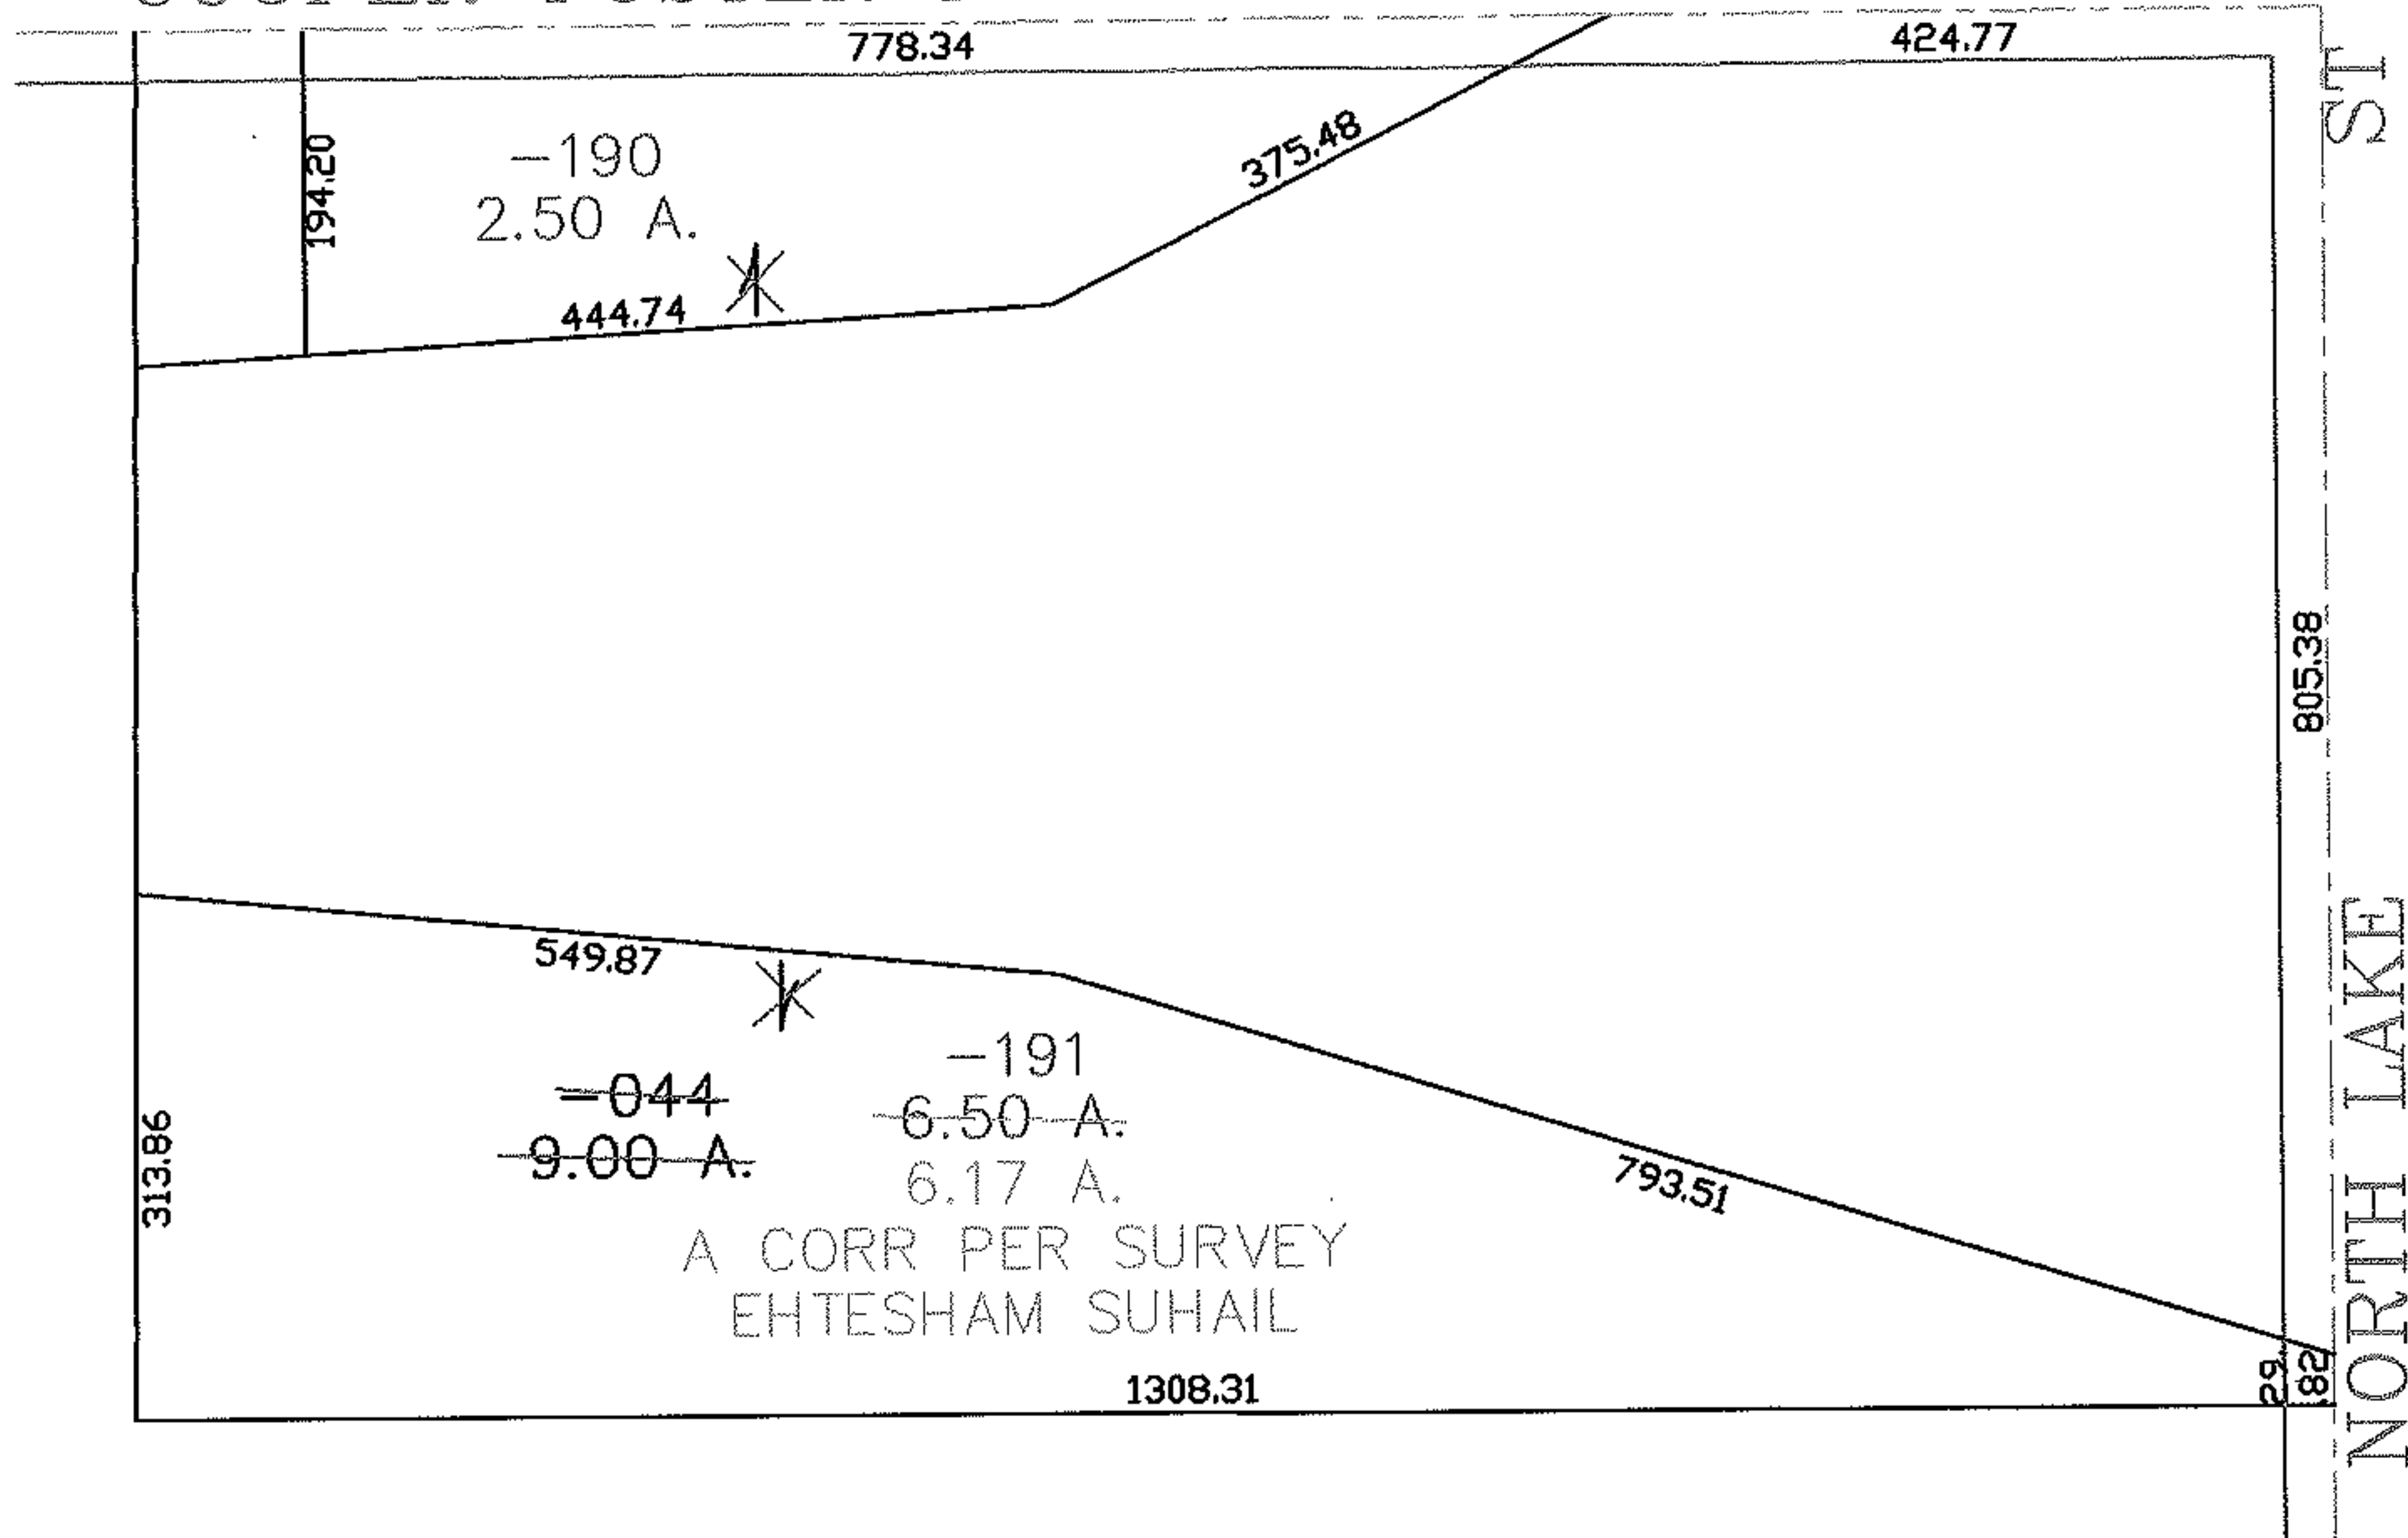

**SPLITS/DEEDS PROCESSED**  
**LORAIN COUNTY TAX MAP DEPARTMENT**  
 226 MIDDLE AVE. ELYRIA, OHIO

SURVEYED BY: EHTESHAM SUHAIL  
 CLOSURE: 0.00 : 10,000  
 MAP PAGE(S): 05-00-002-B  
 APPROVED BY: JAH DATE: 2-27-06  
 SCALE: 1" = 200' PRIOR INSTRUMENT: OR 653/27

*Handwritten initials*