
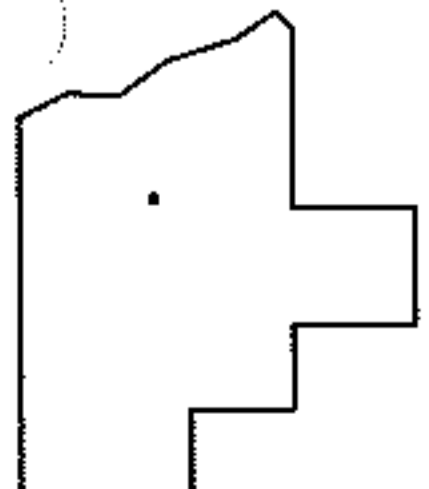
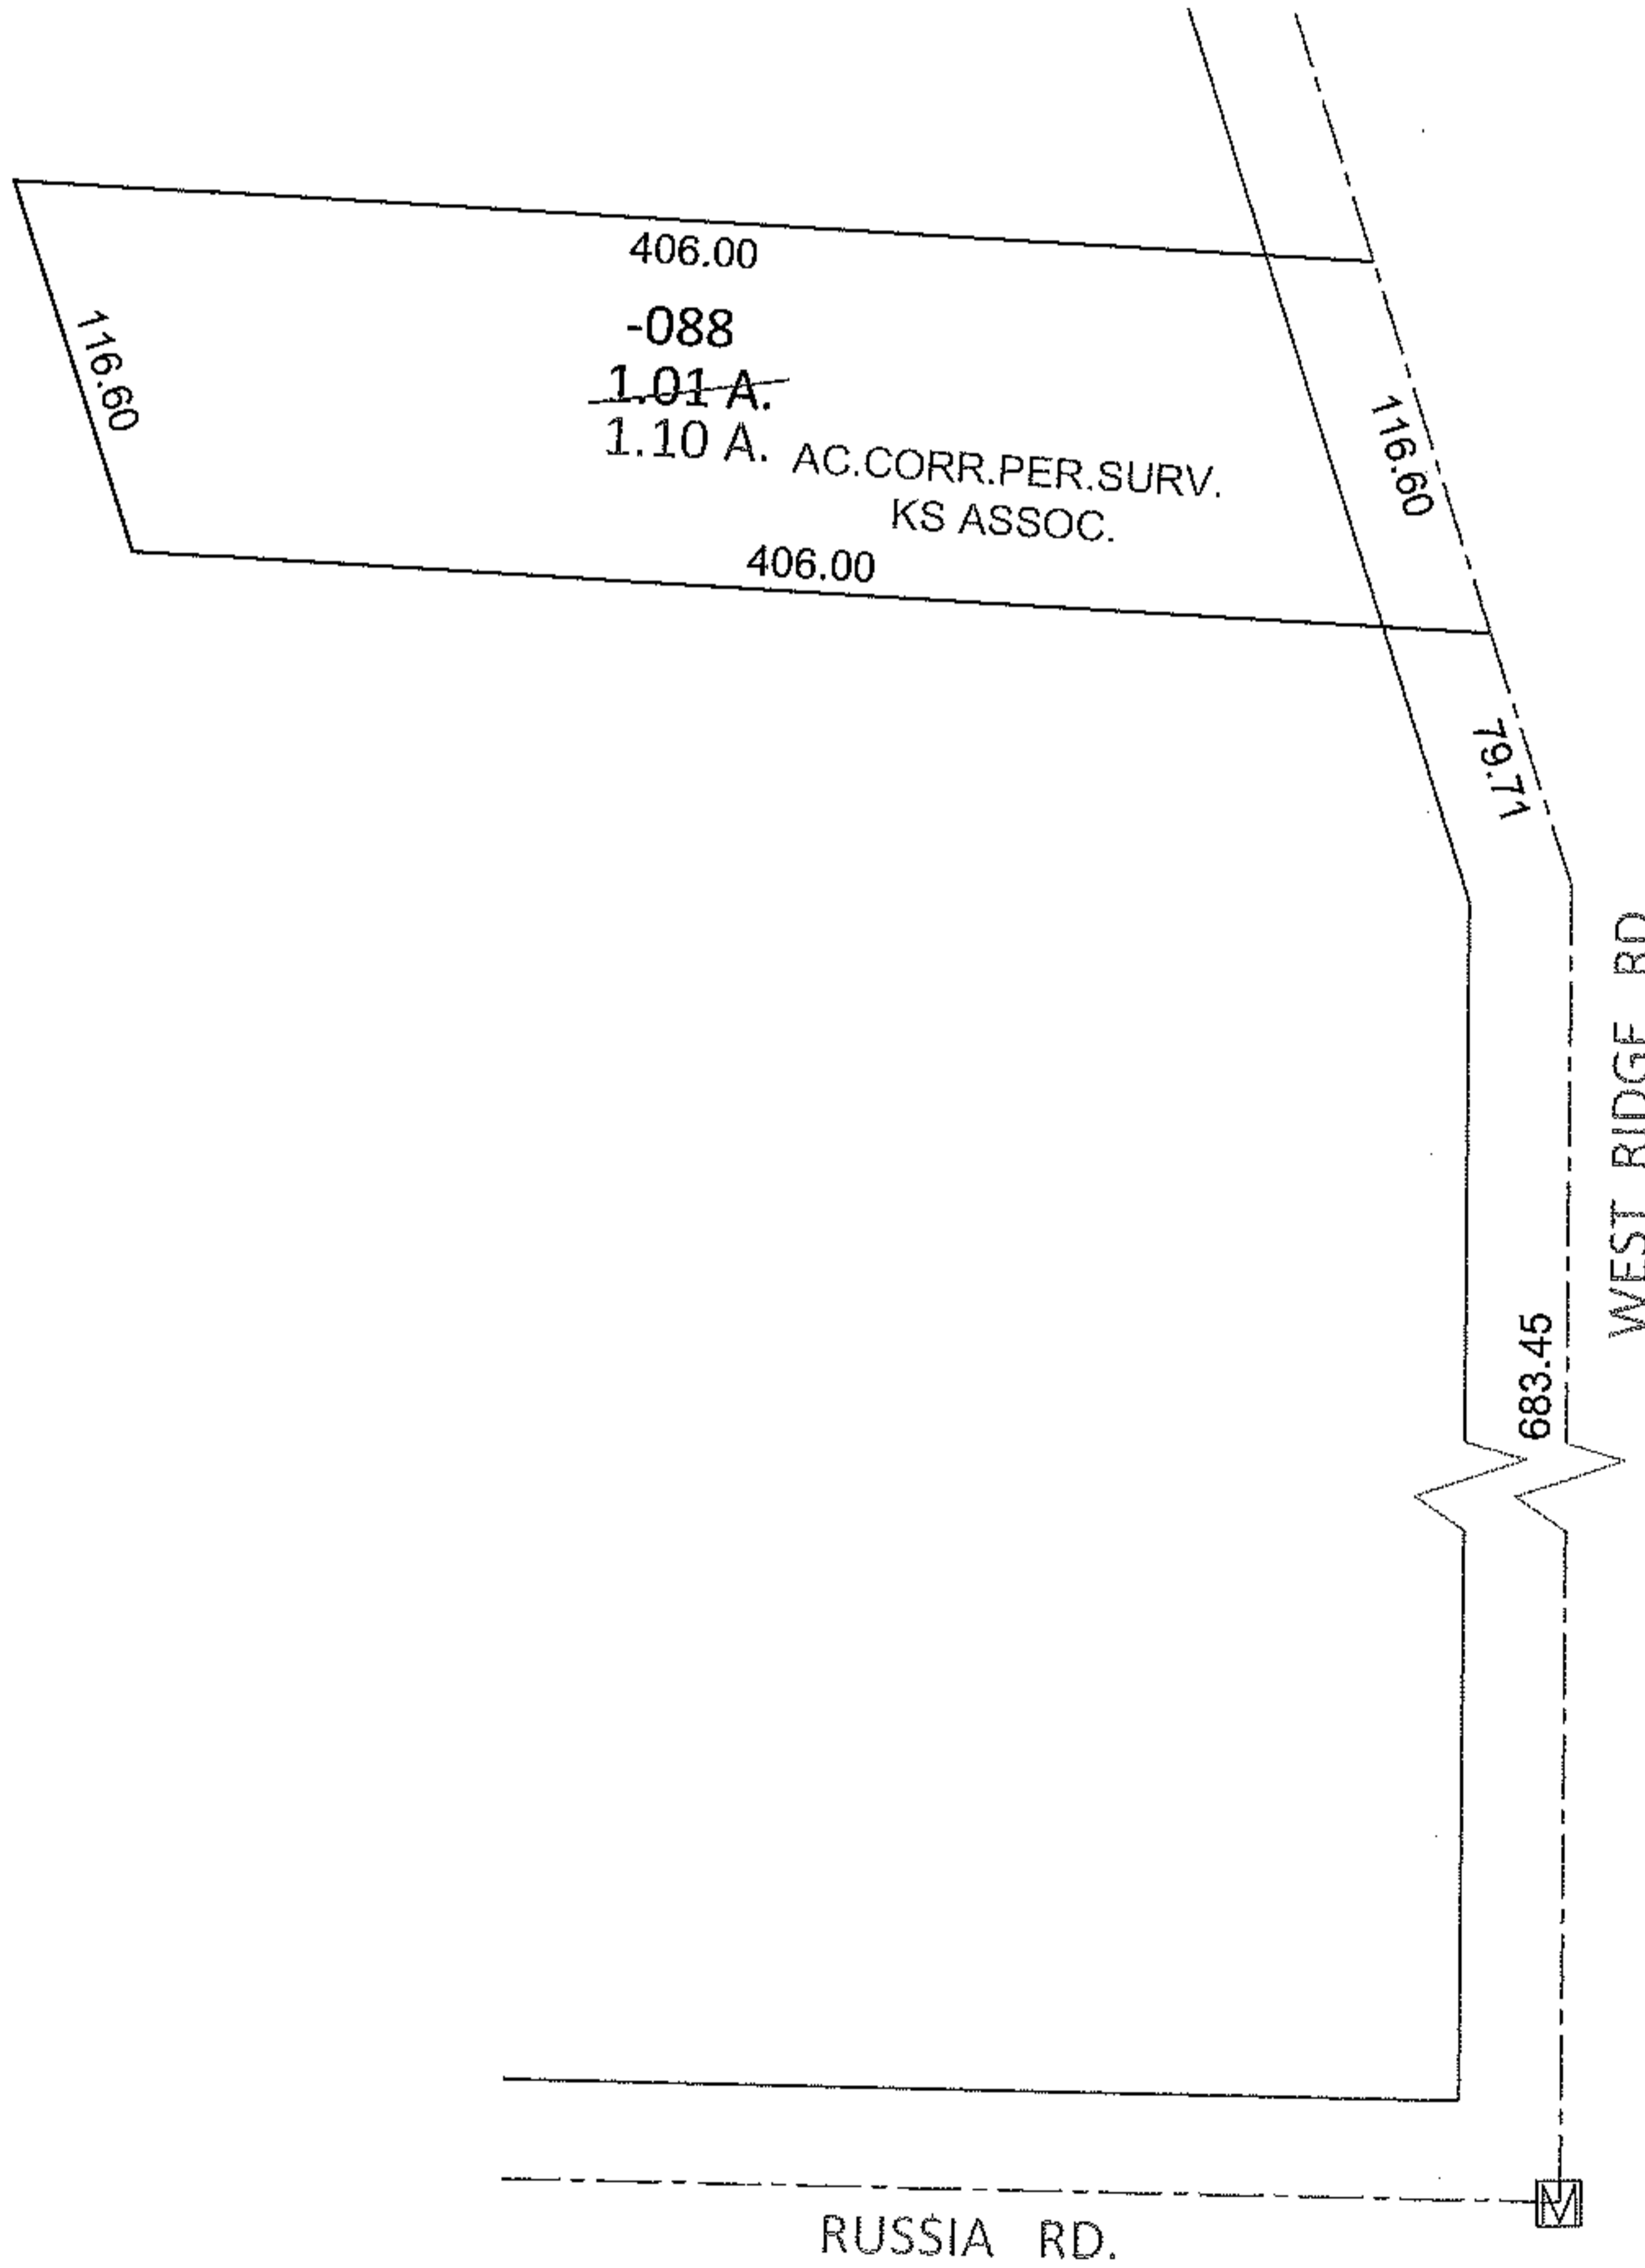


PARENT PARCEL: 10-00-001-101-088

10-02115-A

CHILD PARCEL:

STARTING POINT: AT A MON BOX AT THE INTERSECTION OF C/L OF RUSSIA RD. AND C/L OF WEST RIDGE RD.

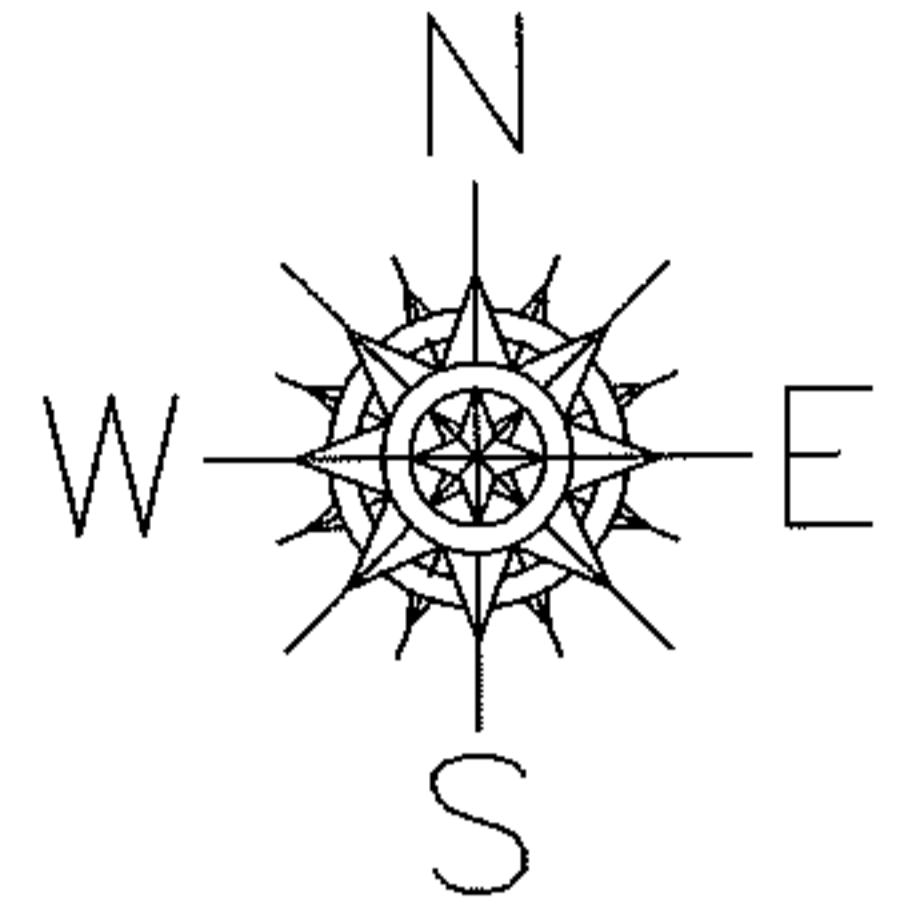

SPLITS/DEEDS PROCESSED

LORAIN COUNTY TAX MAP DEPARTMENT
226 MIDDLE AVE. ELYRIA, OHIO

SURVEYED BY: KS ASSOCIATES

CLOSURE: .00:10.00

MAP PAGE(S): 10-00-001-G

APPROVED BY: RRM DATE: 10/8/10

SCALE: 1"= 100 PRIOR INST.: 20010738830