




RASTER

06-02116

PARENT PARCEL: 06-25-007-000-022

CHILD PARCEL: 06-25-007-000-254 THRU -257

STARTING POINT: CENTERLINE OF SUGAR LANE & EAST BROAD ST.

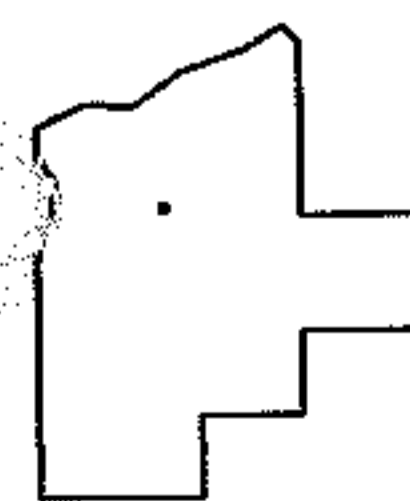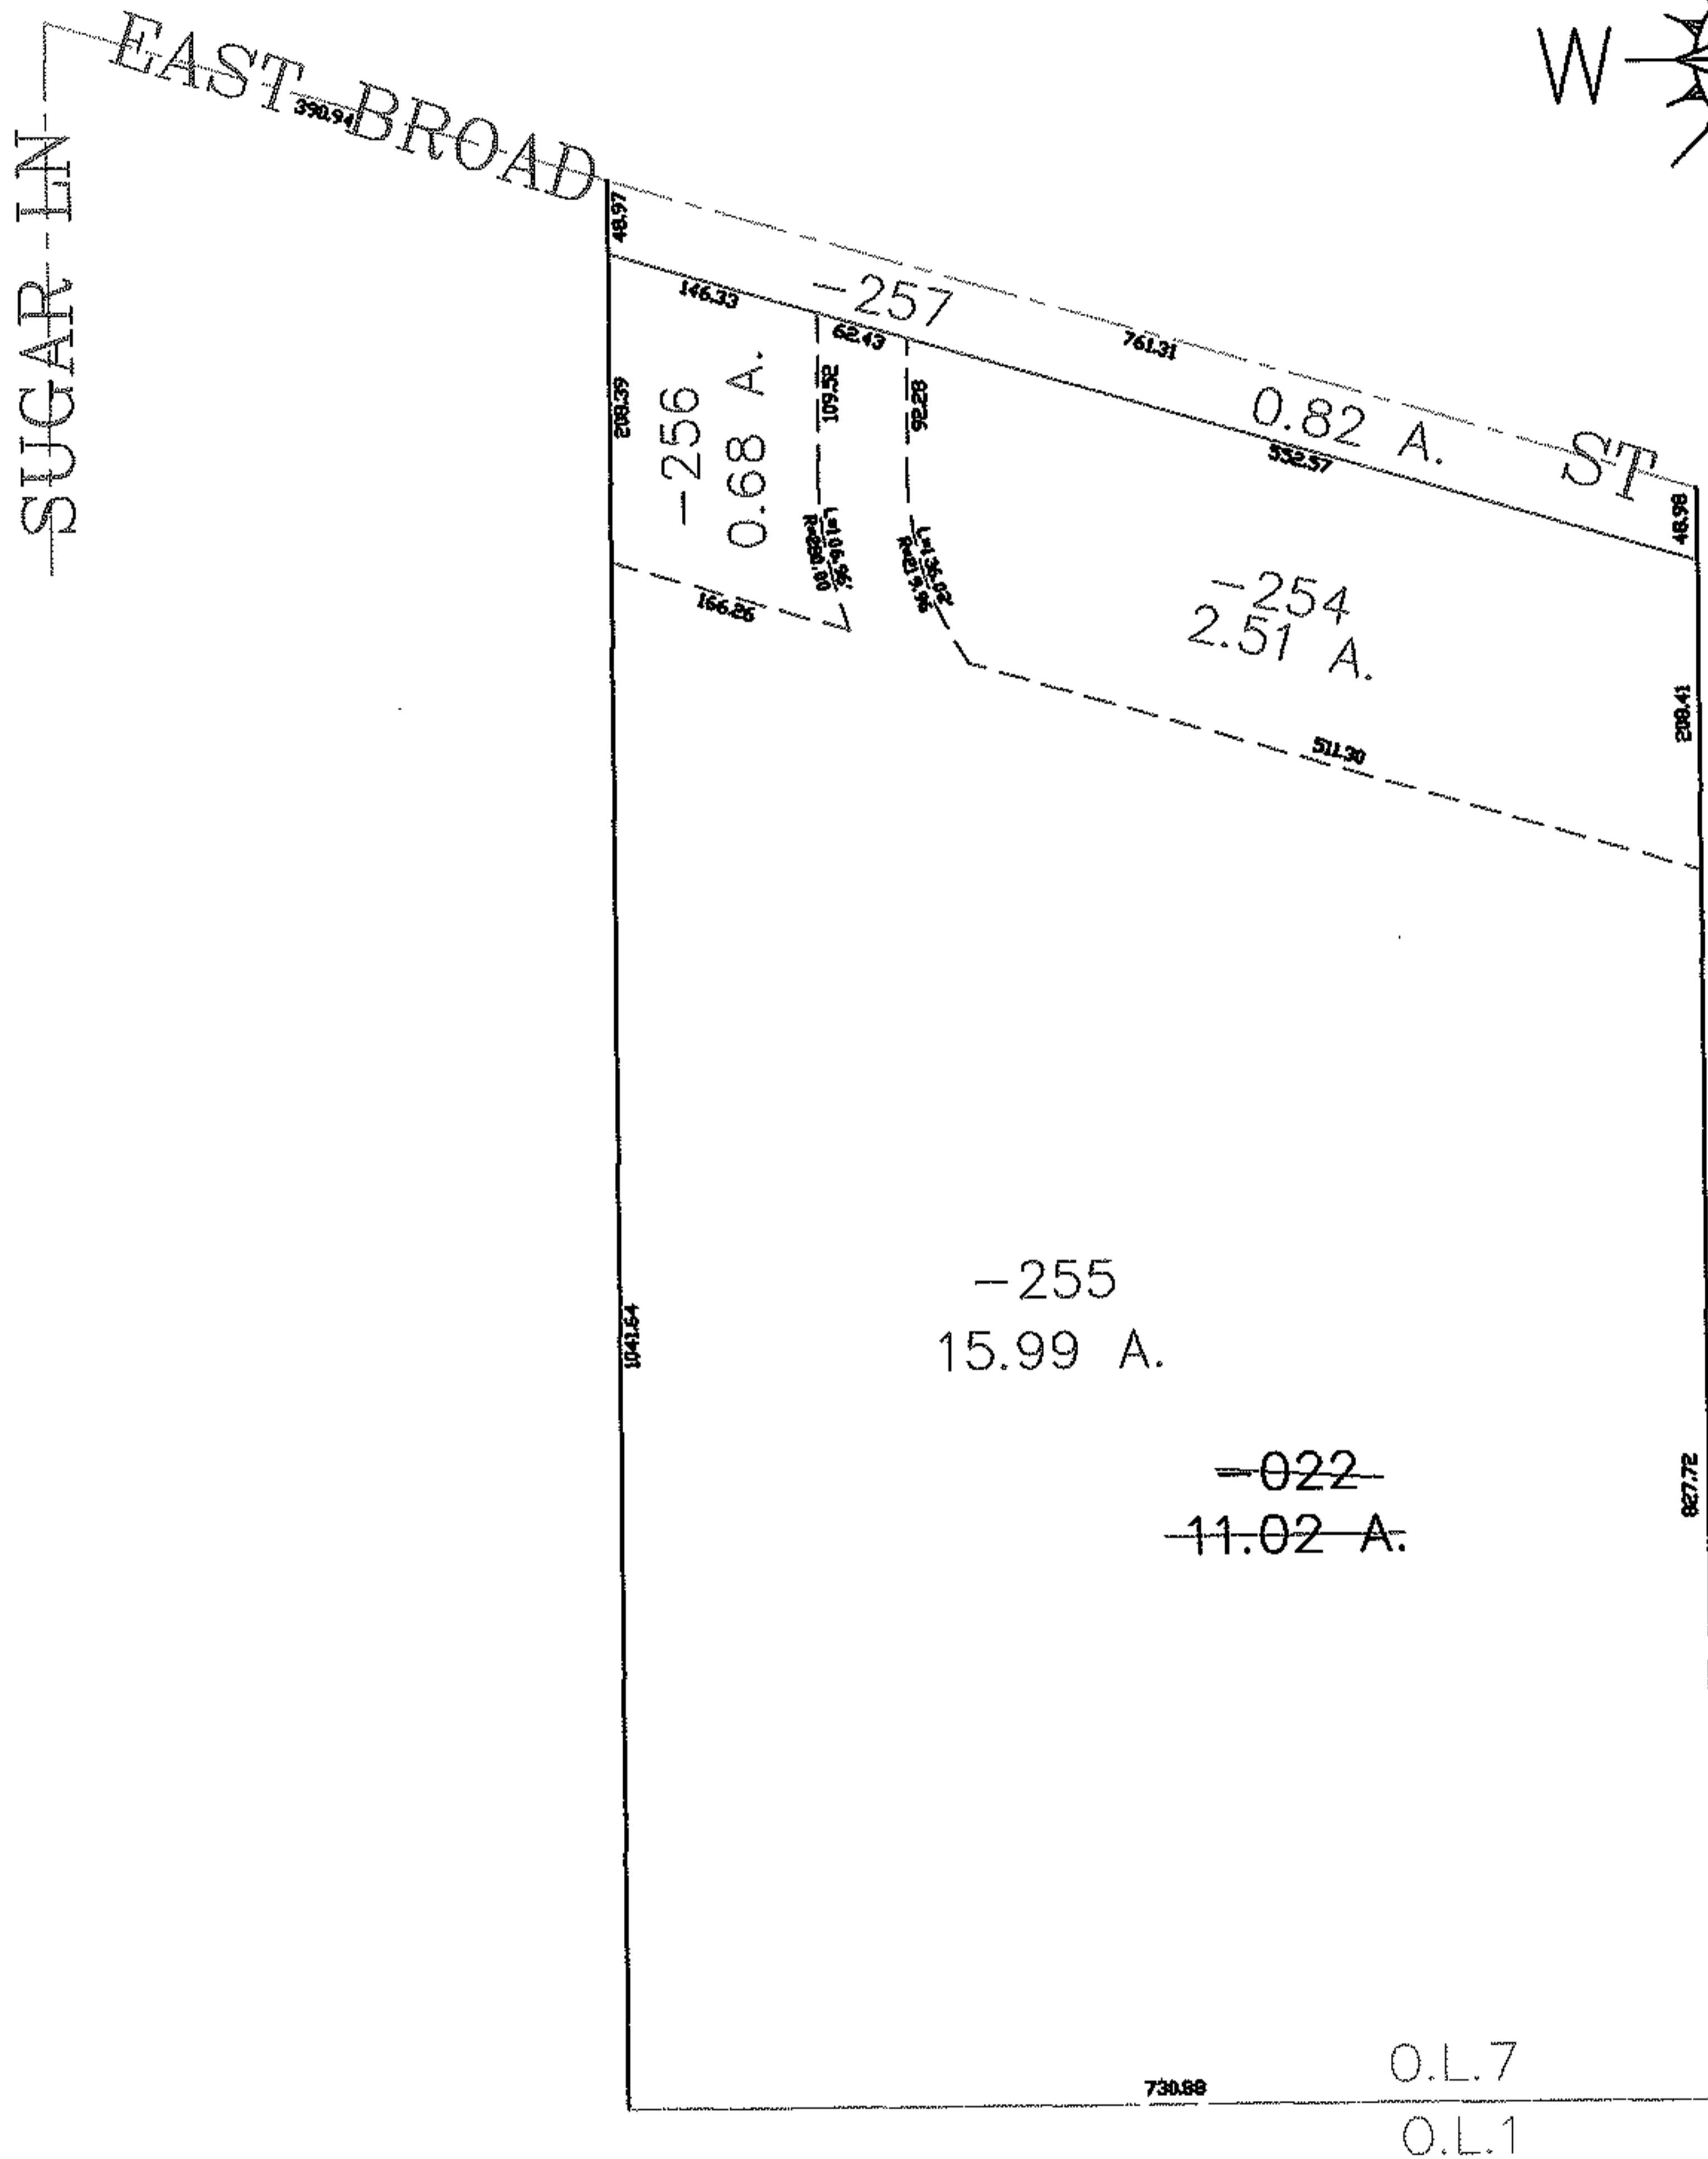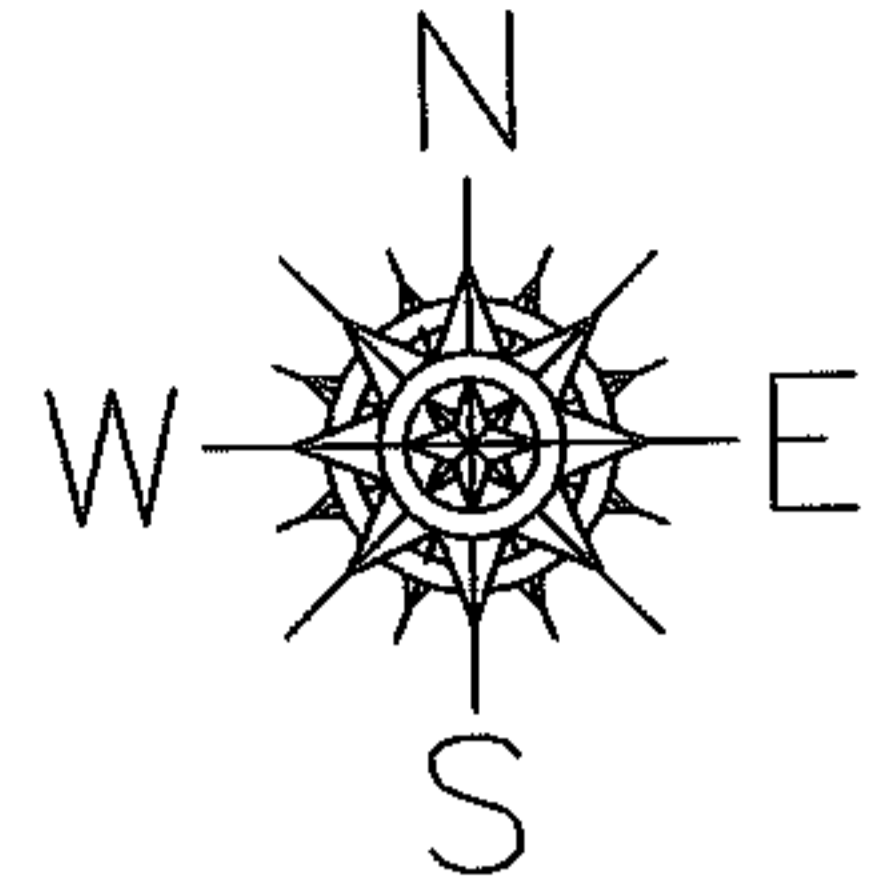

SPLITS/DEEDS PROCESSED
 LORAIN COUNTY TAX MAP DEPARTMENT
 226 MIDDLE AVE. ELYRIA, OHIO

SURVEYED BY: DAVID ELWELL
 CLOSURE: 0.00 : 10.000
 MAP PAGE(S): 6-126
 APPROVED BY: JAH DATE: 3-13-06
 SCALE: 1" = 200 PRIOR INSTRUMENT: OR 464/235