
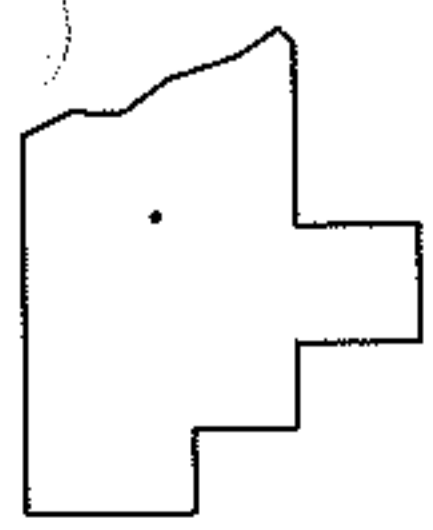
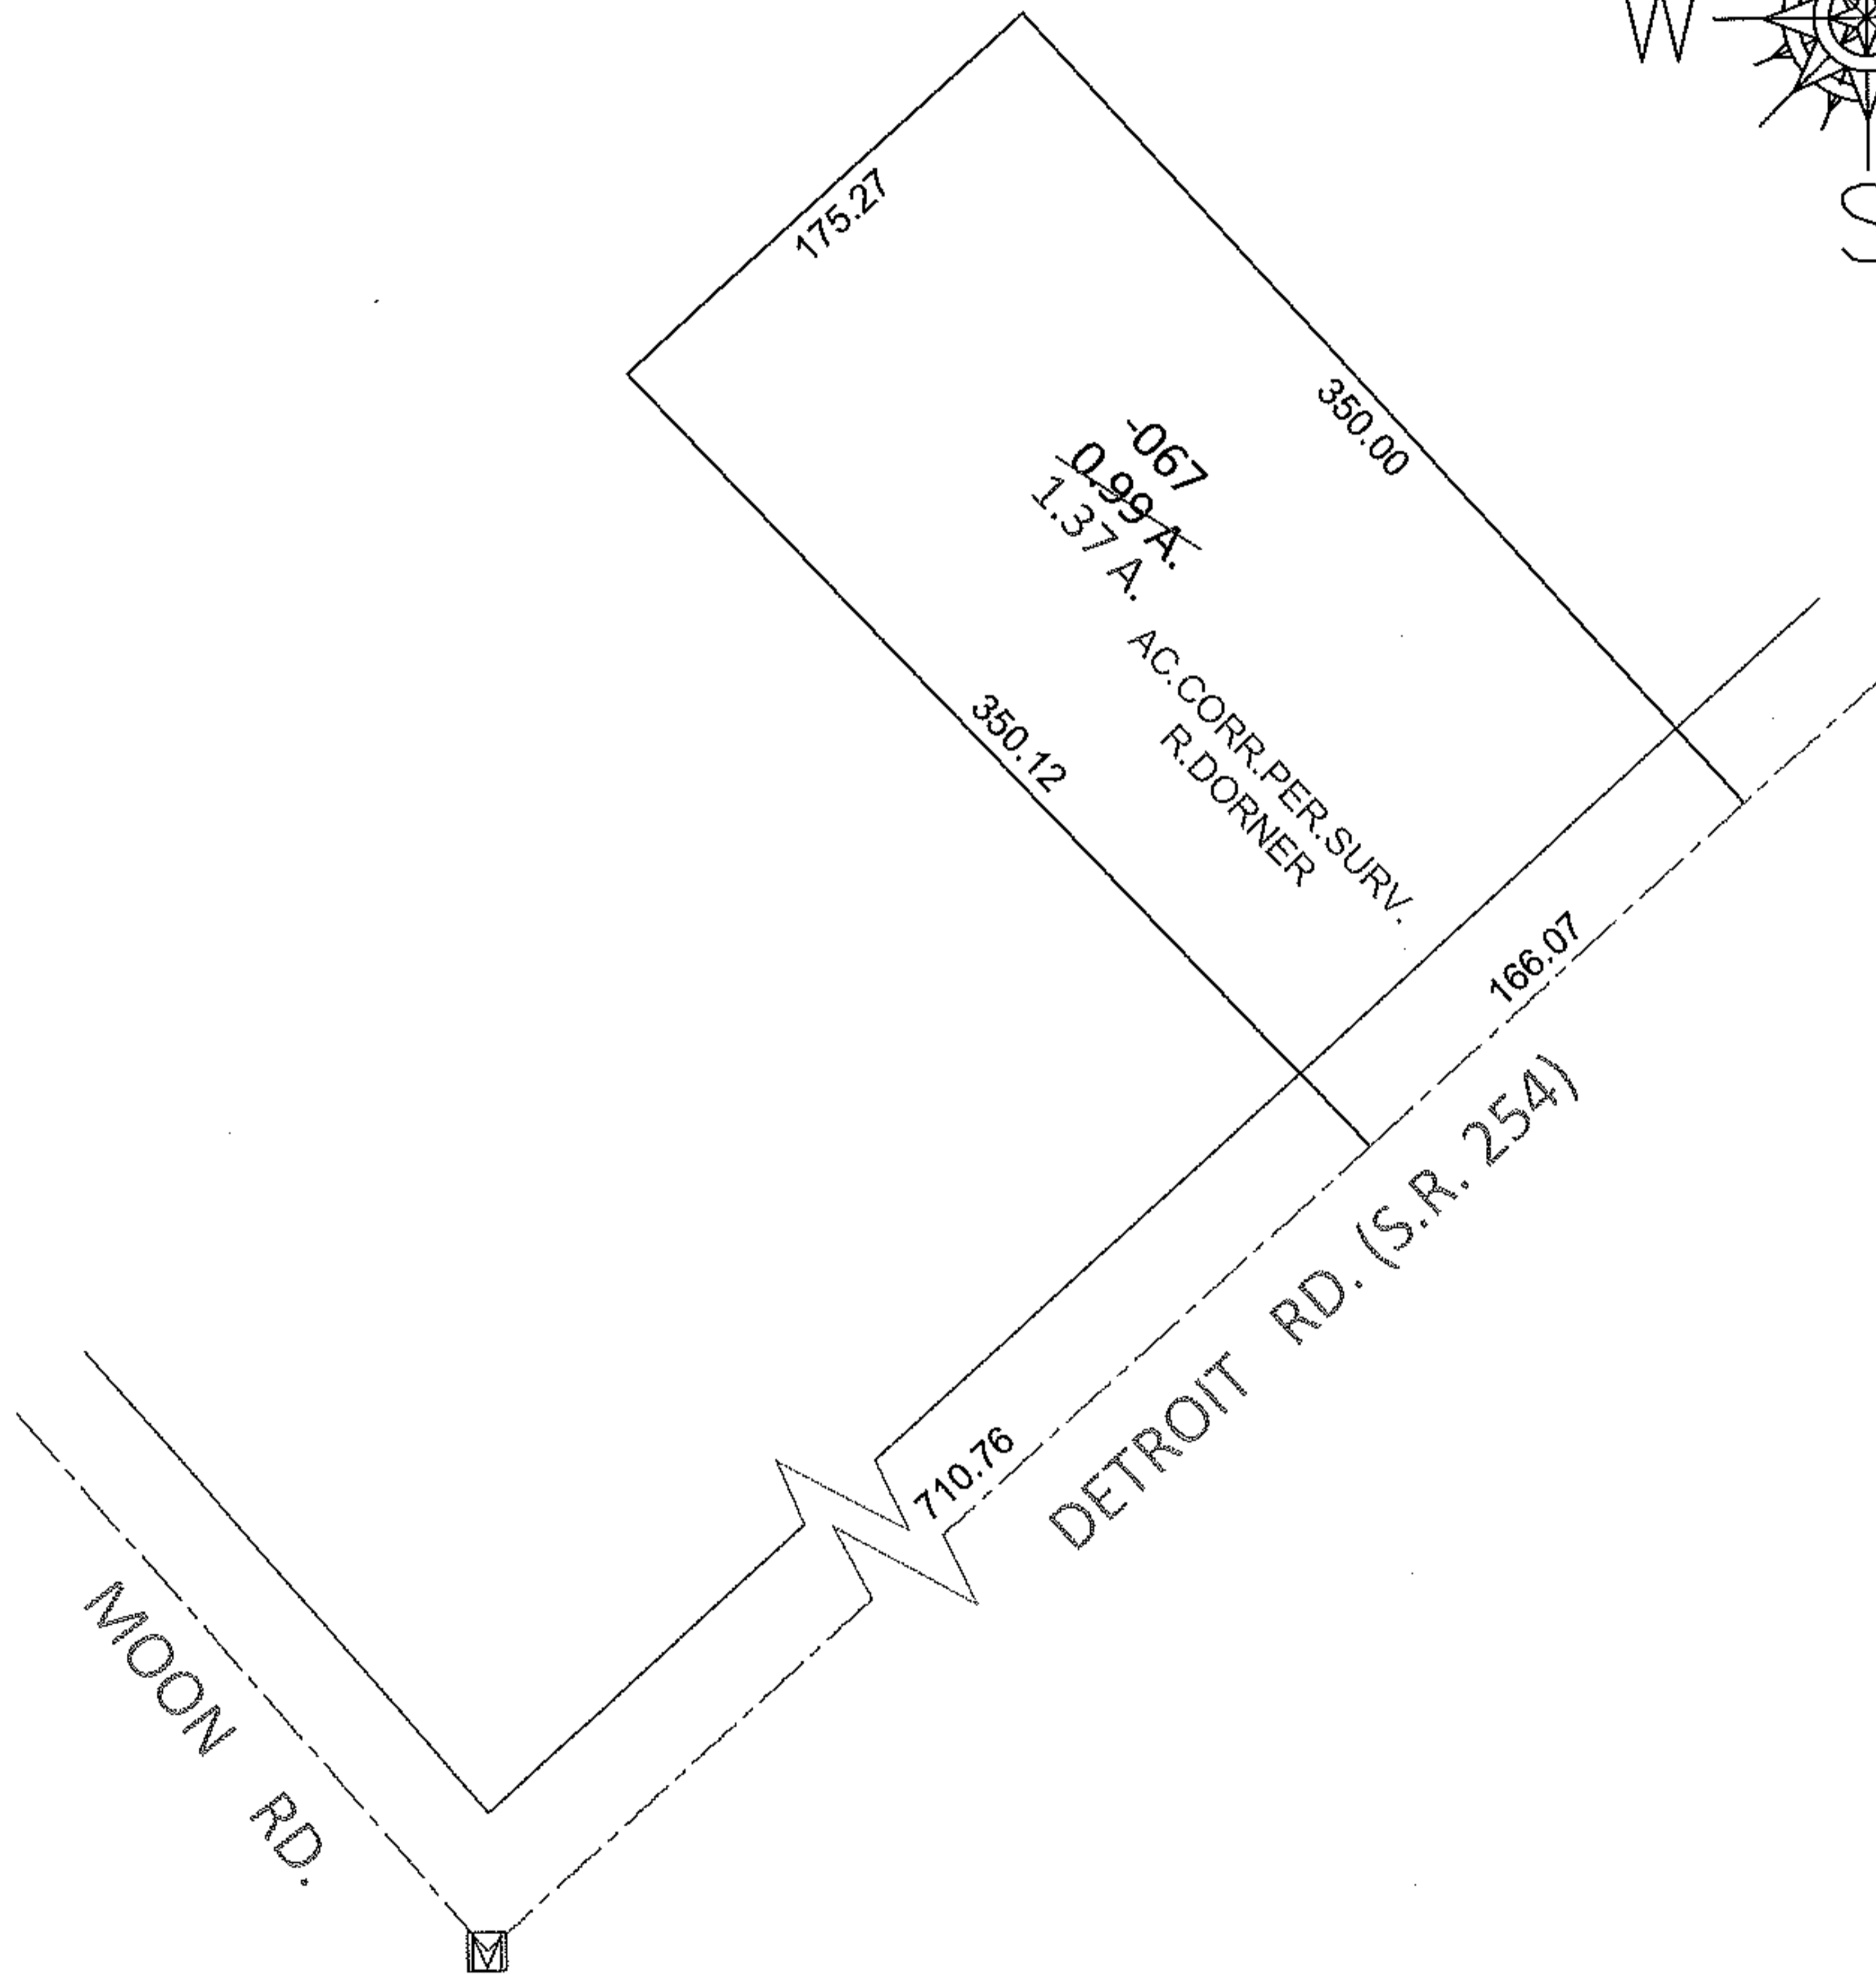


PARENT PARCEL: 04-00-002-102-067

10-02117-A

CHILD PARCEL: \_\_\_\_\_

STARTING POINT: AT A MON BOX AT INTERSECTION OF C/L OF MOON RD. AND C/L OF DETROIT RD.

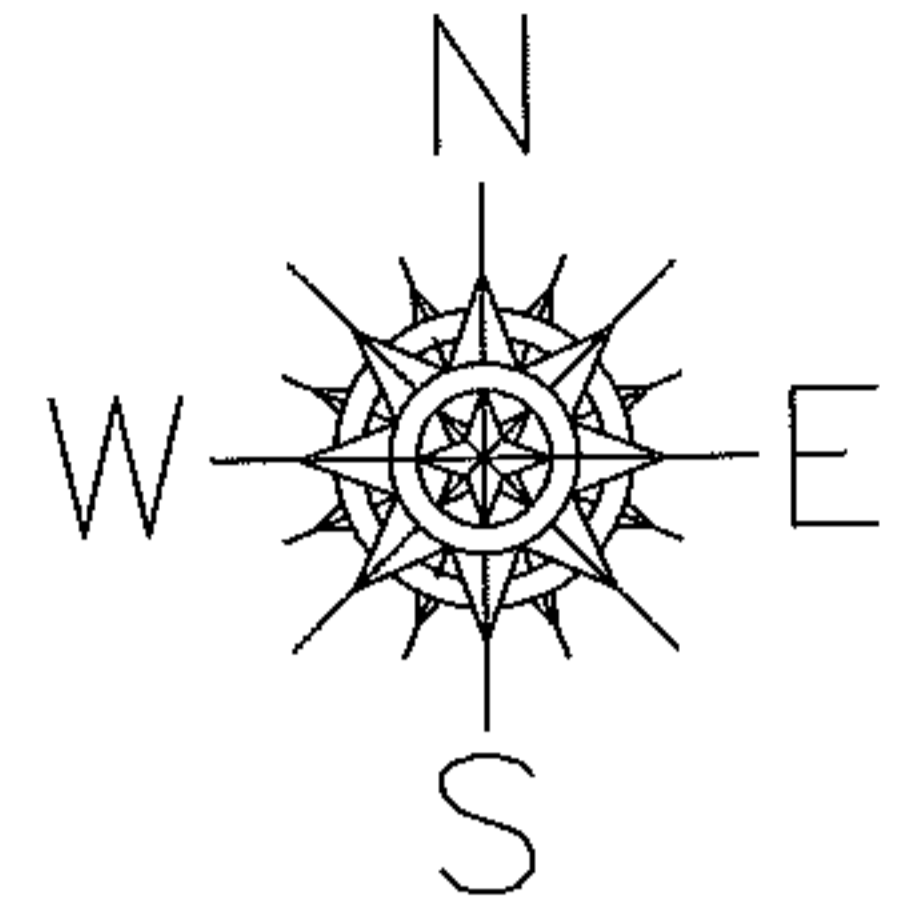

**SPLITS/DEEDS PROCESSED**

LORAIN COUNTY TAX MAP DEPARTMENT  
226 MIDDLE AVE. ELYRIA, OHIO

SURVEYED BY: ROBERT A. DORNER

CLOSURE: .01:10,000

MAP PAGE(S): 4-00-002-G

APPROVED BY: RRM DATE: 10-14-10

SCALE: 1"= 100 PRIOR INST.: DV 1093/253