


PARENT PARCEL: 17-07-017-000-001, 17-07-018-000-002, -005
CHILD PARCEL: _____
STARTING POINT: _____


10-02121-D

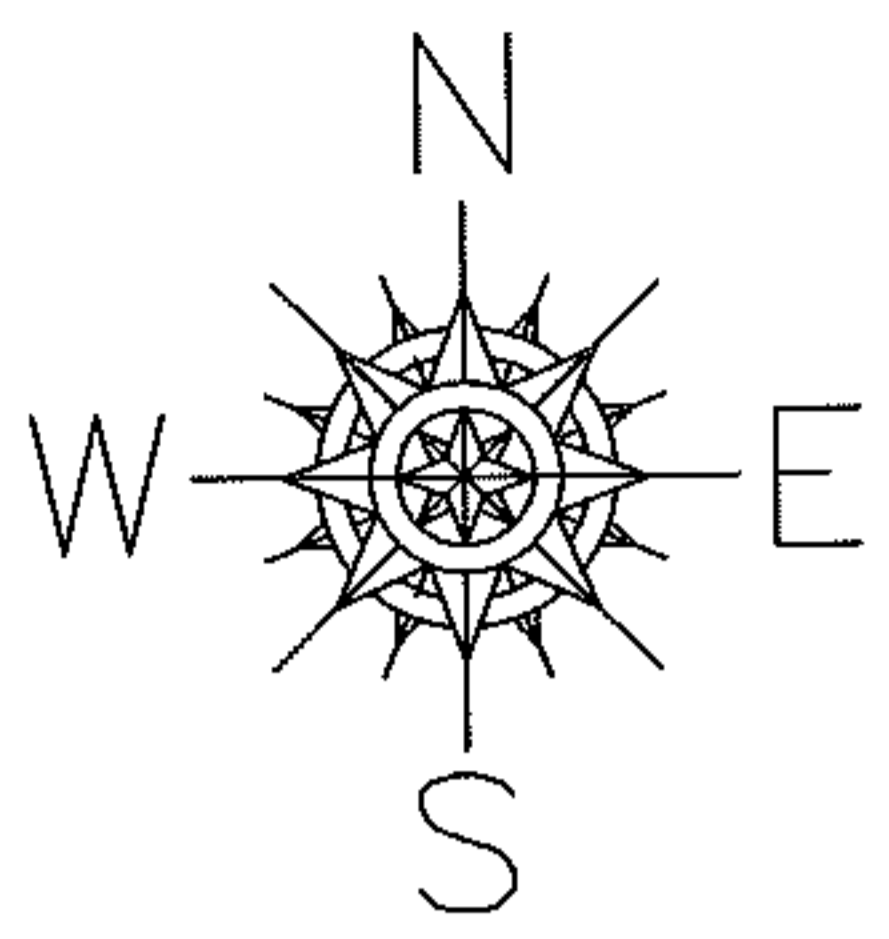

UPDATE LEGAL BEFORE NEXT TRANSFER

- 17-07-017-000-001
- 17-07-018-000-002
- 17-07-018-000-005

NEED ACREAGE BREAKDOWN AND
ACREAGE DOESN'T MATCH DUP.

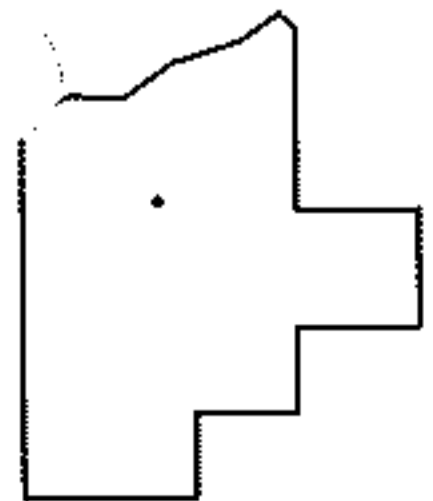

SPLITS/DEEDS PROCESSED
LORAIN COUNTY TAX MAP DEPARTMENT
226 MIDDLE AVE. ELYRIA, OHIO

SURVEYED BY: RICHARD A. FREDRICKSON
CLOSURE: N/A
MAP PAGE(S): 17-F, 17-07-017-A
APPROVED BY: RRM DATE: 10-28-10
SCALE: 1"= 100 PRIOR INST.: DV 916/777