

PARENT PARCEL: 06-22-018-121-032 THRU -034


CHILD PARCEL:

STARTING POINT: S/L'S 433 THRU 436 IN CLEARVIEW SUB.(VOL.10 PG.8)


10-02122-C

DEPTH CORRECTION

ADDITION OF VACATED ALLEY TO DEED  
VAC. ORD. 05-538  
PER INSTRUMENT 20100351771

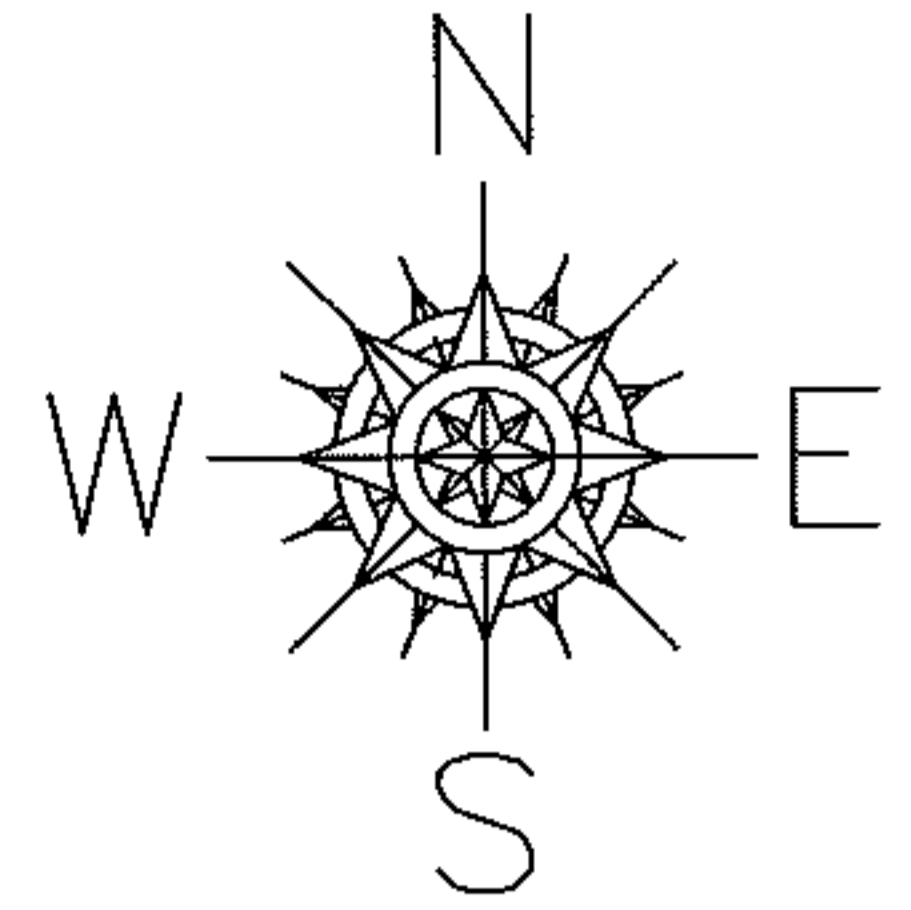

06-22-018-121-032	06-22-018-121-033
120.70	120.70
30 X 113	30 X 113
06-22-018-121-034	
120.70	
60 X 113	

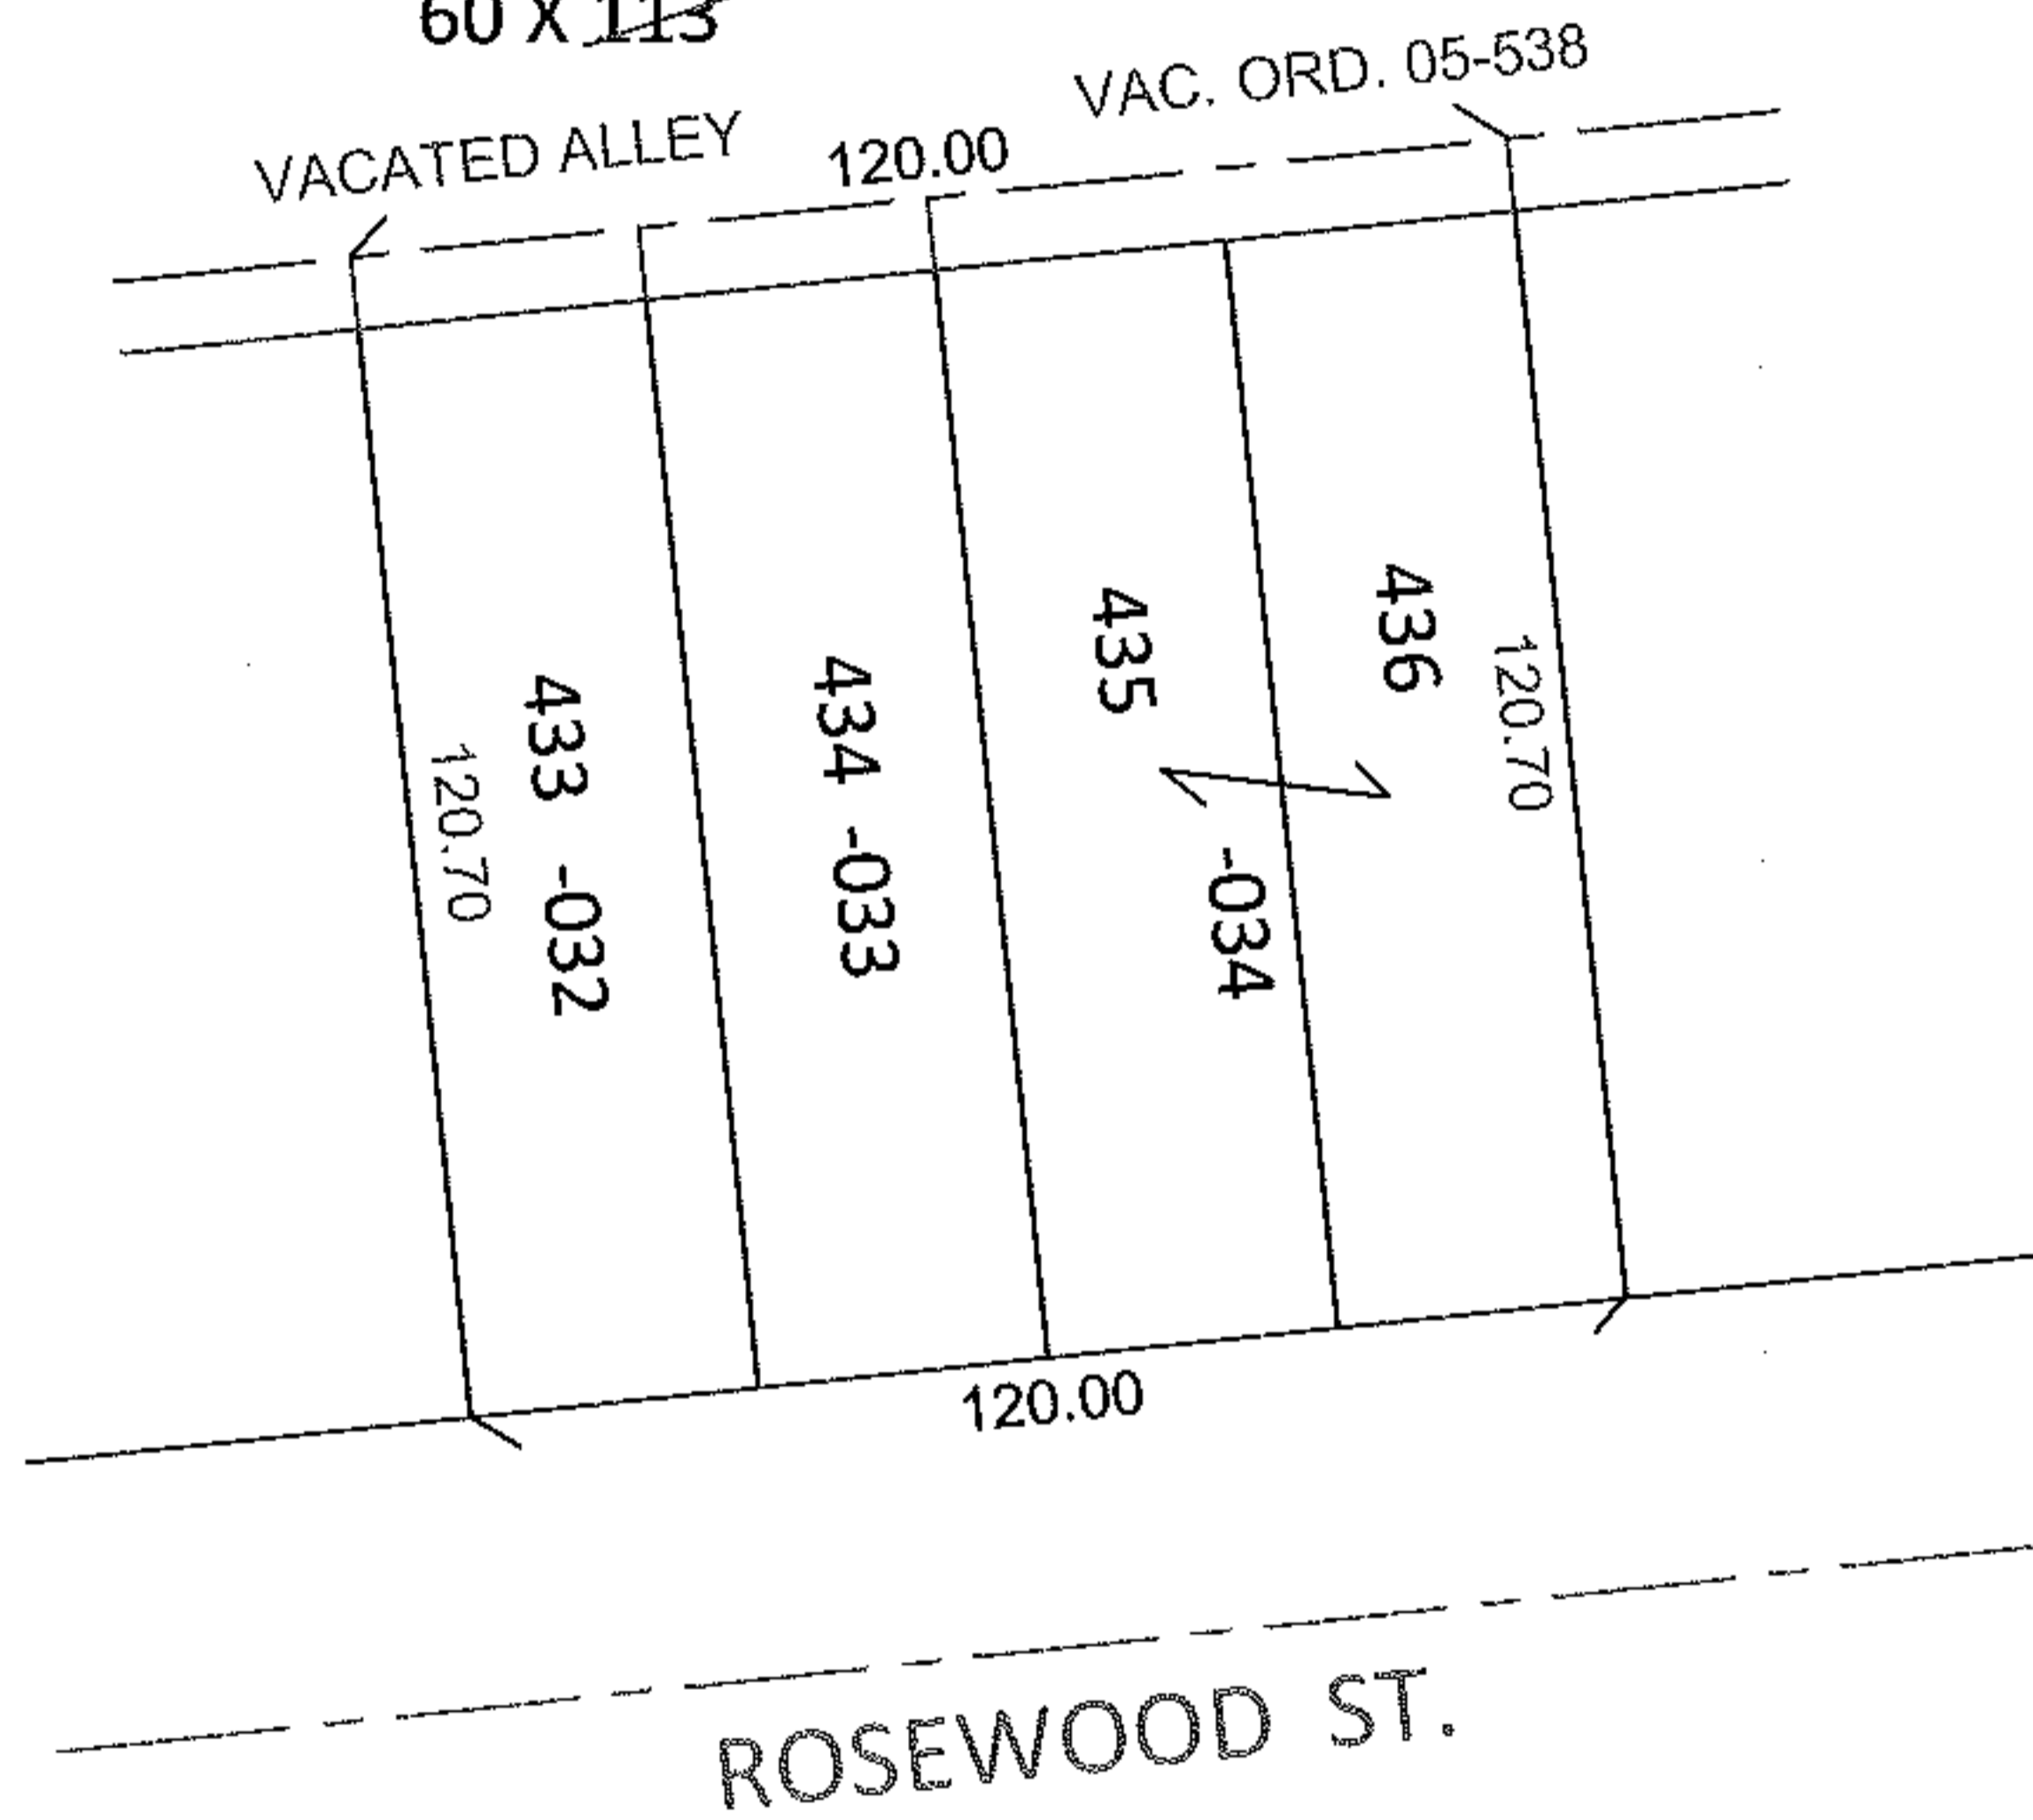

SPLITS/DEEDS PROCESSED

LORAIN COUNTY TAX MAP DEPARTMENT  
226 MIDDLE AVE. ELYRIA, OHIO

SURVEYED BY: N/A

CLOSURE: N/A

MAP PAGE(S): 6-8

APPROVED BY: RRM DATE: 11-3-10

SCALE: 1" = 50'

PRIOR INST.: 20090312756

