
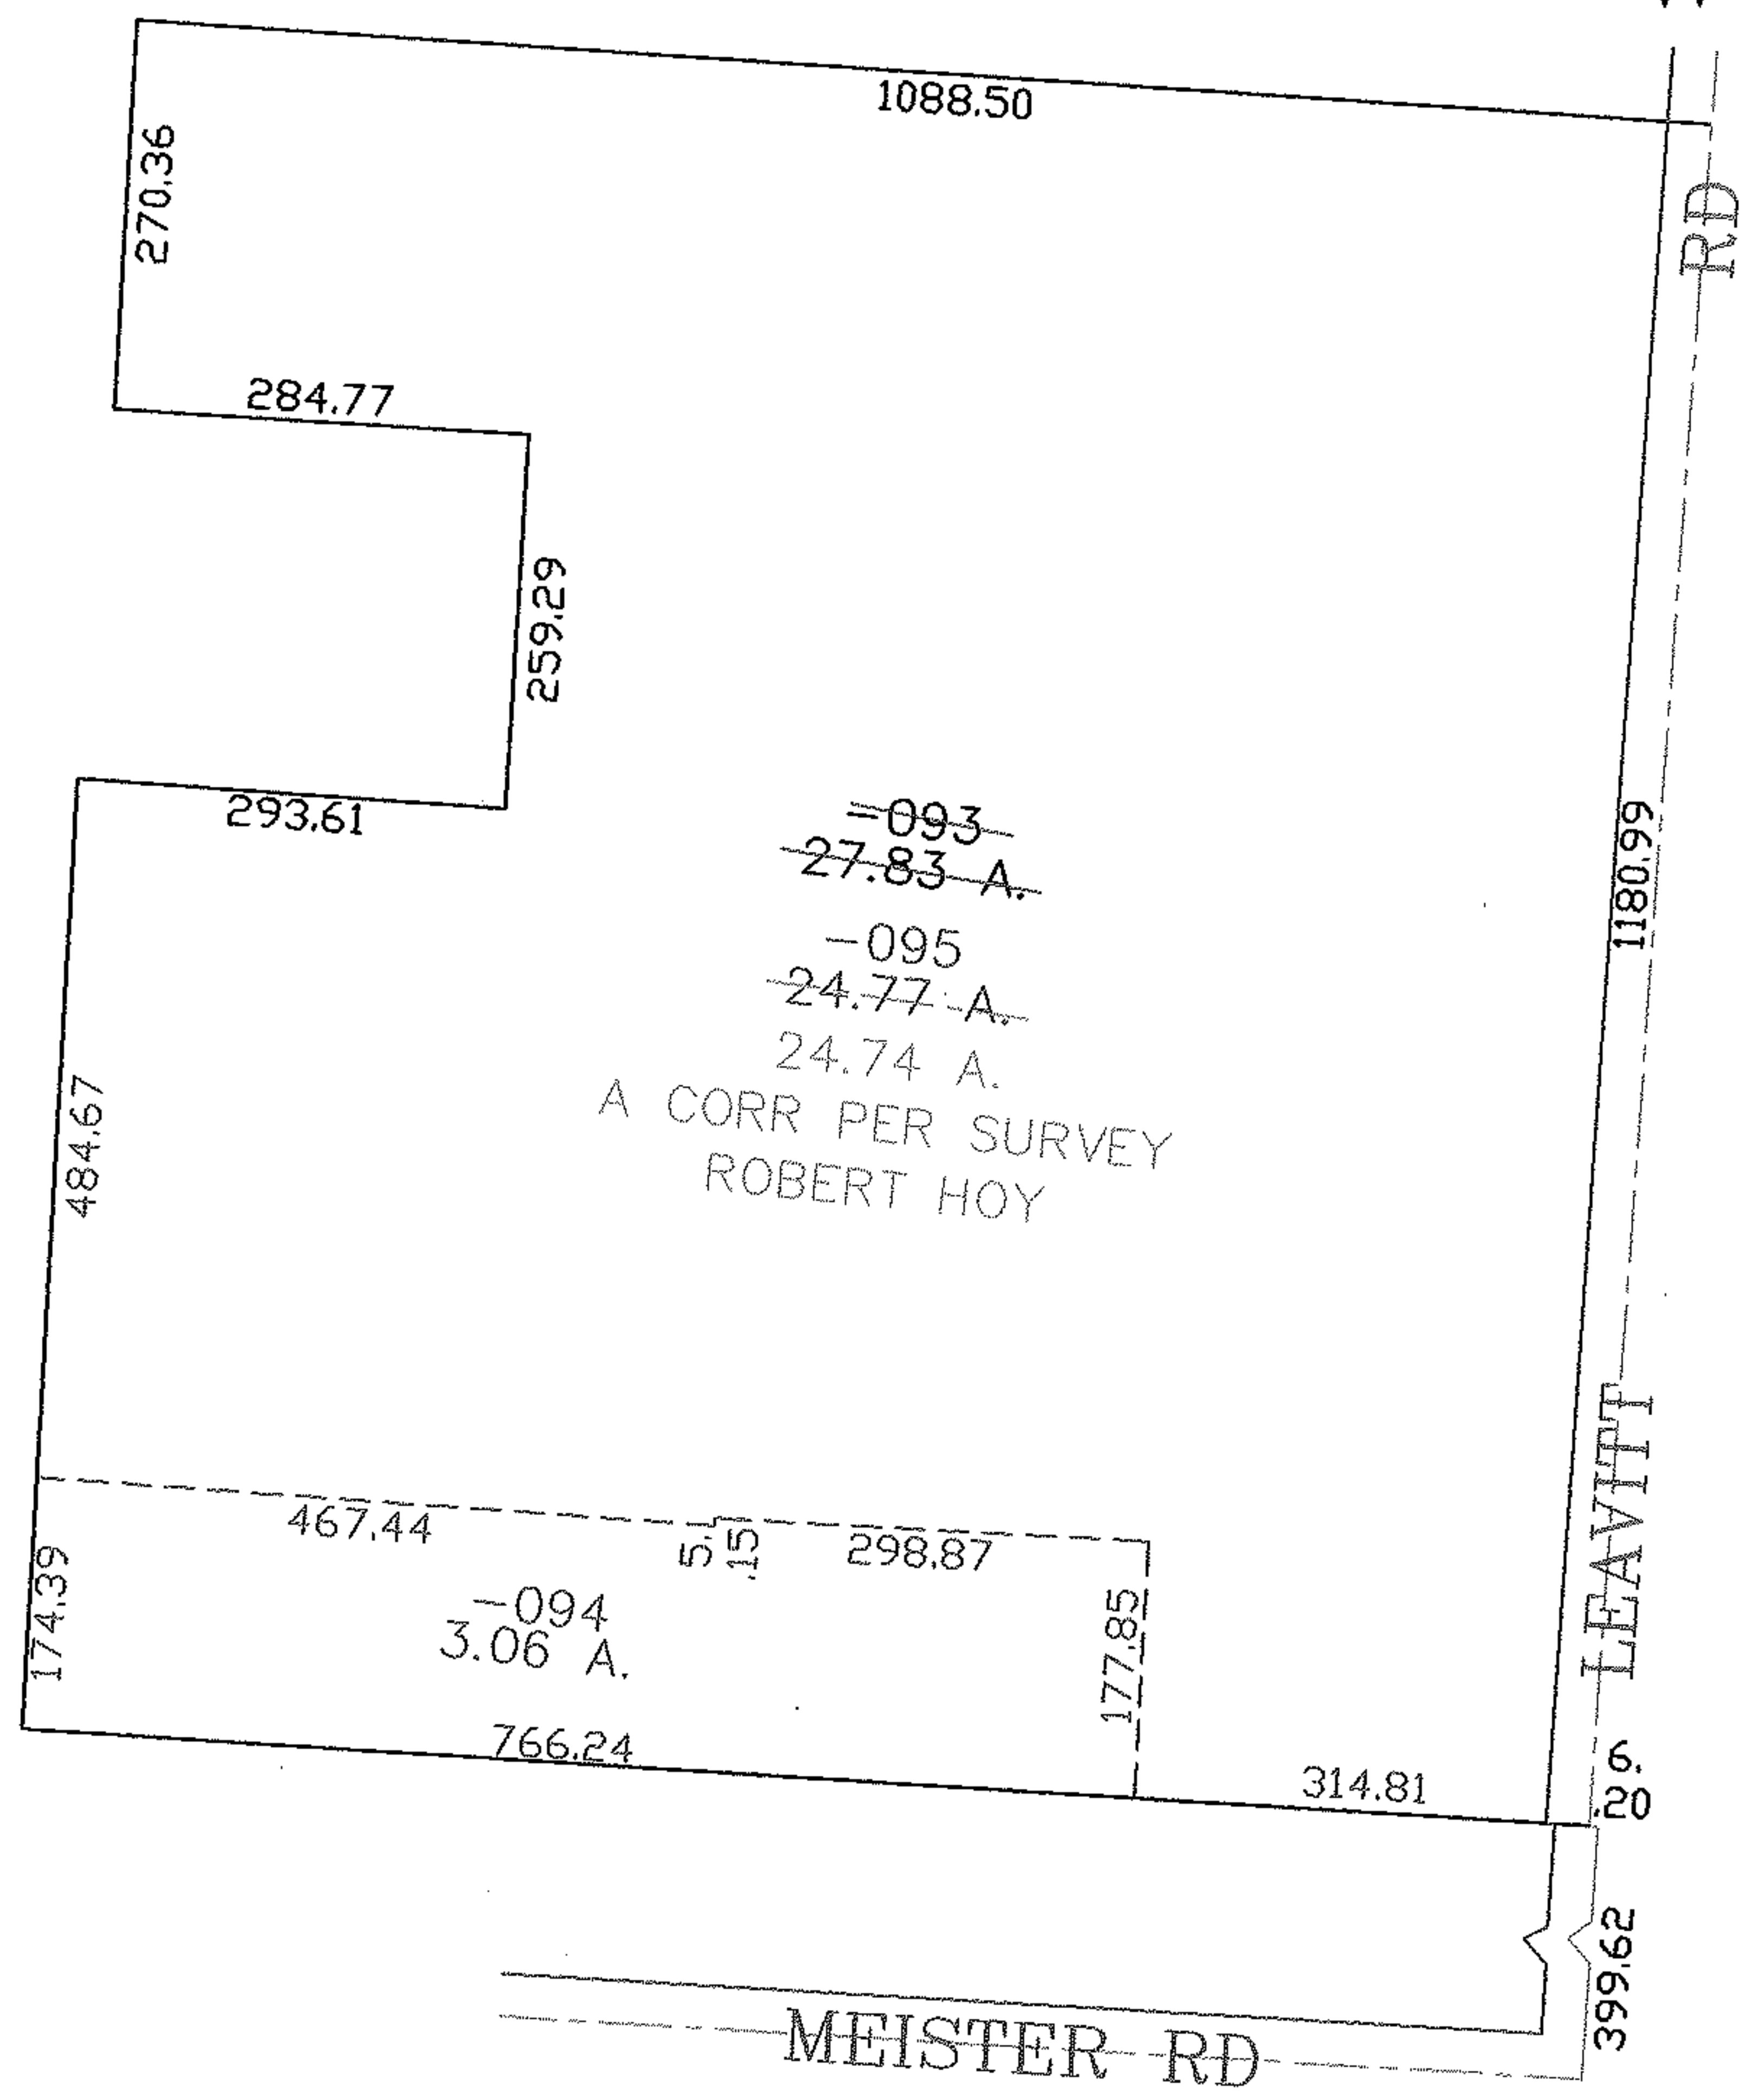


PARENT PARCEL: 02-02-018-000-093
CHILD PARCEL: 02-02-018-000-094, -095
STARTING POINT: CENTERLINE OF MEISTER RD & LEAVITT RD


06-02122

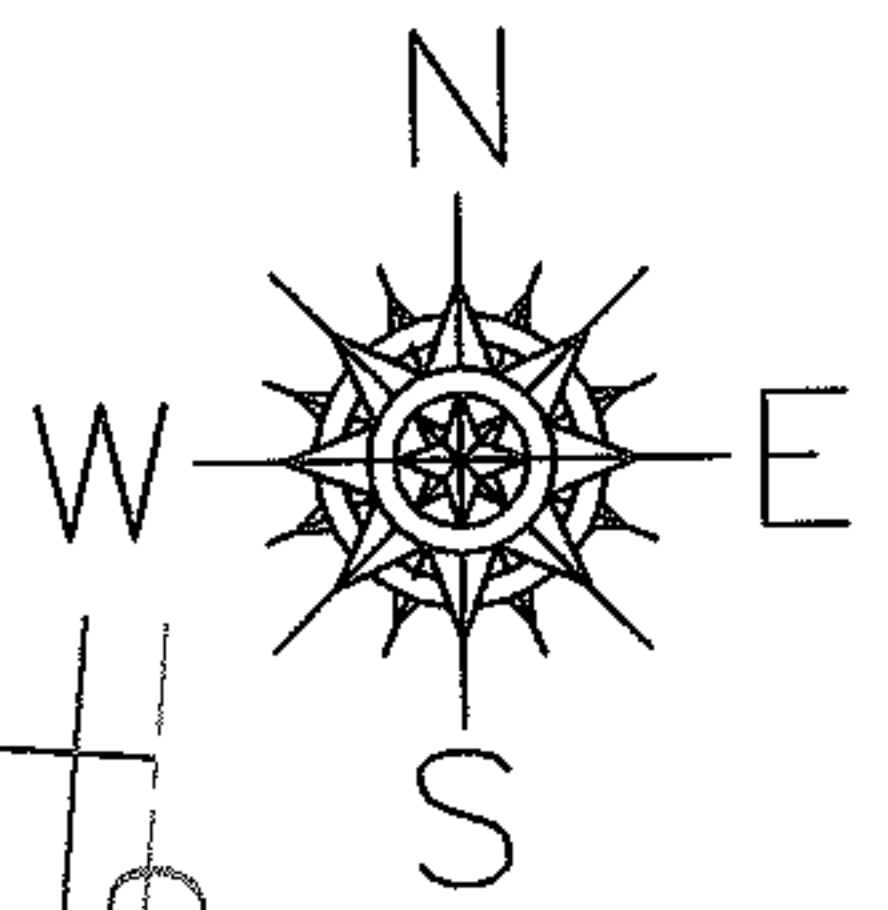

~~=093~~
~~27.83 A.~~
~~-095~~
~~24.77 A.~~
24.74 A.
A CORR PER SURVEY
ROBERT HOY

~~-094~~
3.06 A.

SURVEYED BY: ROBERT HOY
CLOSURE: 0.00 : 10,000
MAP PAGE(S): 02-02-018-B
APPROVED BY: JAH DATE: 3-22-06
SCALE: 1" = 200 PRIOR INSTRUMENT: DV 1420/263

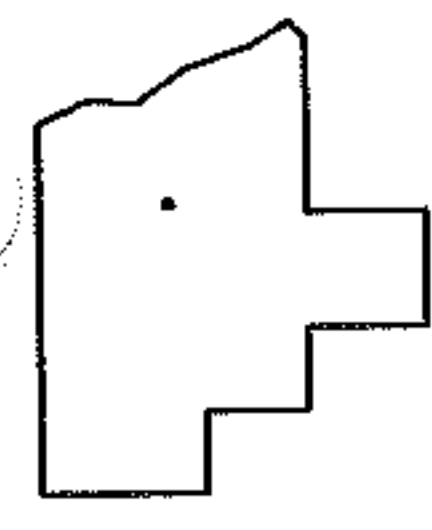

SPLITS/DEEDS PROCESSED
LORAIN COUNTY TAX MAP DEPARTMENT
226 MIDDLE AVE. ELYRIA, OHIO