


PARENT PARCEL: 10-00-016-000-051, & -016

CHILD PARCEL: XX-XX-XXX-XXX-XXX

STARTING POINT: XXXXXX

10-02123-C

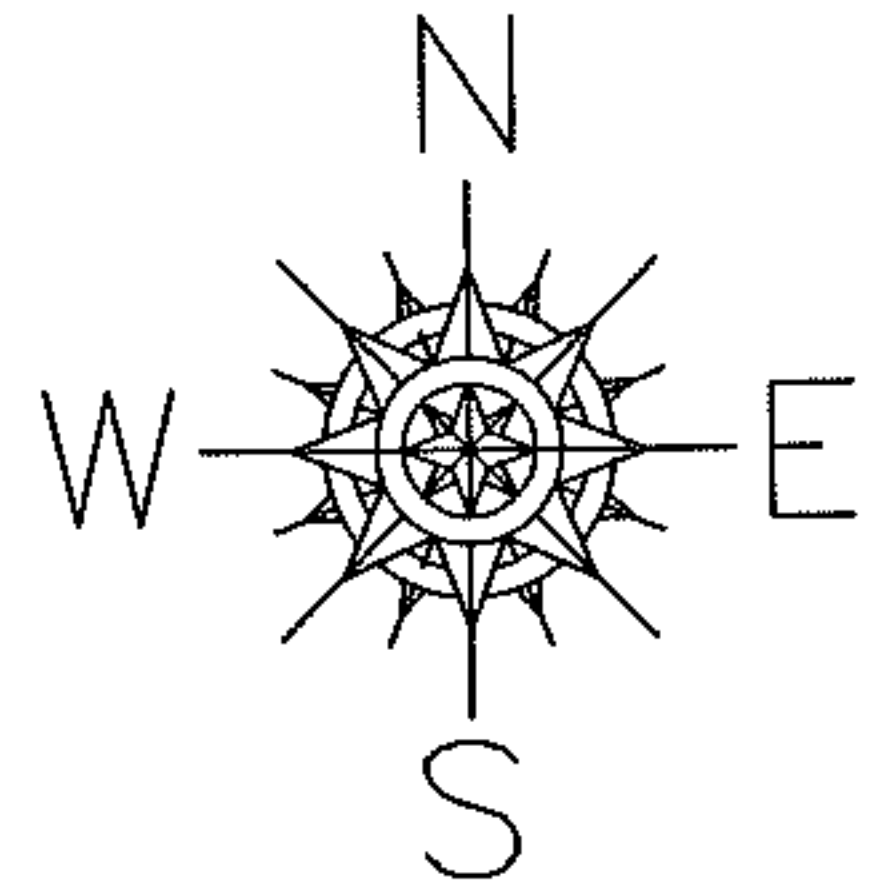

SURVEY BEFORE NEXT TRANSFER

10-00-016-000-016

1.04 A.

DOESN'T CLOSE

ACREAGE CORRECTION


10-00-016-000-051

~~2.96 A.~~

3.10 A.

CORR. PER SURV.

GARY E. PENFOUND

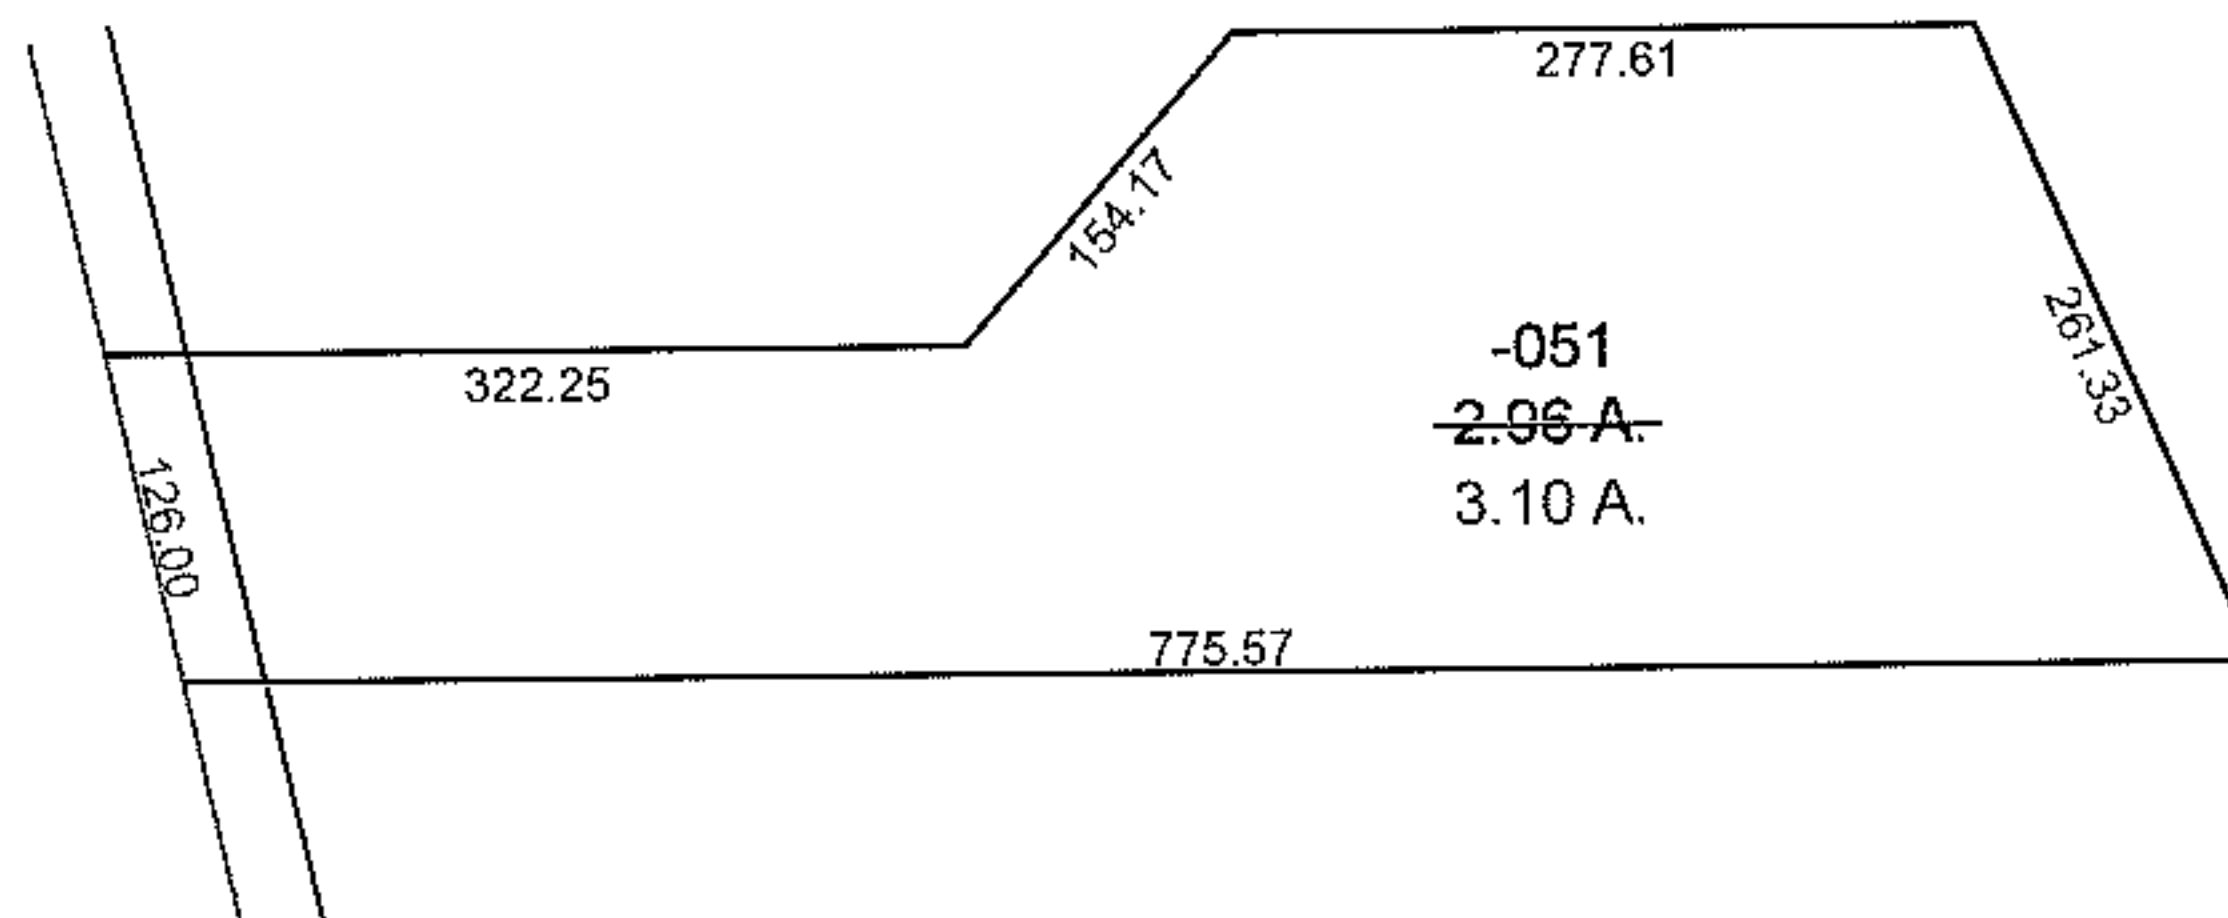

SPLITS/DEEDS PROCESSED

LORAIN COUNTY TAX MAP DEPARTMENT
226 MIDDLE AVE. ELYRIA, OHIO

SURVEYED BY: GARY E. PENFOUND

CLOSURE: 0.01 : 10.000

MAP PAGE(S): 10-00-016-A

APPROVED BY: TJS DATE: 11/1/10

SCALE: 1" = 200 PRIOR INSTRUMENT: DV XXXX/XXX