

PARENT PARCEL: 02-03-001-111-022

CHILD PARCEL: 02-03-001-111-023, -024

STARTING POINT: CENTERLINE OF MORNINGSIDE WAY & CARDINAL CT.

06 - 02124

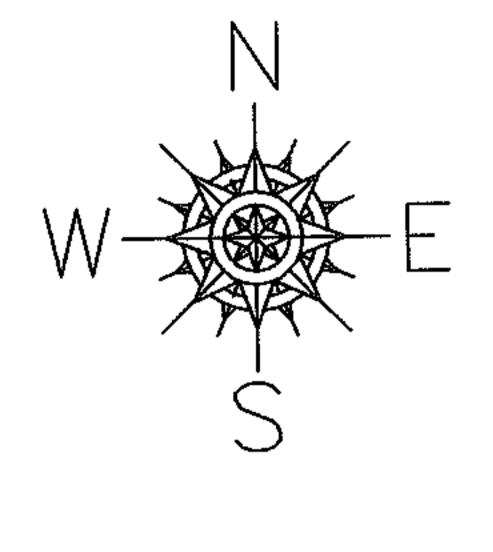

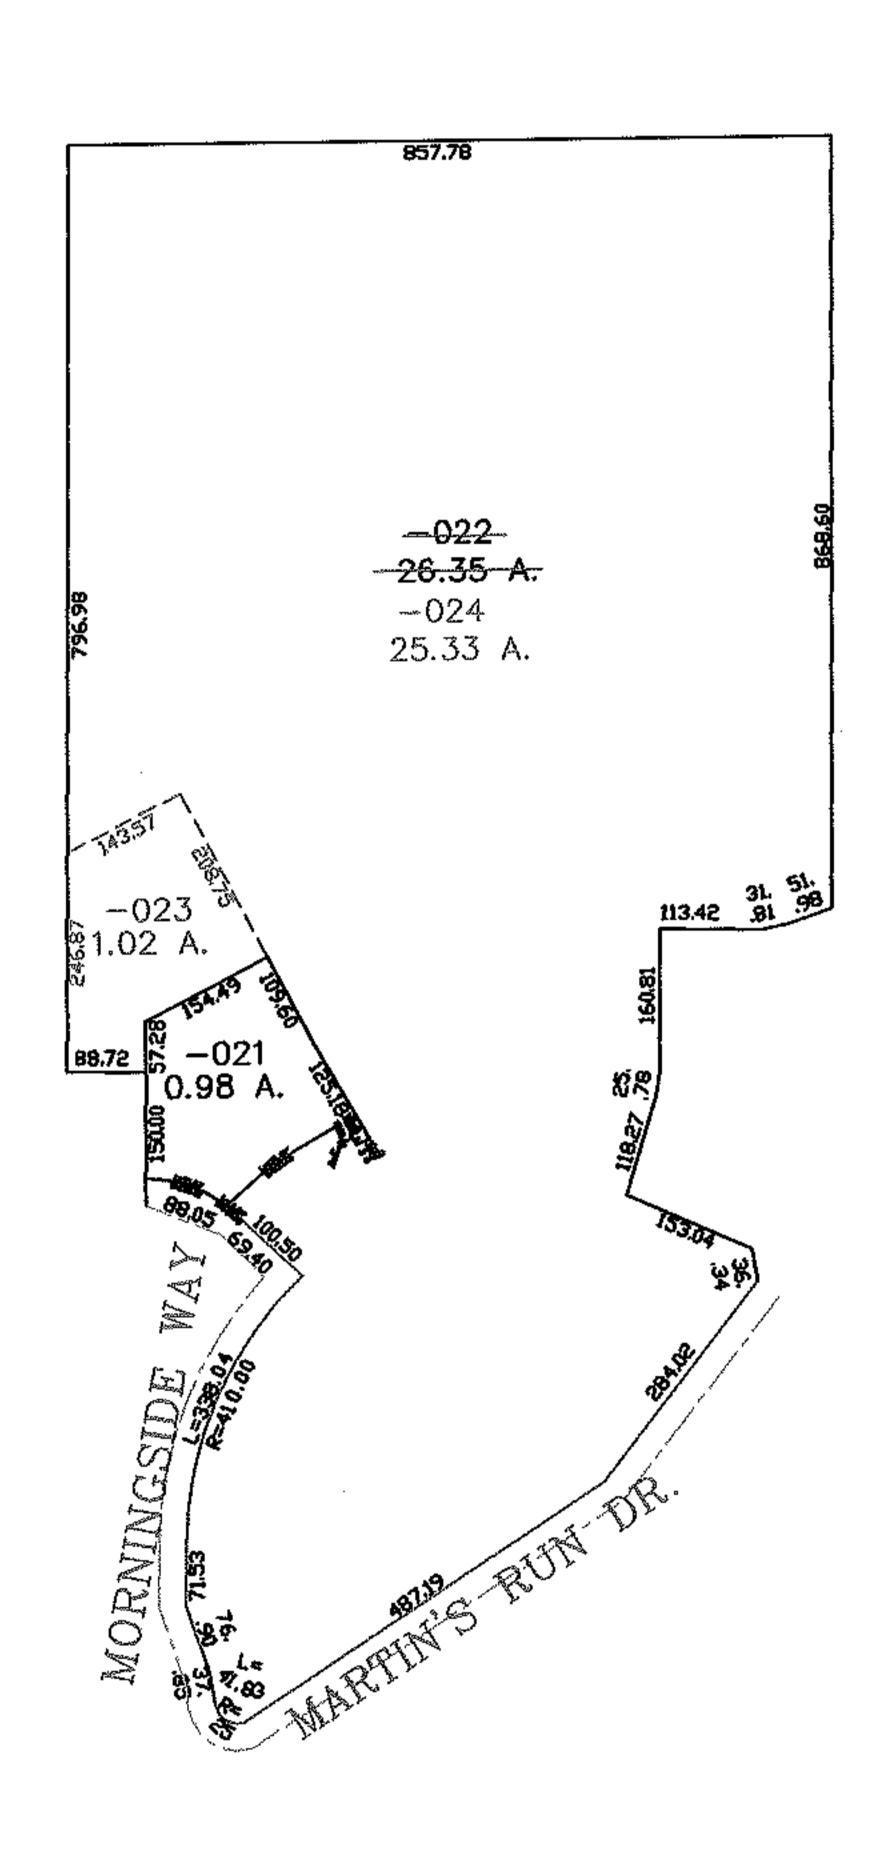

SPLITS/DEEDS PROCESSED

AIN COUNTY TAX MAP DEPARTMENT

LORAIN COUNTY TAX MAP DEPARTMENT 226 MIDDLE AVE. ELYRIA, OHIO

SURVEYED BY: DAVID ELWELL

CLOSURE: 0.00 : 10,000

MAP PAGE(S): 02-03-001-B

APPROVED BY: JAH DATE: 3-23-06

SCALE: 1"= 300 PRIOR INSTRUMENT: 20040006210