




RASTER

PARENT PARCEL: 04-00-003-103-029

CHILD PARCEL: 04-00-003-103-043, -044

STARTING POINT: SIDELINE OF FRENCH CREEK RD & O.L. 3

06-02125

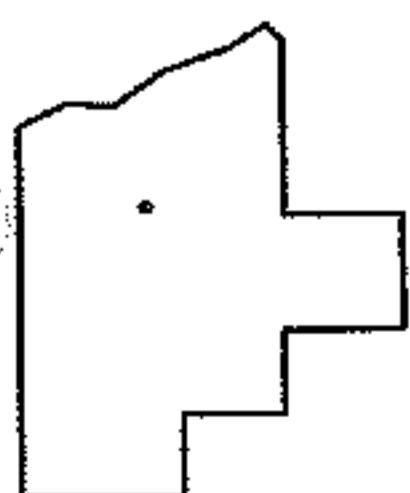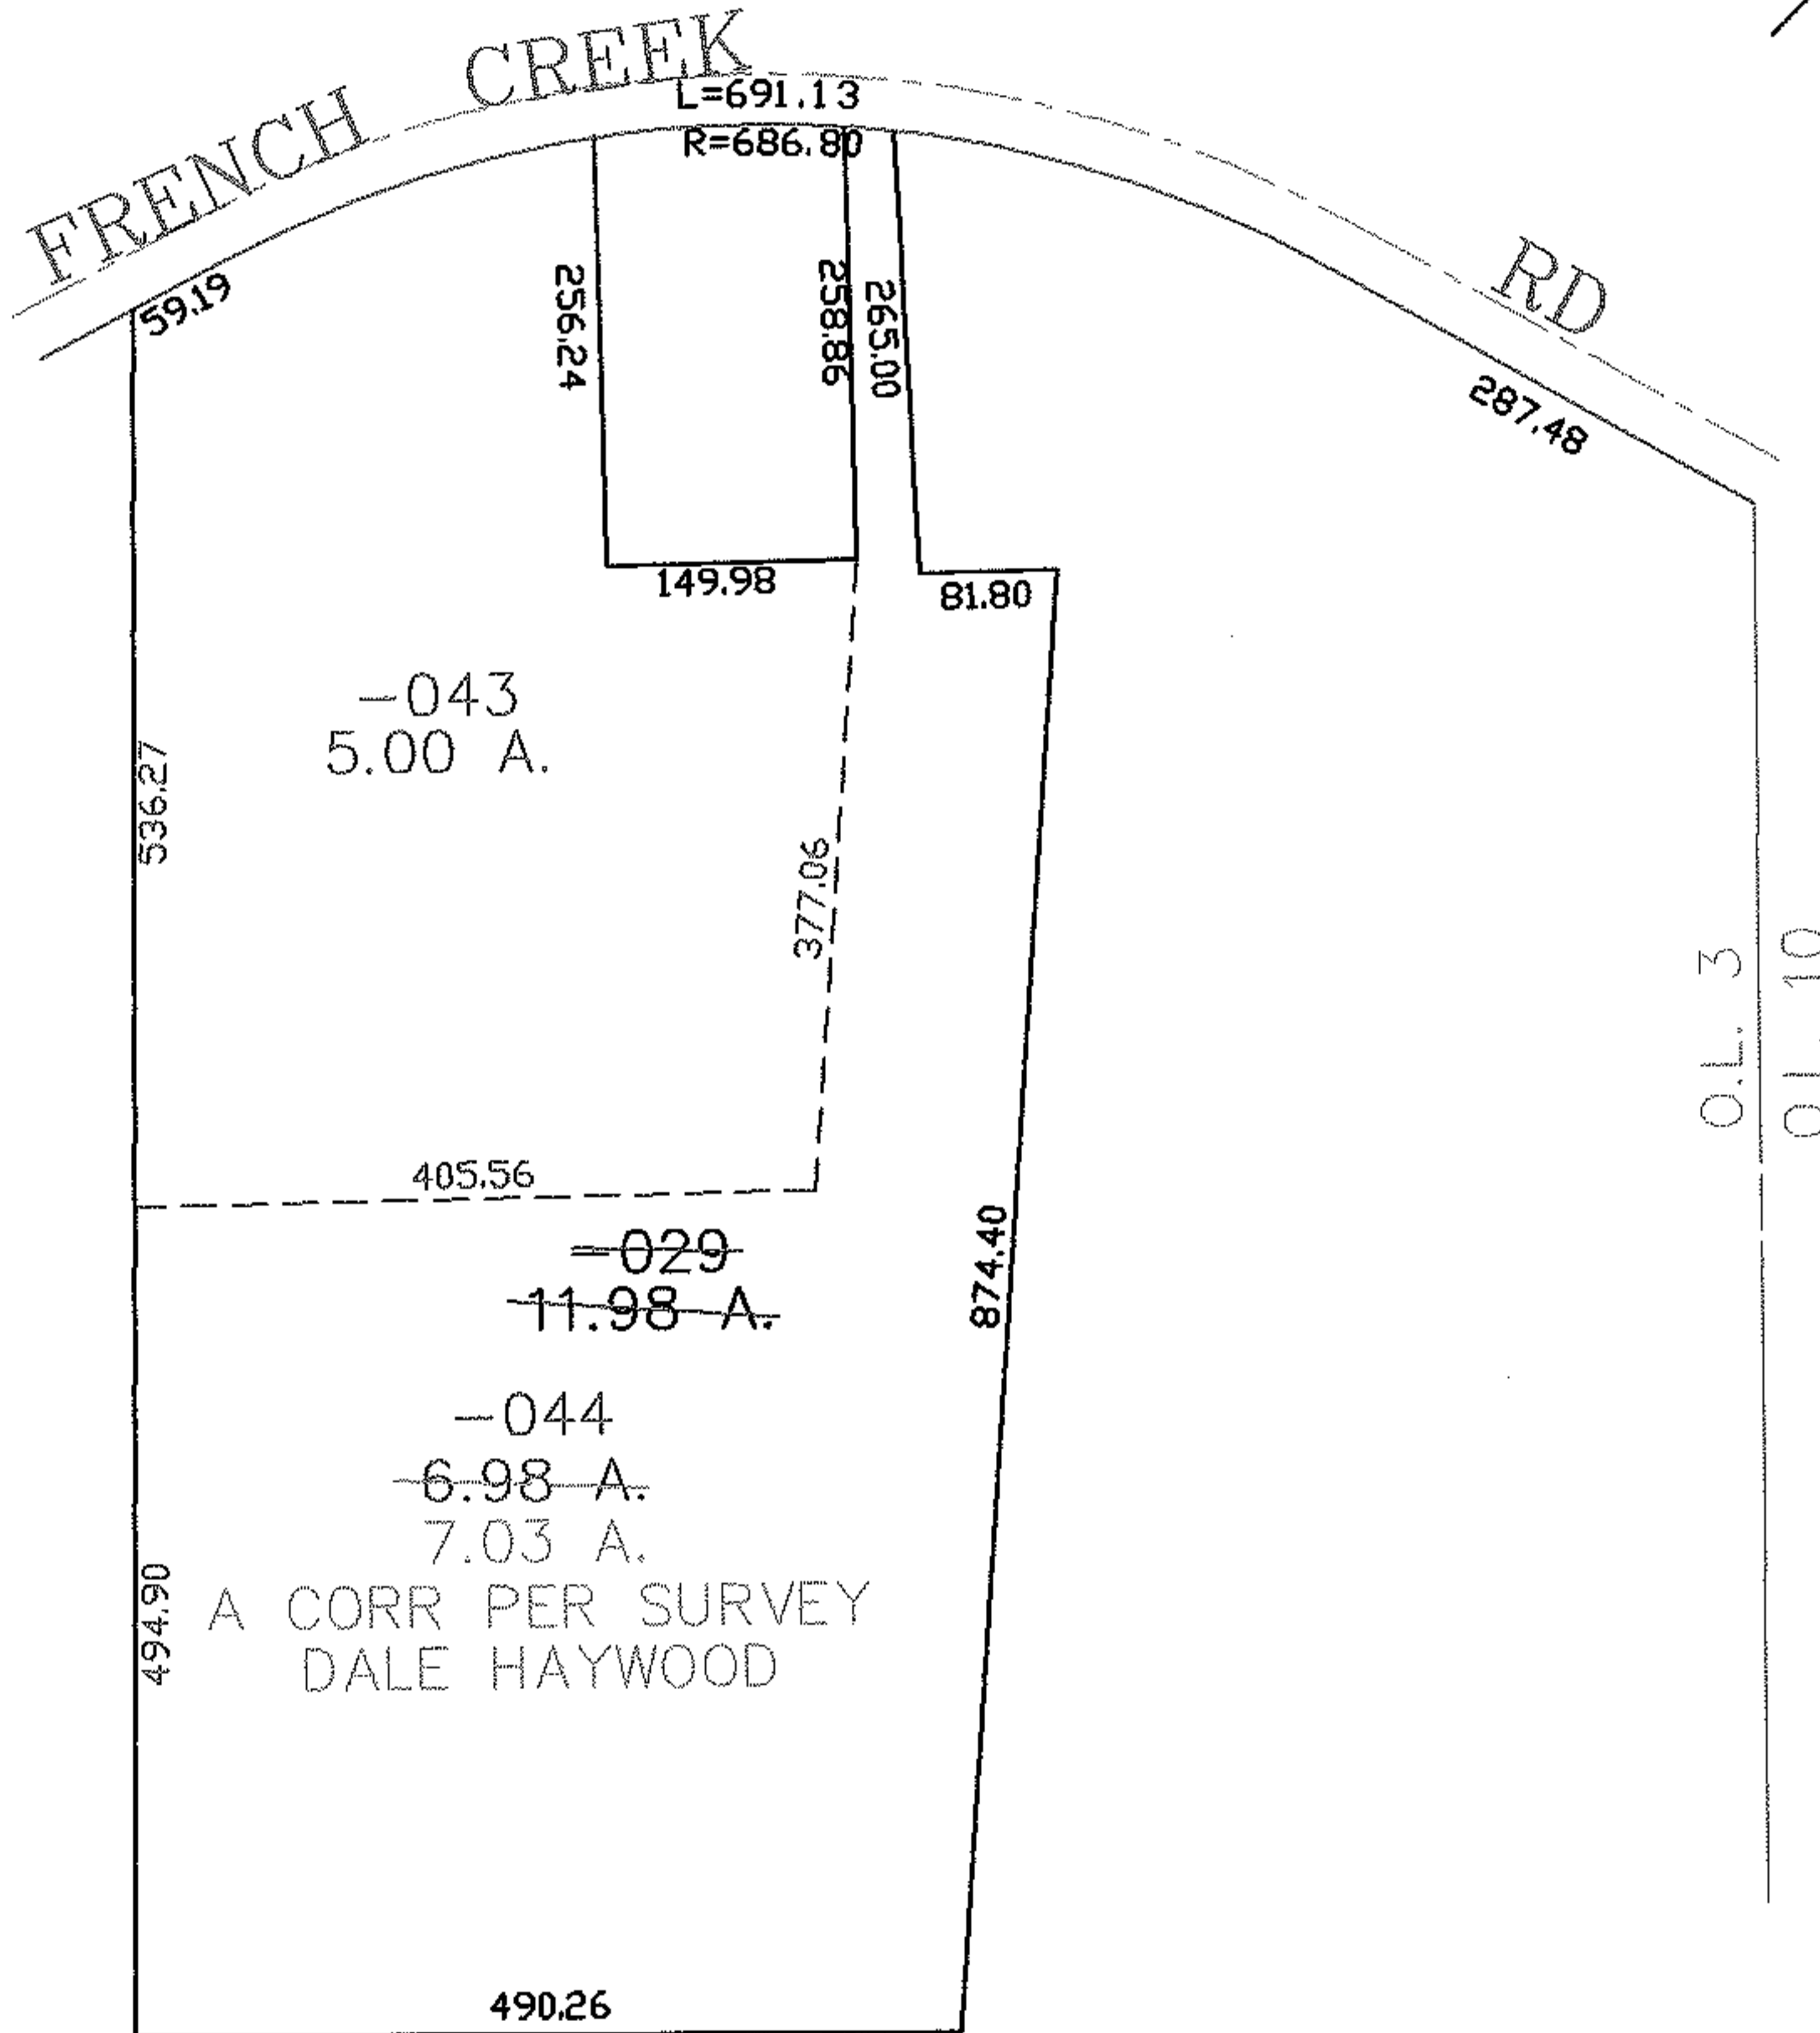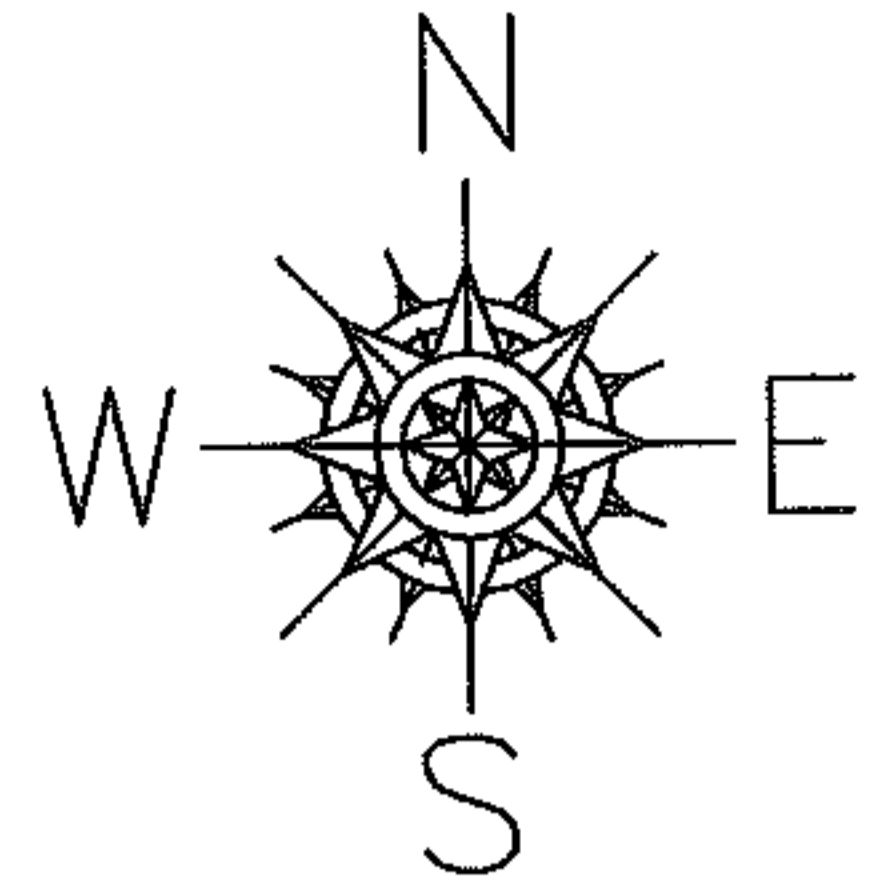

SPLITS/DEEDS PROCESSED
LORAIN COUNTY TAX MAP DEPARTMENT
 226 MIDDLE AVE. ELYRIA, OHIO

SURVEYED BY: DALE HAYWOOD
 CLOSURE: 0.00 : 10.000
 MAP PAGE(S): 04-00-003-H
 APPROVED BY: JAH DATE: 3-24-06
 SCALE: 1" = 200 PRIOR INSTRUMENT: 19960413072