


PARENT PARCEL: 07-00-039-000-028

CHILD PARCEL: _____

STARTING POINT: INTERSECTION OF SOUTH LINE OF CENTER RIDGE RD. AND WEST LINE OF LAND CONVEYED TO GEORGE KLINE ETAL(DV 967/606)



10-02128-A

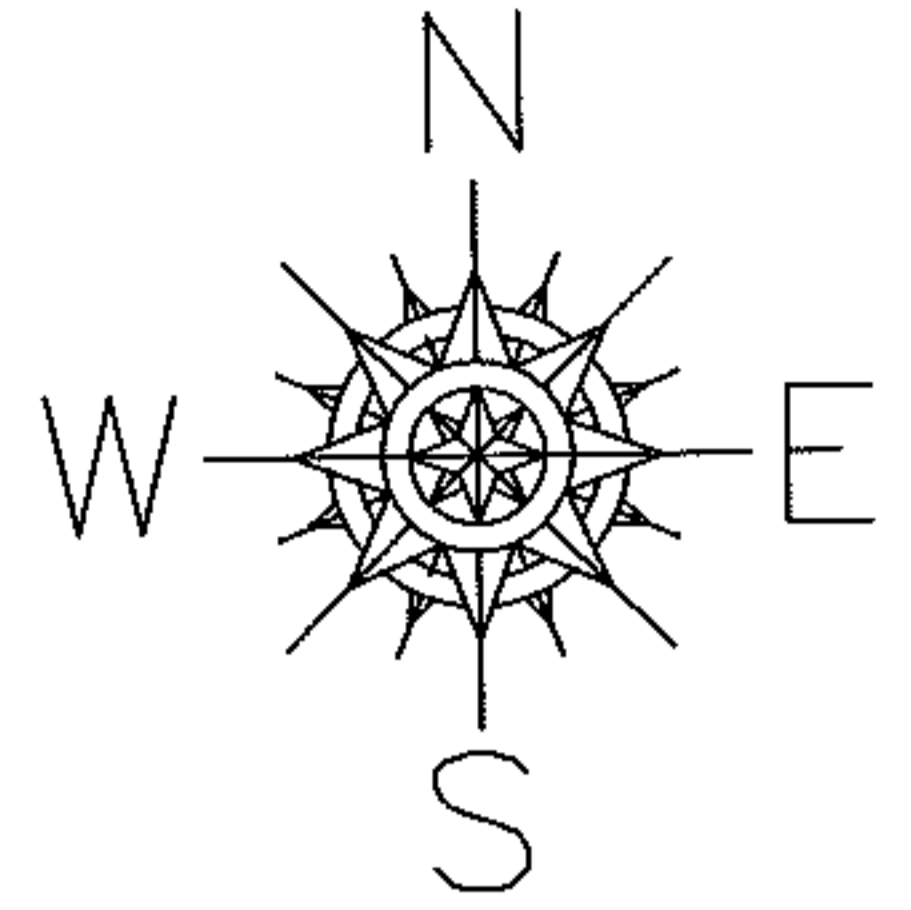

ACERAGE CORRECTION

PER DEED VOL. 973/307
AND COURT CASE NO.
10TX006292

CENTER RIDGE RD. (S.R.20)

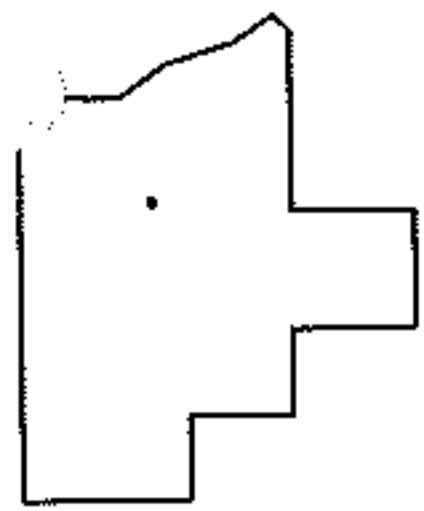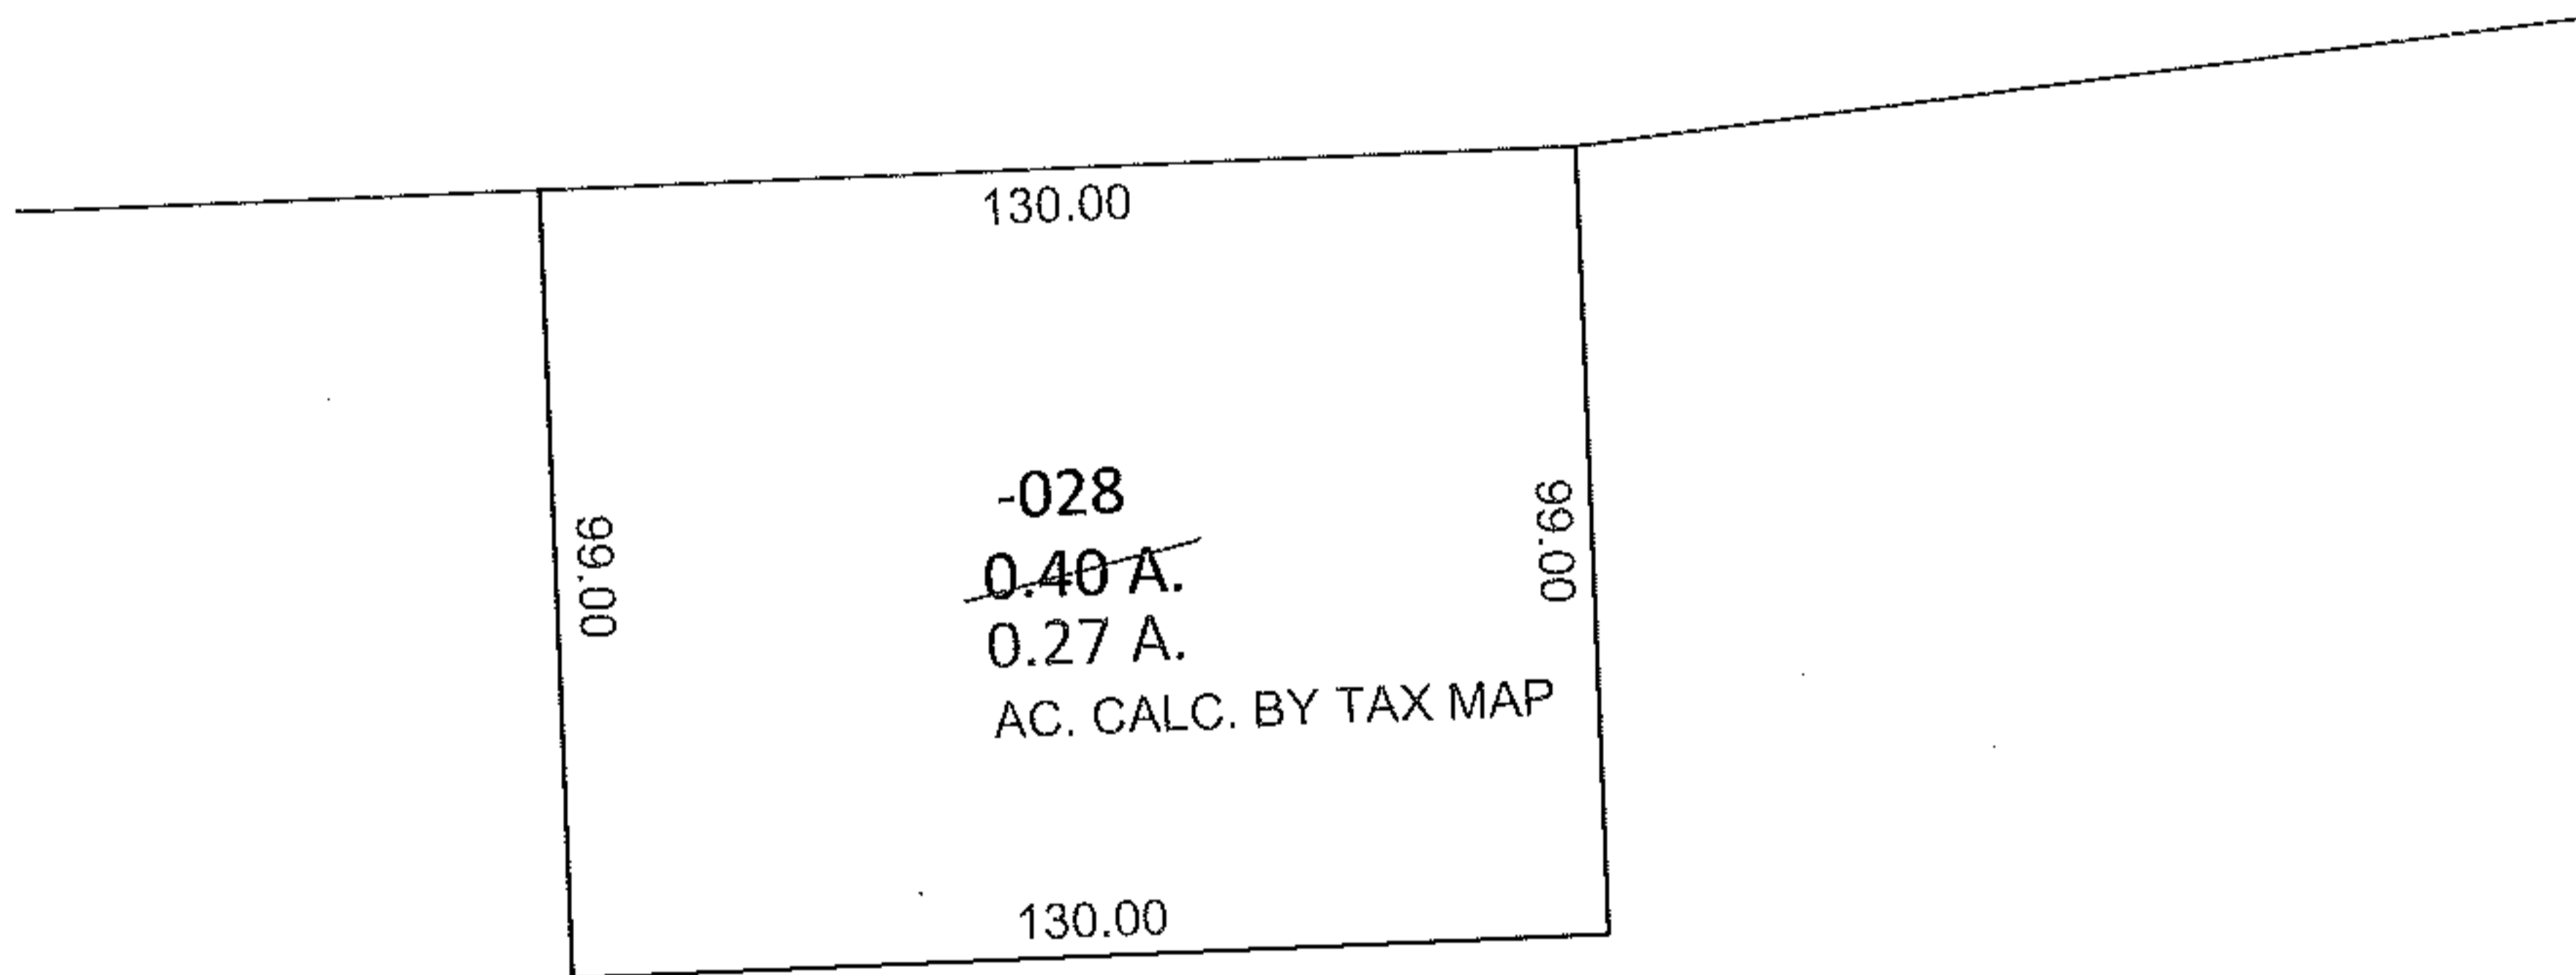

SPLITS/DEEDS PROCESSED

LORAIN COUNTY TAX MAP DEPARTMENT
226 MIDDLE AVE. ELYRIA, OHIO

SURVEYED BY: N/A
CLOSURE: N/A
MAP PAGE(S): 7-00-039-B
APPROVED BY: RRM DATE: 11-22-10
SCALE: 1"= 50' PRIOR INST.: DV 973/307