
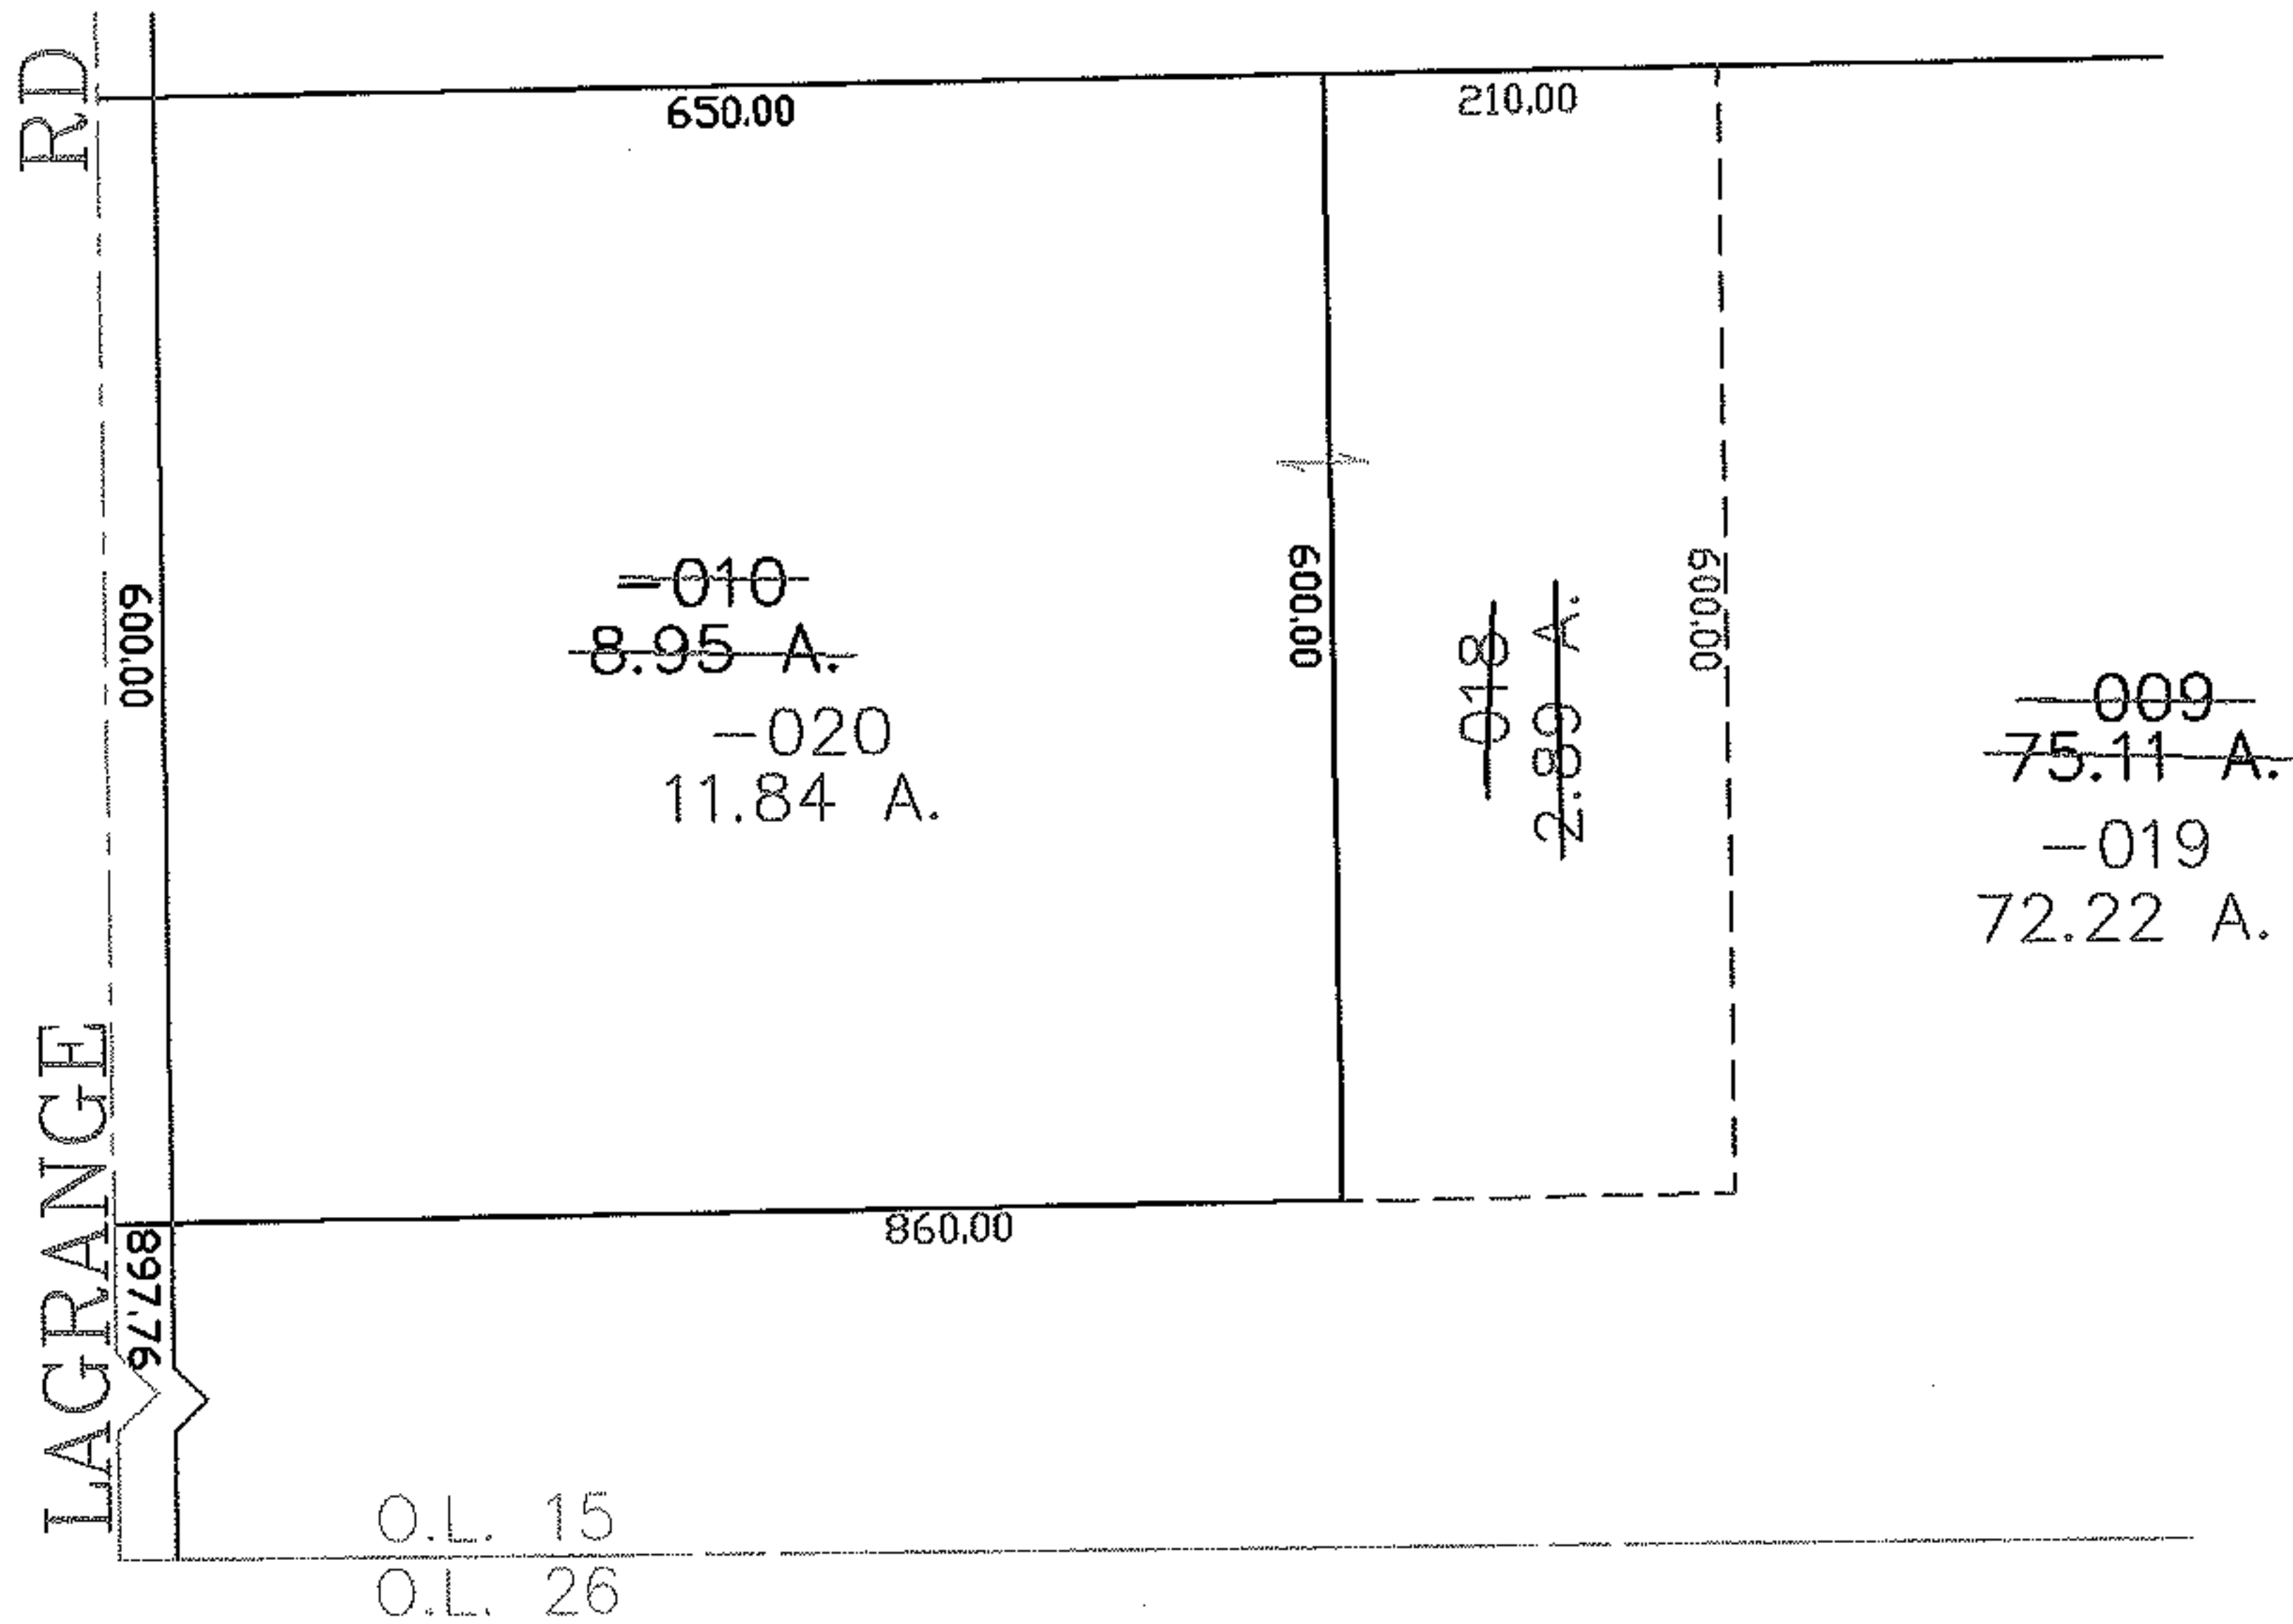


PARENT PARCEL: 15-00-015-000-009, -010  
CHILD PARCEL: 15-00-015-000-018 THRU -020  
STARTING POINT: CENTERLINE OF LAGRANGE RD & O.L. 15

06-02128

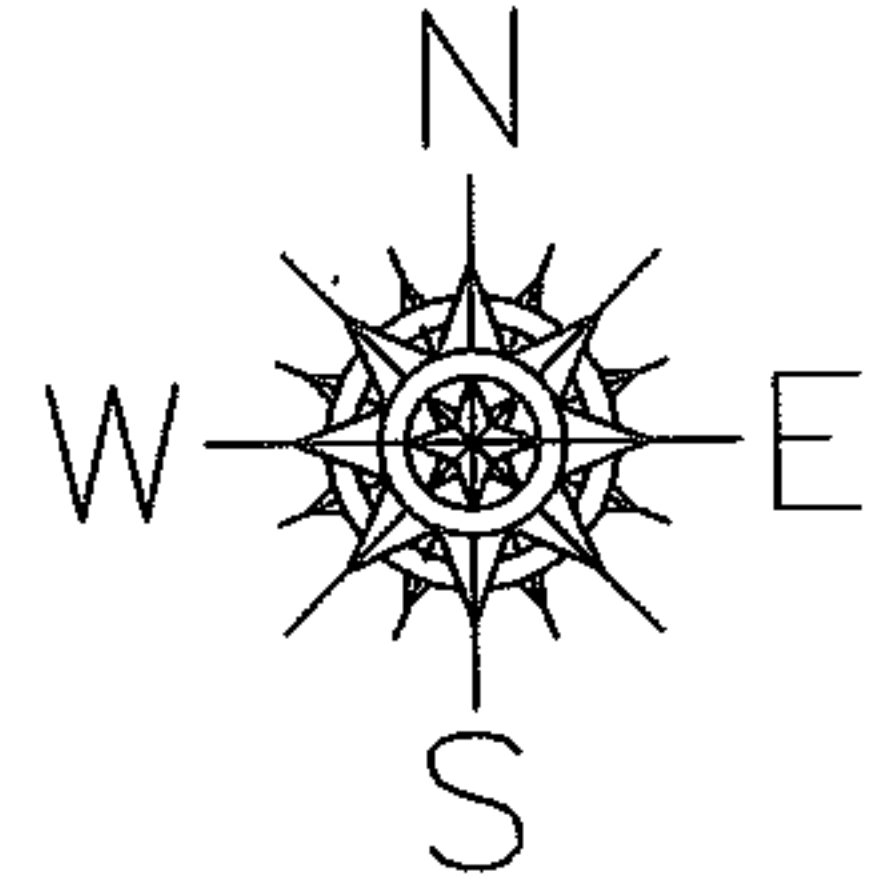

**SPLITS/DEEDS PROCESSED**  
LORAIN COUNTY TAX MAP DEPARTMENT  
226 MIDDLE AVE. ELYRIA, OHIO

SURVEYED BY: RICHARD CARLSON  
CLOSURE: 0.00 : 10.000  
MAP PAGE(S): 15-B  
APPROVED BY: JAH DATE: 3-29-06  
SCALE: 1" = 200 PRIOR INSTRUMENT: 19990643328