

PARENT PARCEL: 17-06-023-000-004

CHILD PARCEL: XX-XX-XXX-XXX-XXX

STARTING POINT: BEGINNING AT THE N.W. CORNER OF O.L. 23

10-02129-C



# ACREAGE CORRECTION

17-06-023-000-004

~~40.43 A.~~

40.70 A.

CORR. PER DEED  
INST. 20060122382

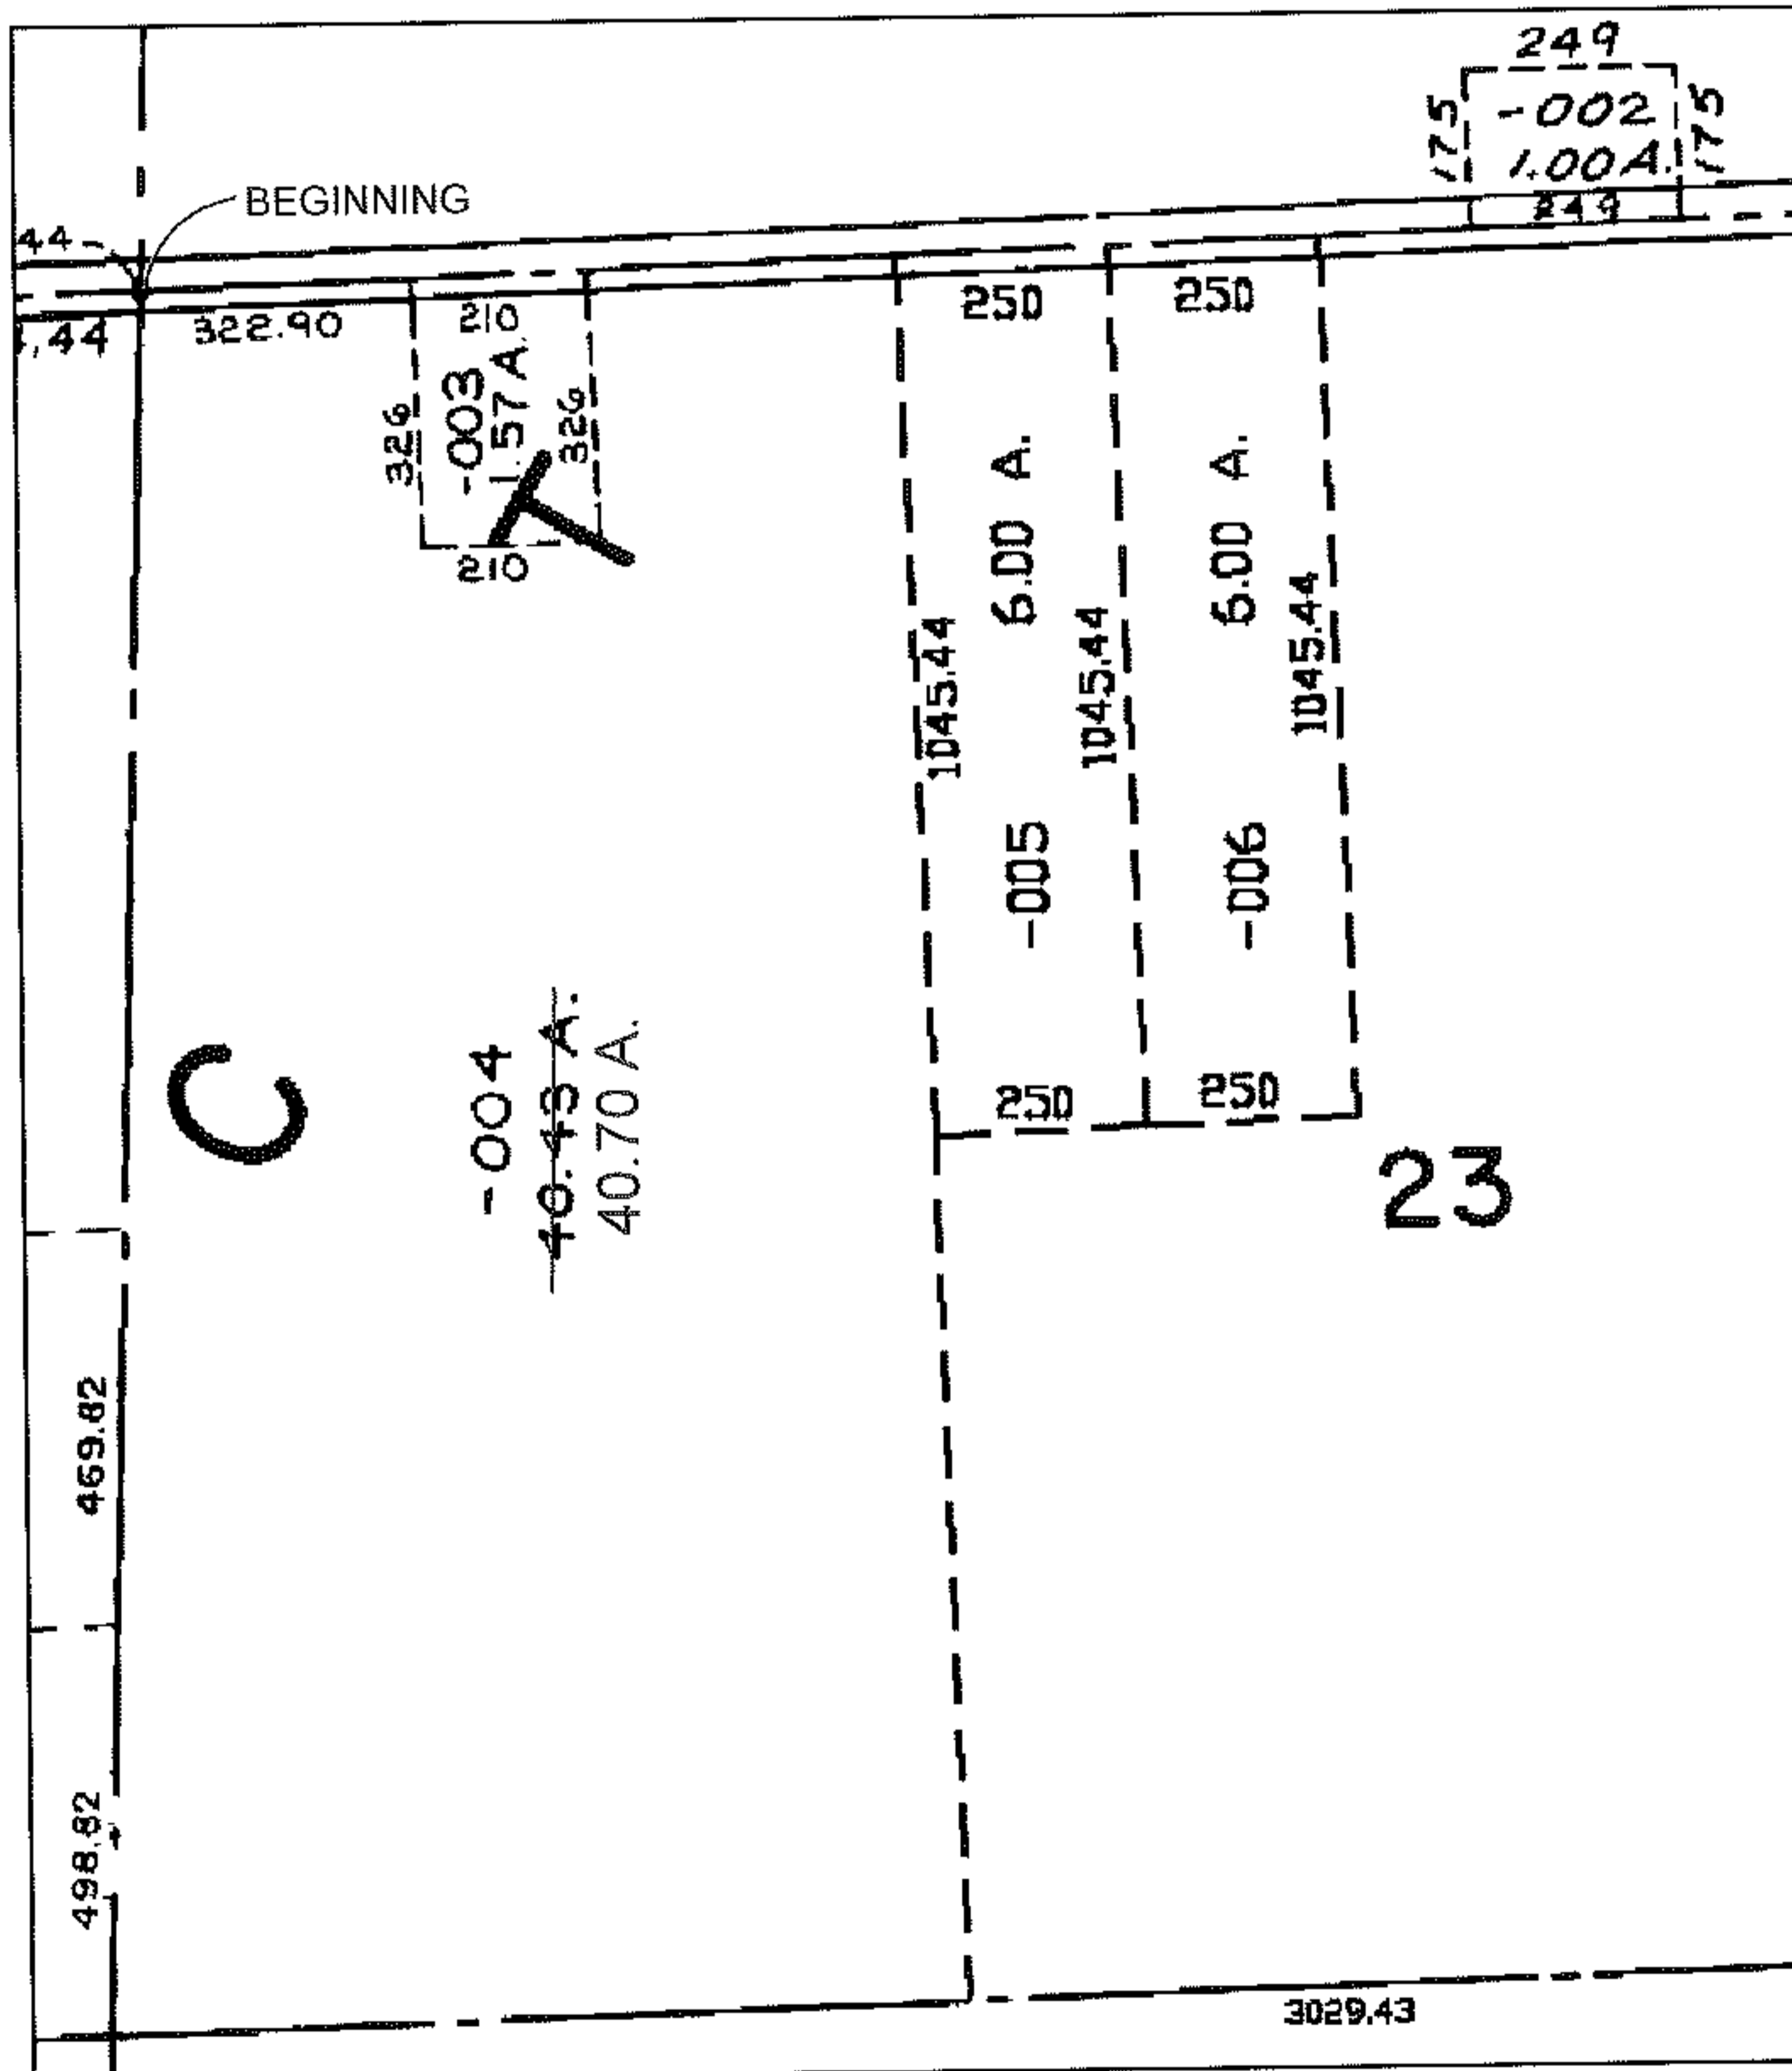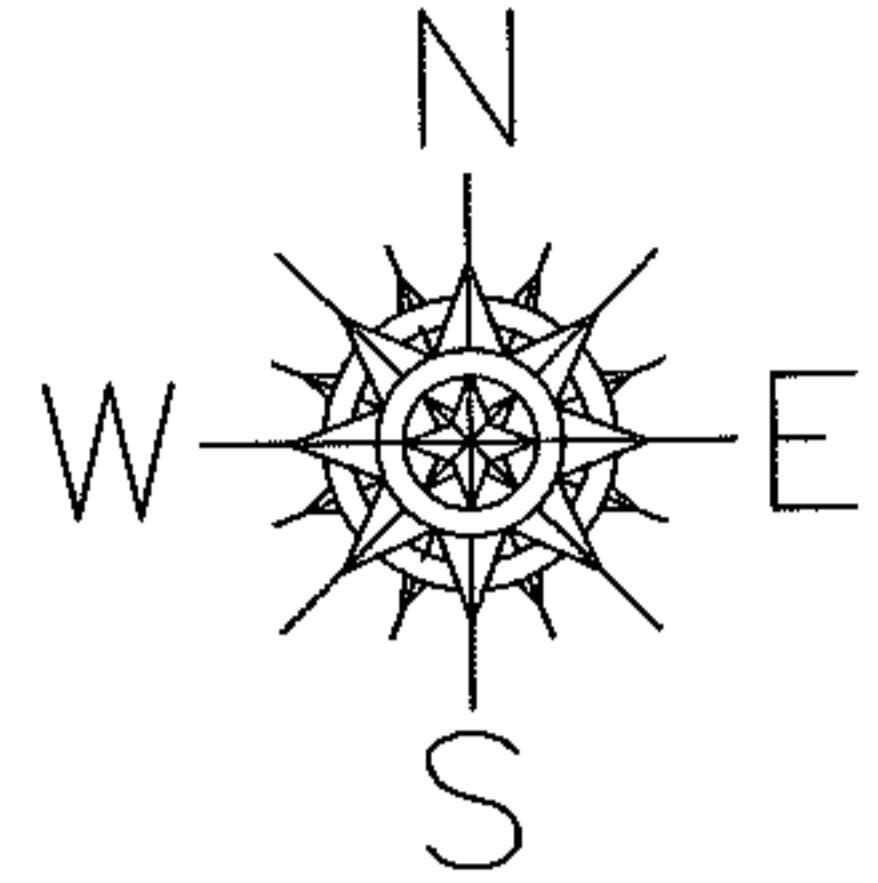

## SPLITS/DEEDS PROCESSED

LORAIN COUNTY TAX MAP DEPARTMENT  
226 MIDDLE AVE. ELYRIA, OHIO

SURVEYED BY: NONE

CLOSURE: NONE

MAP PAGE(S): 17-G

APPROVED BY: TJS DATE: 11/12/10

SCALE: 1"=400 PRIOR INST.: 20060122382