



RASTER

PARENT PARCEL: 07-00-035-102-075, -097

CHILD PARCEL: 07-00-035-102-098 THRU -100

STARTING POINT: CENTERLINE OF RACE RD & SUGAR RIDGE RD

06-02130

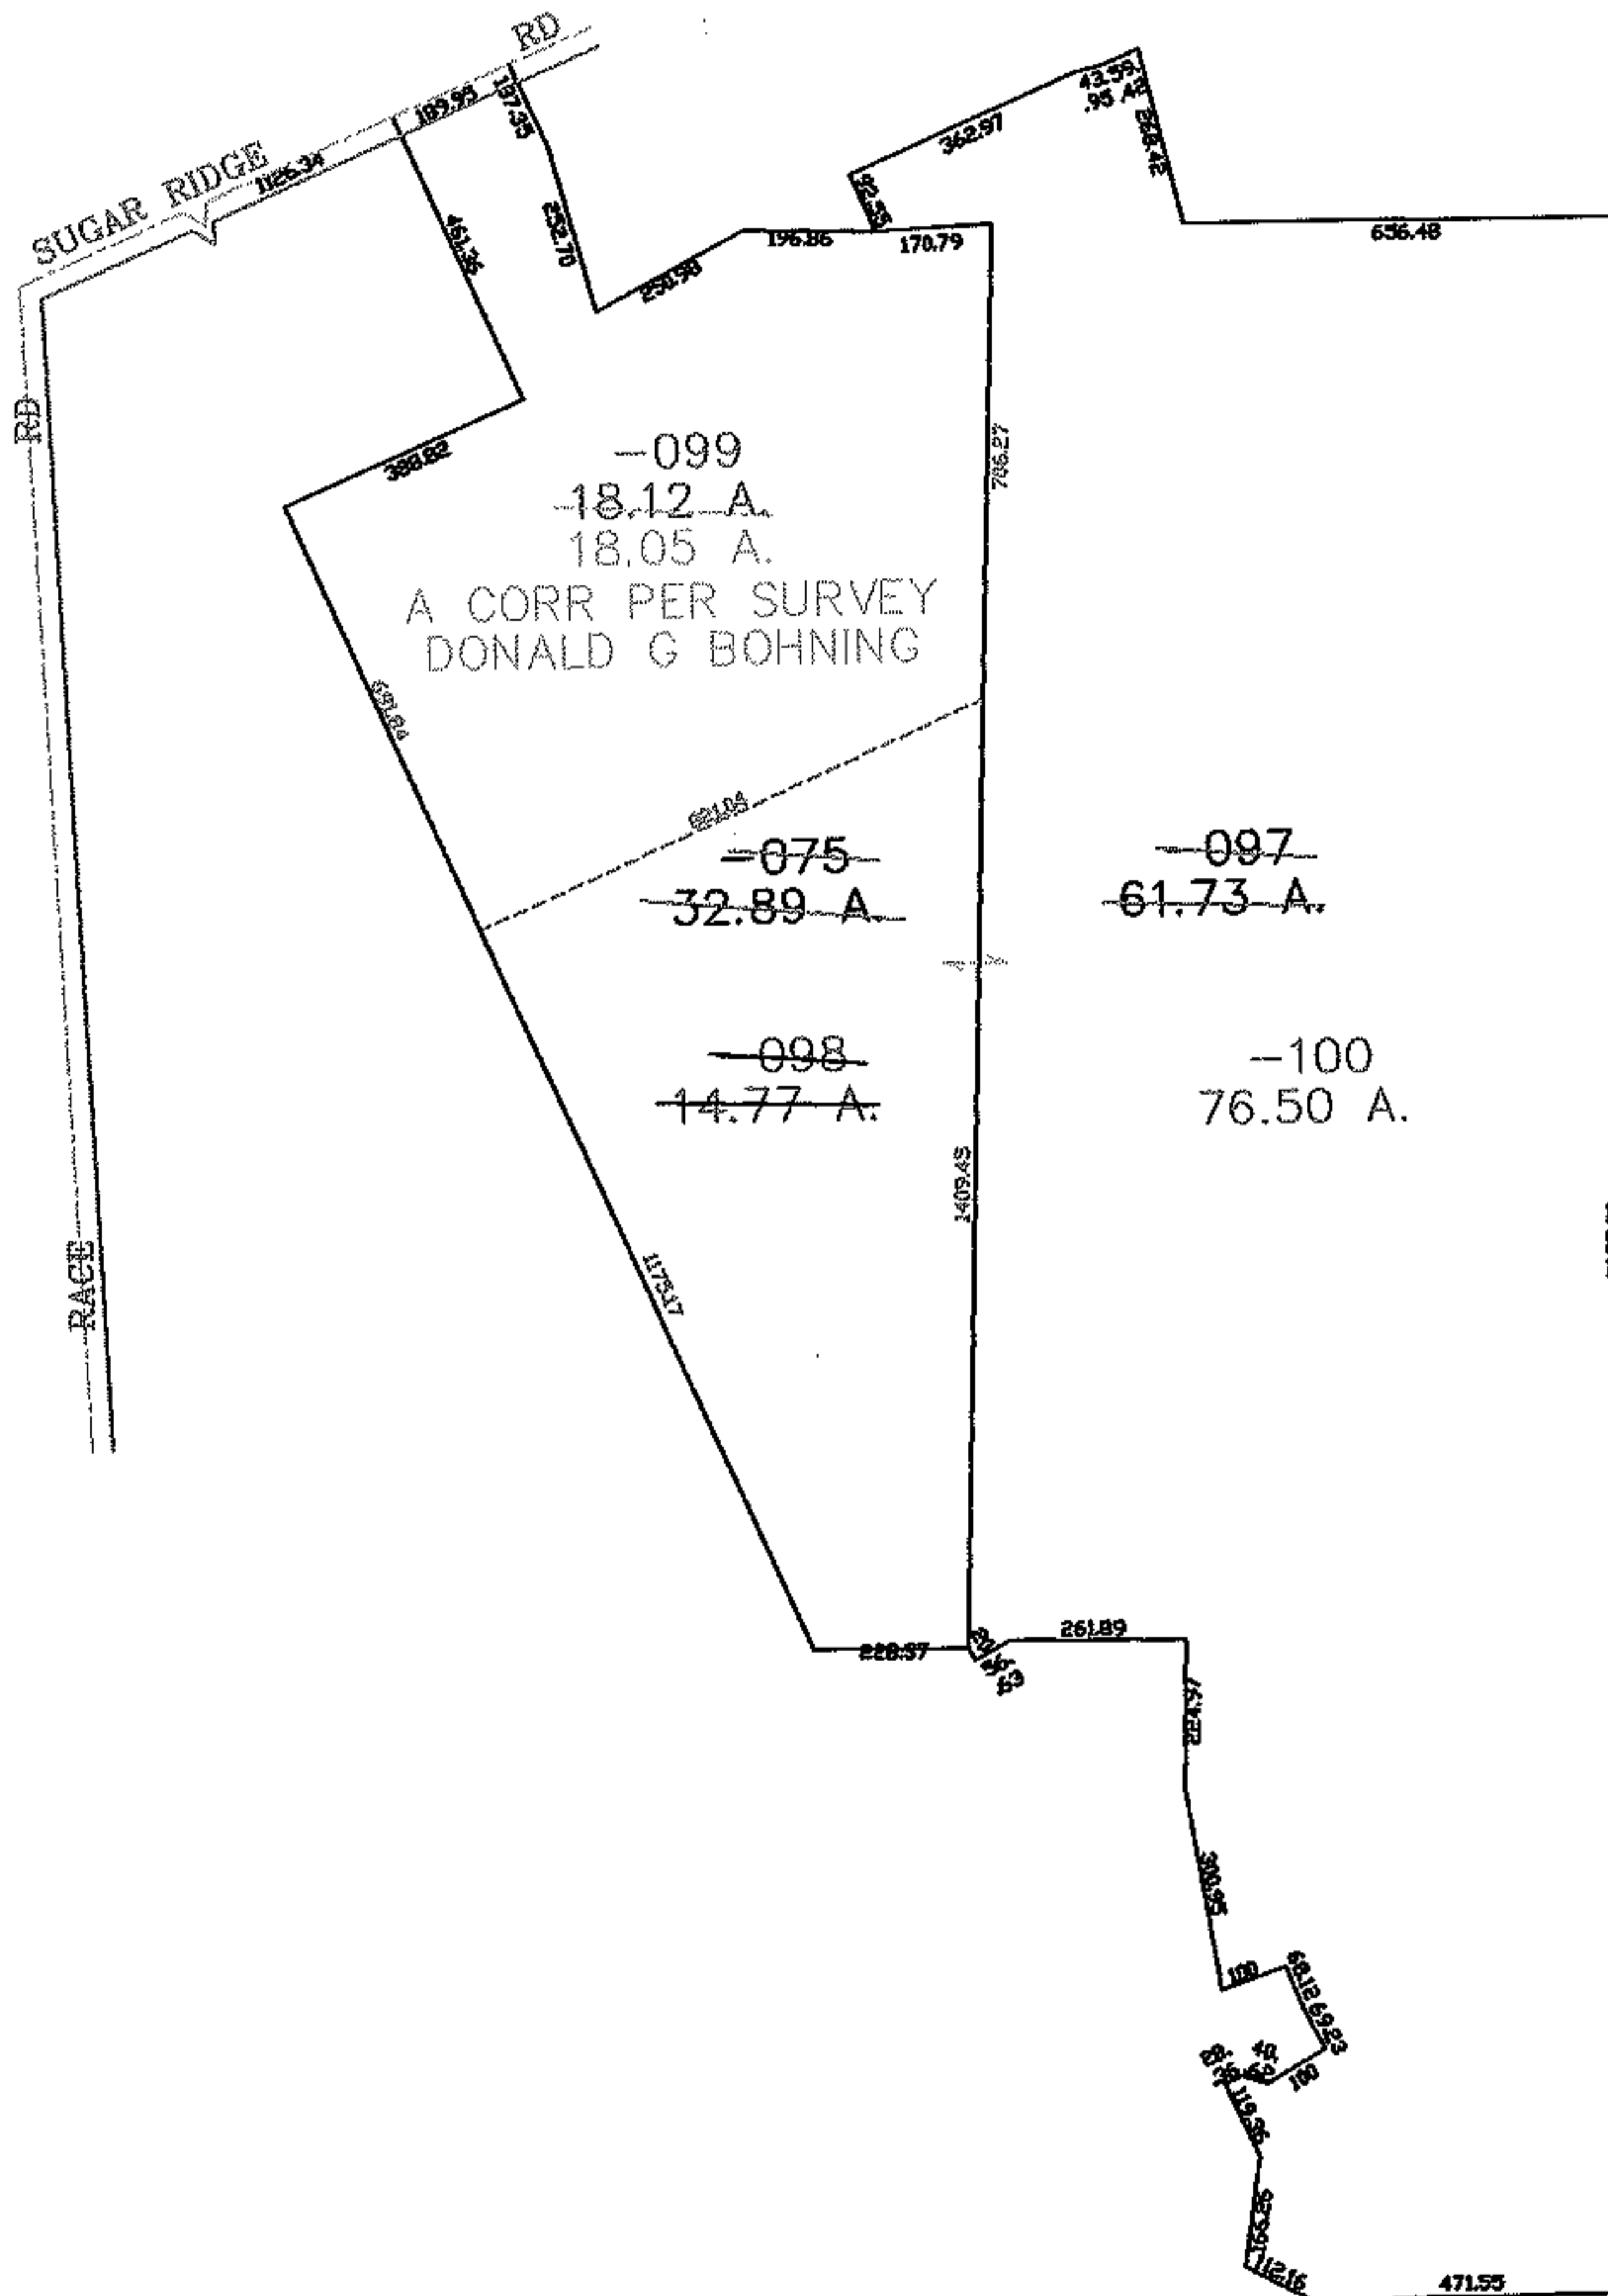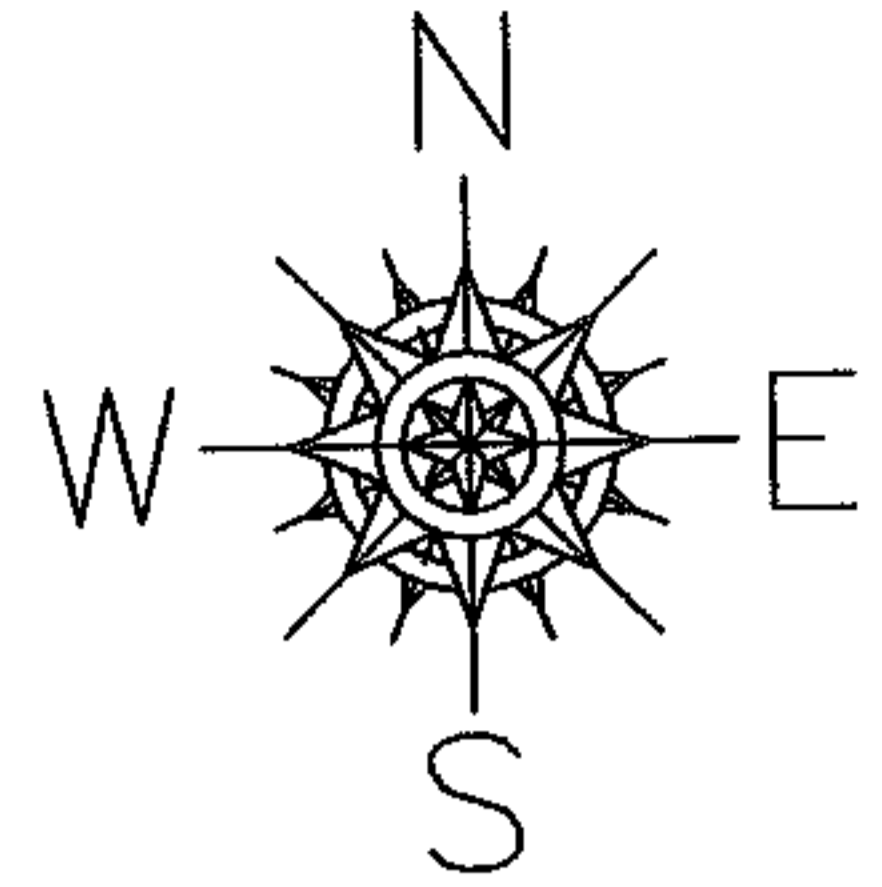

SPLITS/DEEDS PROCESSED

LORAIN COUNTY TAX MAP DEPARTMENT
226 MIDDLE AVE. ELYRIA, OHIO

SURVEYED BY: DONALD G BOHNING

CLOSURE: 0.00 : 10.000

MAP PAGE(S): 07-00-035-B

APPROVED BY: JAH DATE: 4-10-06

SCALE: 1" = 500 PRIOR INSTRUMENT: 20020863461