


PARENT PARCEL: 02-02-008-107-031, -032  
CHILD PARCEL: 02-02-008-107-037 THRU -044  
STARTING POINT: CENTERLINE OF JAEGER RD & O.L. 8

06-02132

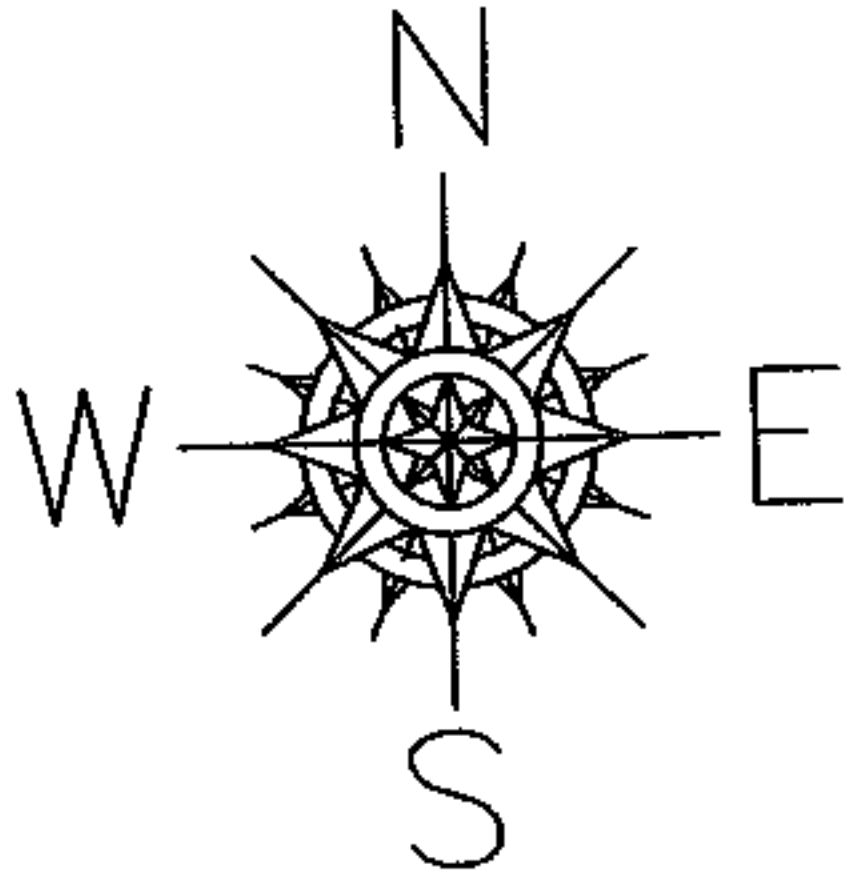

O.L. 13  
O.L. 8


~~-032~~  
~~63.54 A.~~  
~~-037~~  
~~65.00 A.~~  
~~64.95 A.~~  
A CORR PER SURVEY  
JAMES E KARING  
~~-040~~  
~~62.64 A.~~  
~~-042~~  
~~54.86 A.~~  
~~-044~~  
42.37 A.

-043  
12.49 A.

-038  
1.31 A.

-039  
1.00 A.

-041  
7.78 A.

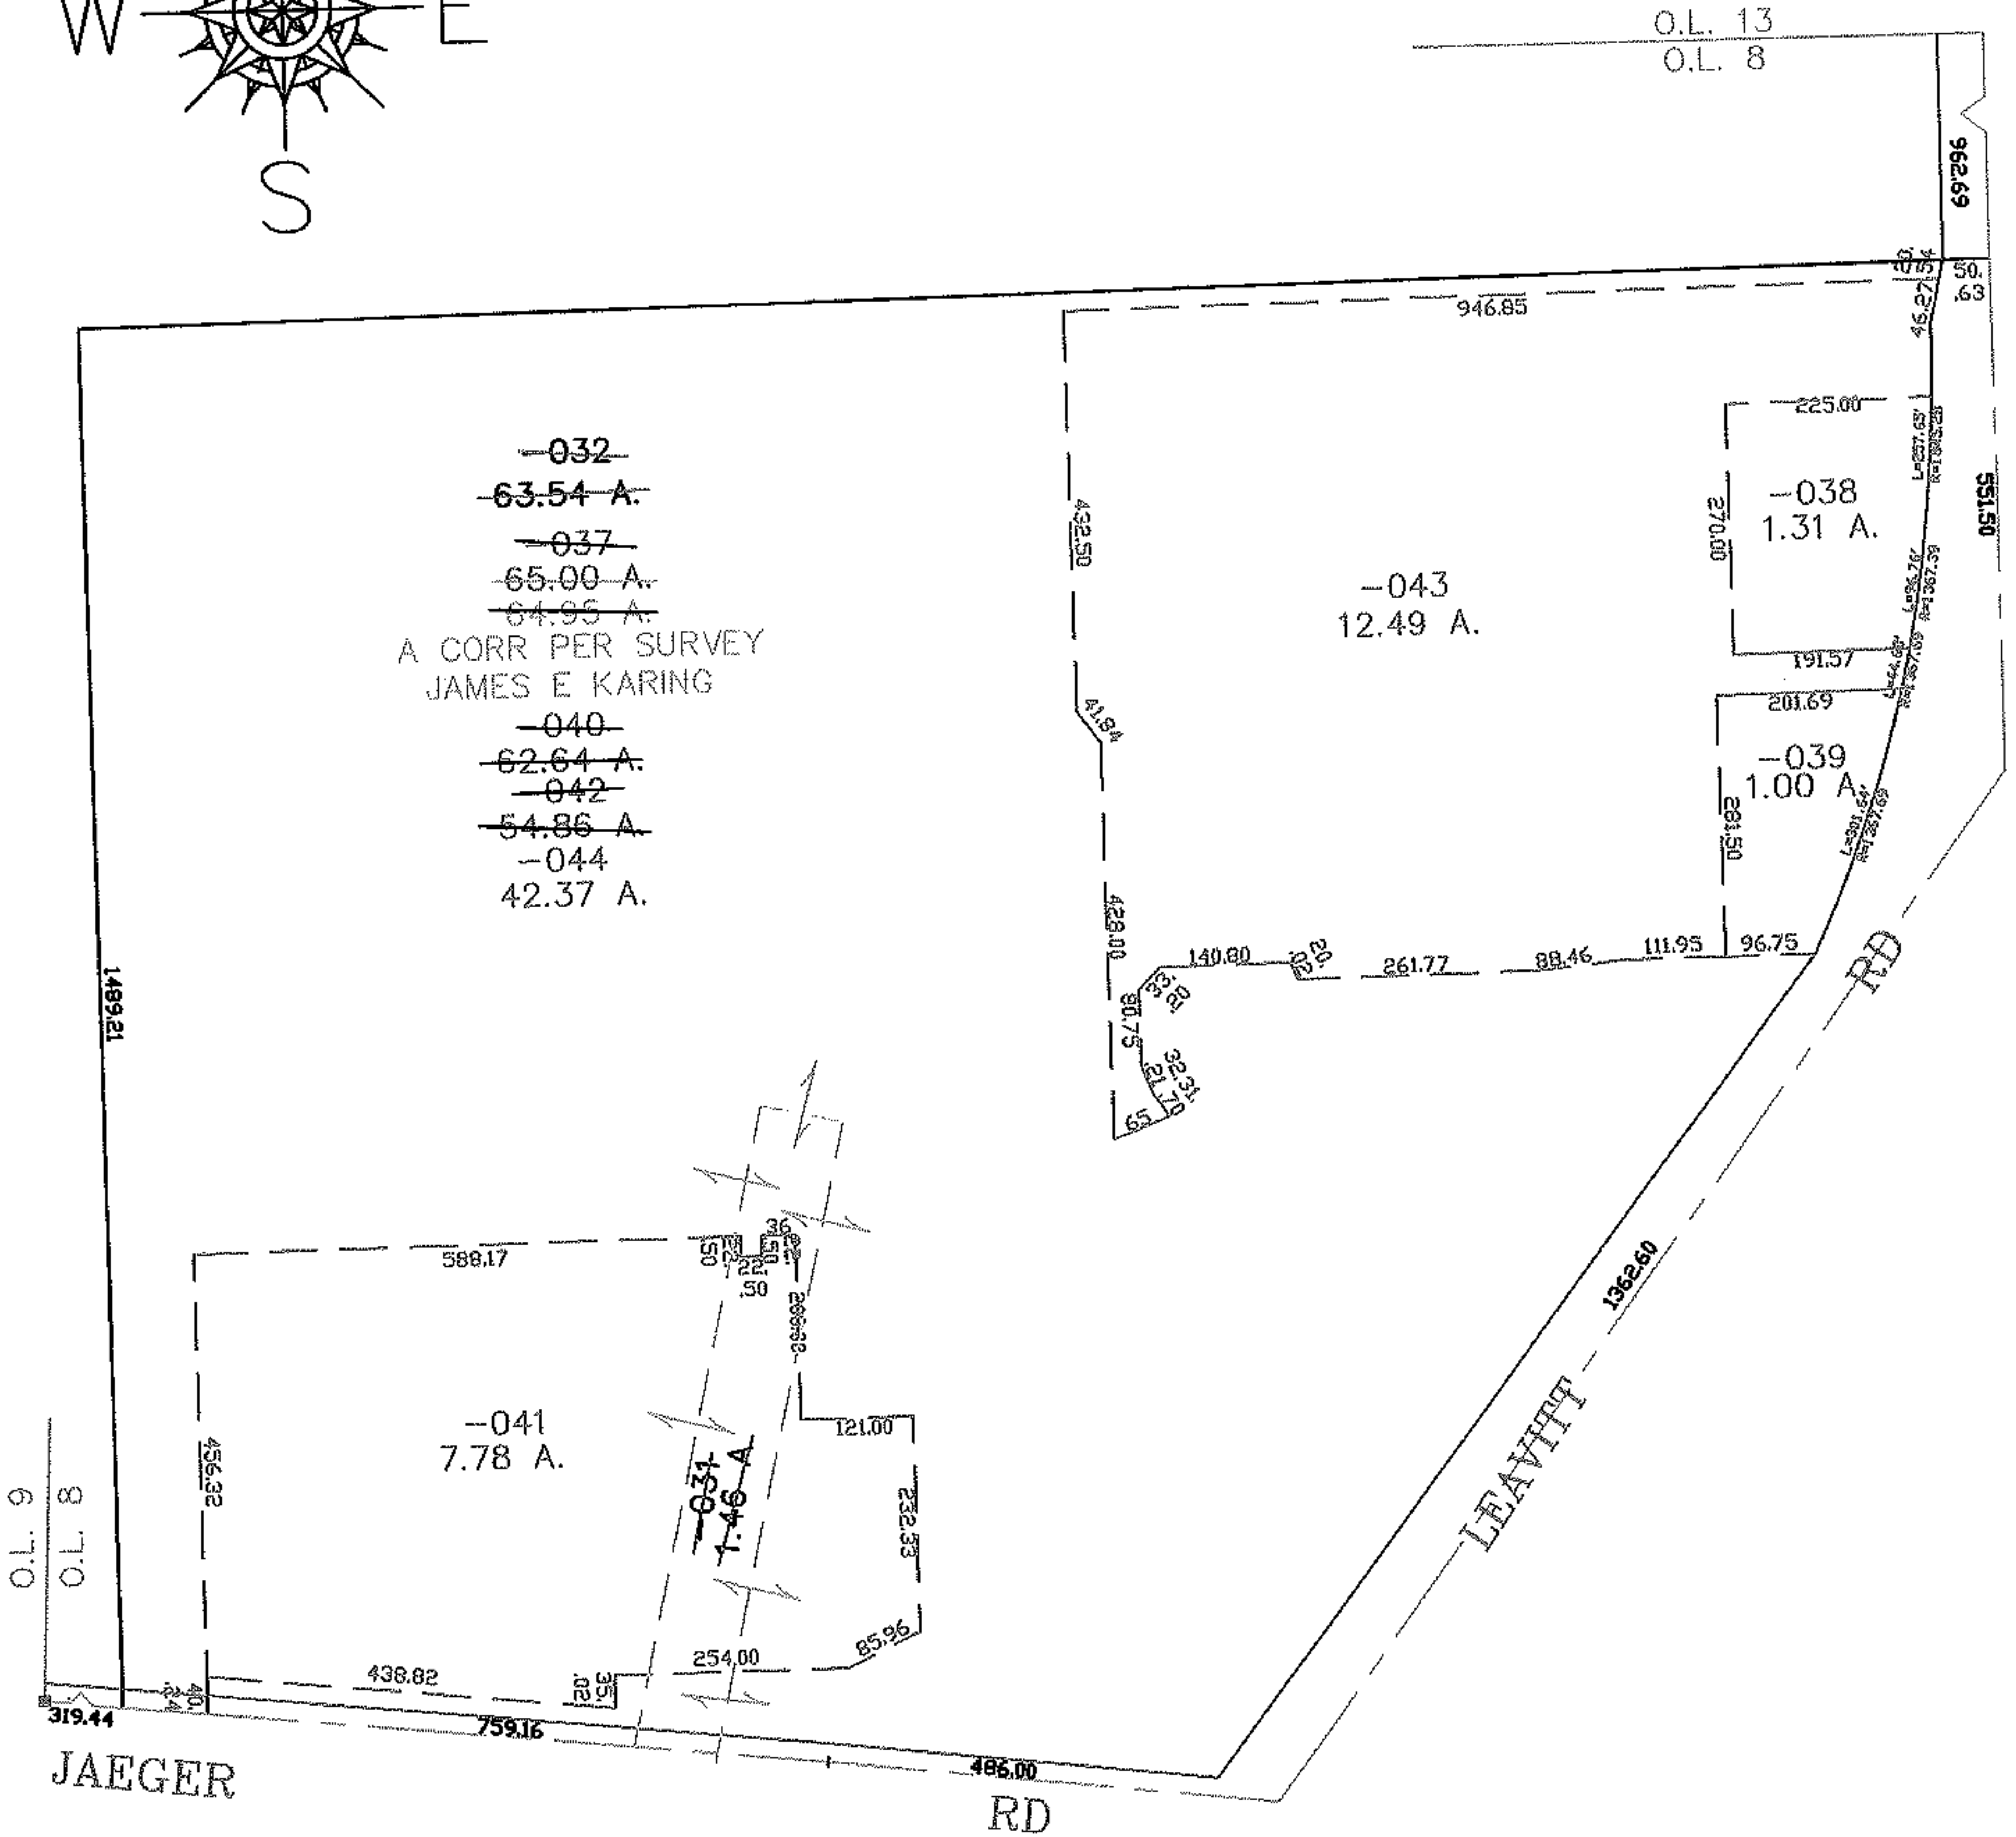


6.70  
8.70

JAEGER

RD

LEAVITT

RD

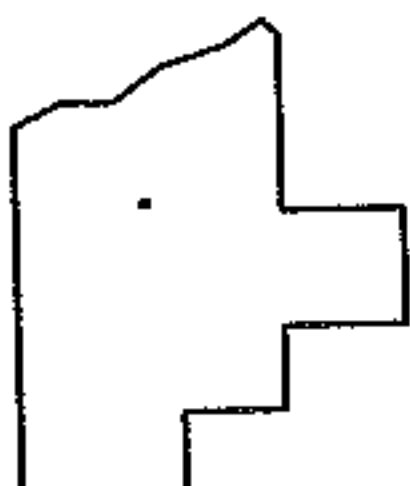

**SPLITS/DEEDS PROCESSED**  
LORAIN COUNTY TAX MAP DEPARTMENT  
226 MIDDLE AVE. ELYRIA, OHIO

SURVEYED BY: JAMES E KARING  
CLOSURE: 0.00 : 10.000  
MAP PAGE(S): 02-02-008-A,B  
APPROVED BY: JAH DATE: 4-19-06  
SCALE: 1" = 300 PRIOR INSTRUMENT: 19980514138