
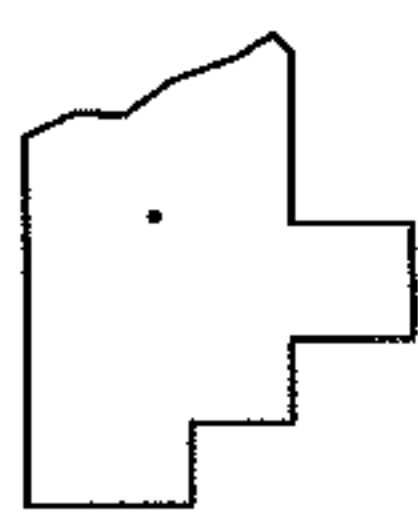
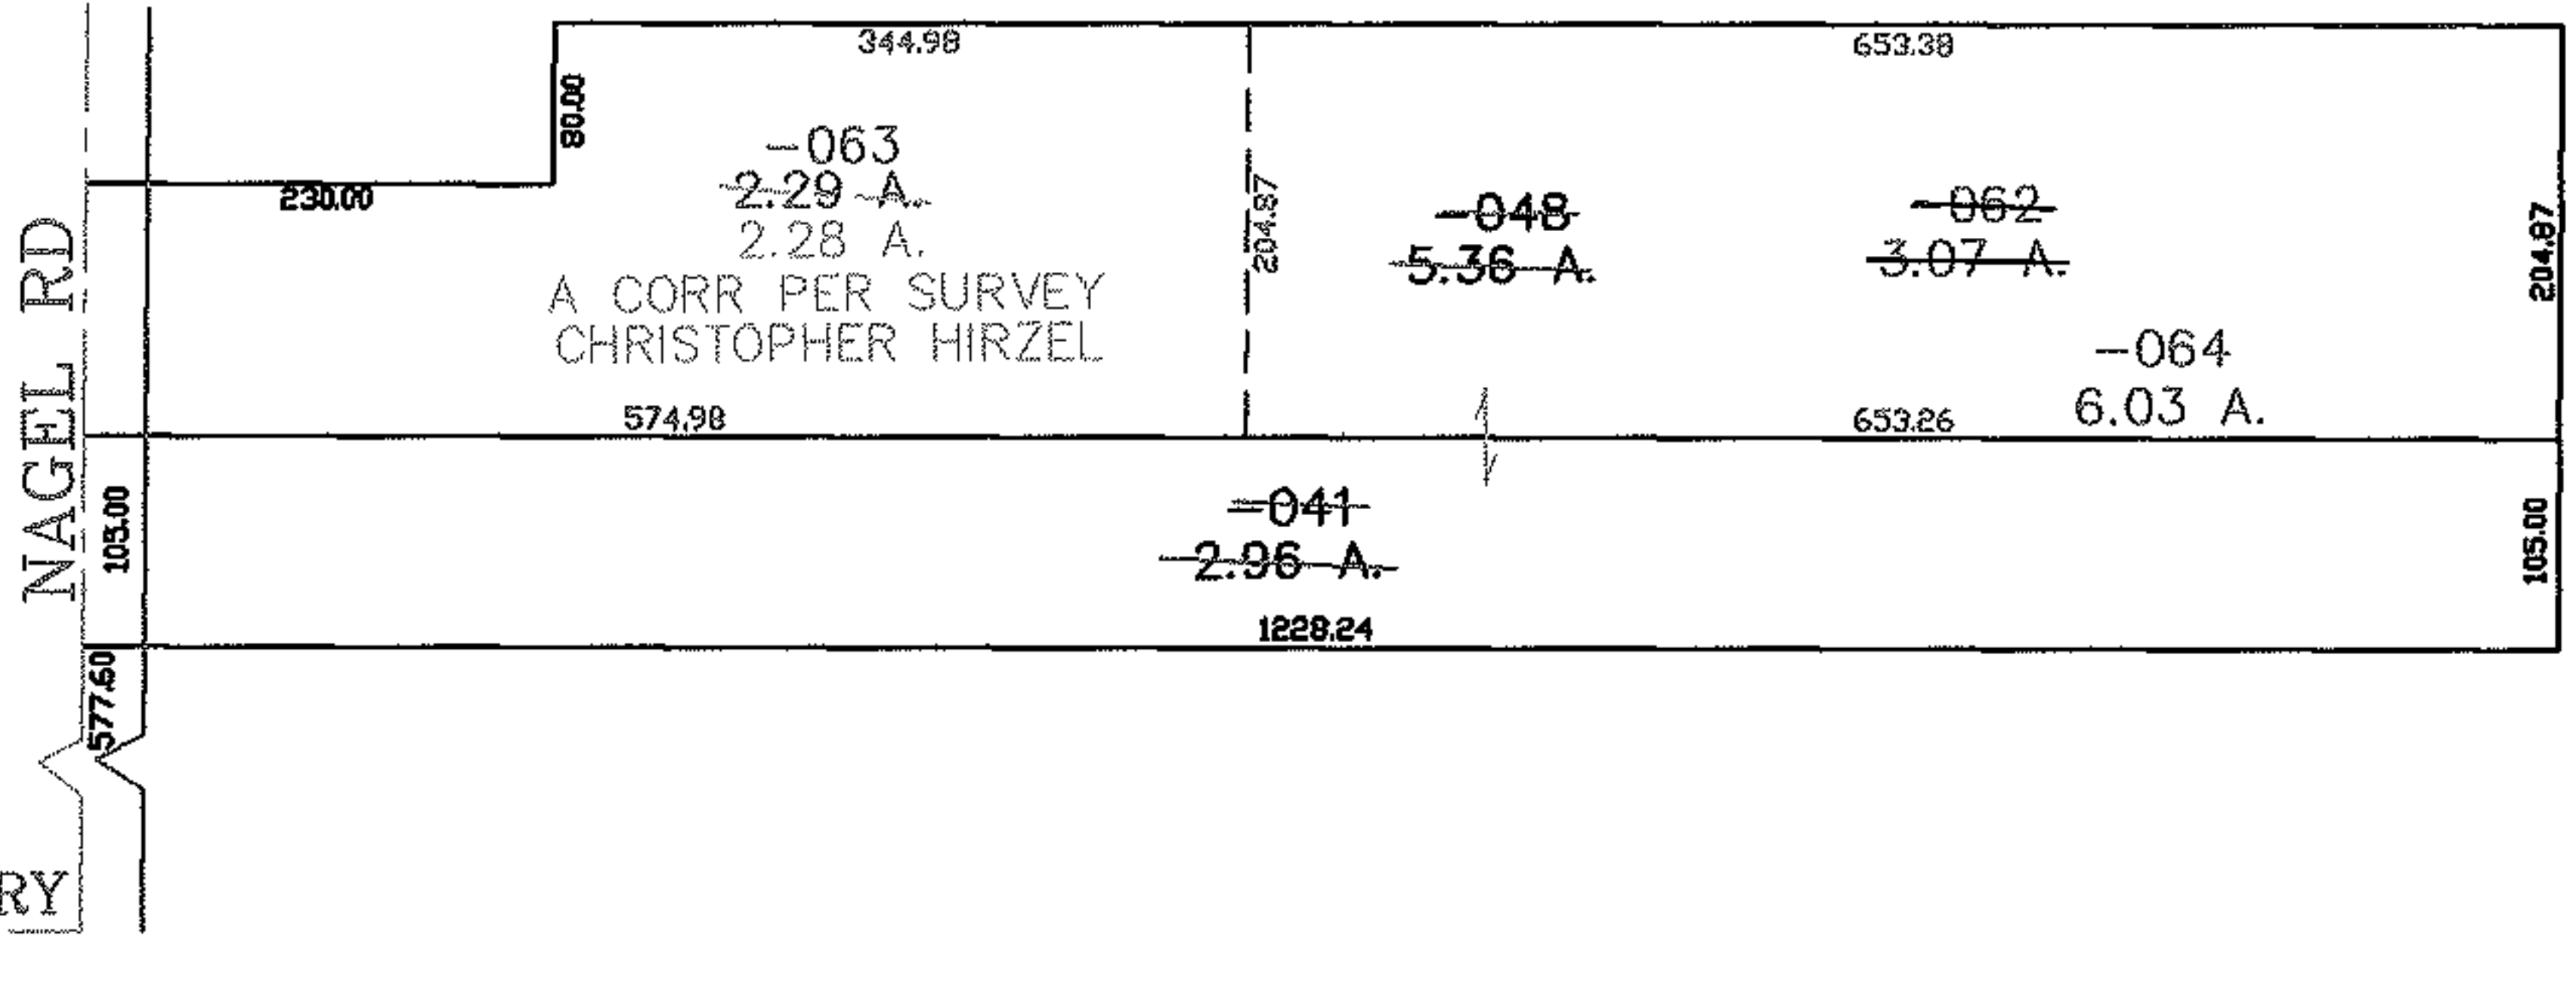


RASTER

PARENT PARCEL: 04-00-026-103-048, -041
CHILD PARCEL: 04-00-026-103-062 THRU -064
STARTING POINT: CENTERLINE OF HAWKSURY CT & NAGEL RD

06-02134

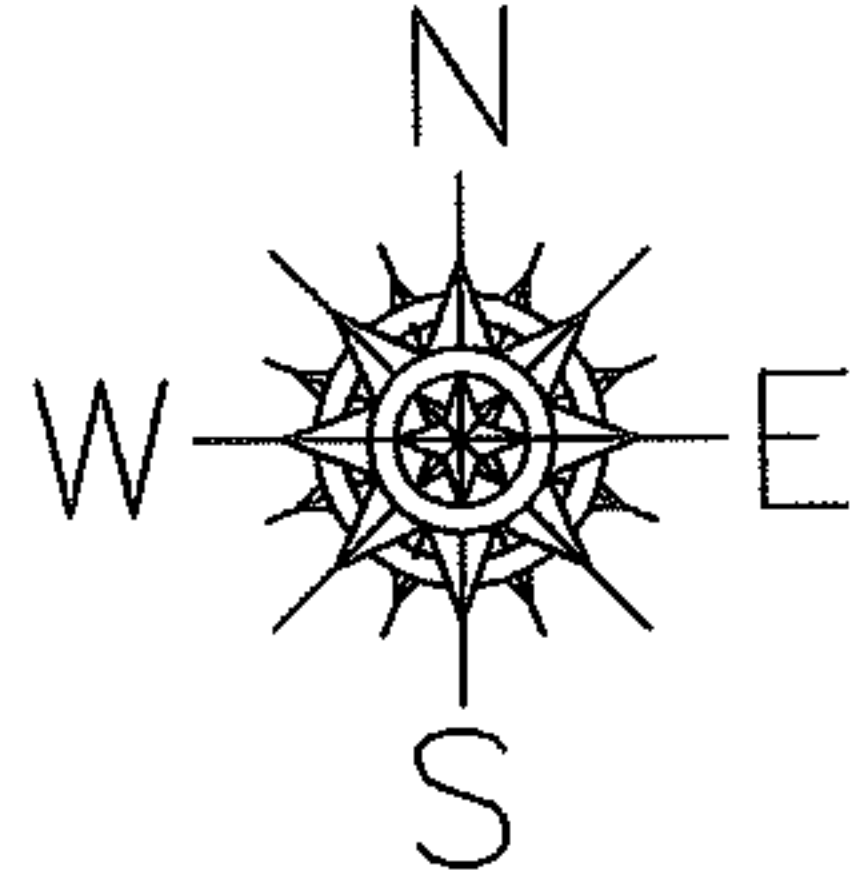

SPLITS/DEEDS PROCESSED
LORAIN COUNTY TAX MAP DEPARTMENT
226 MIDDLE AVE. ELYRIA, OHIO

SURVEYED BY: CHRISTOPHER HIRZEL
CLOSURE: 0.00 : 10.000
MAP PAGE(S): 04-00-026-A
APPROVED BY: JAH DATE: 04-17-06
SCALE: 1" = 200 PRIOR INSTRUMENT: OR 964/505