
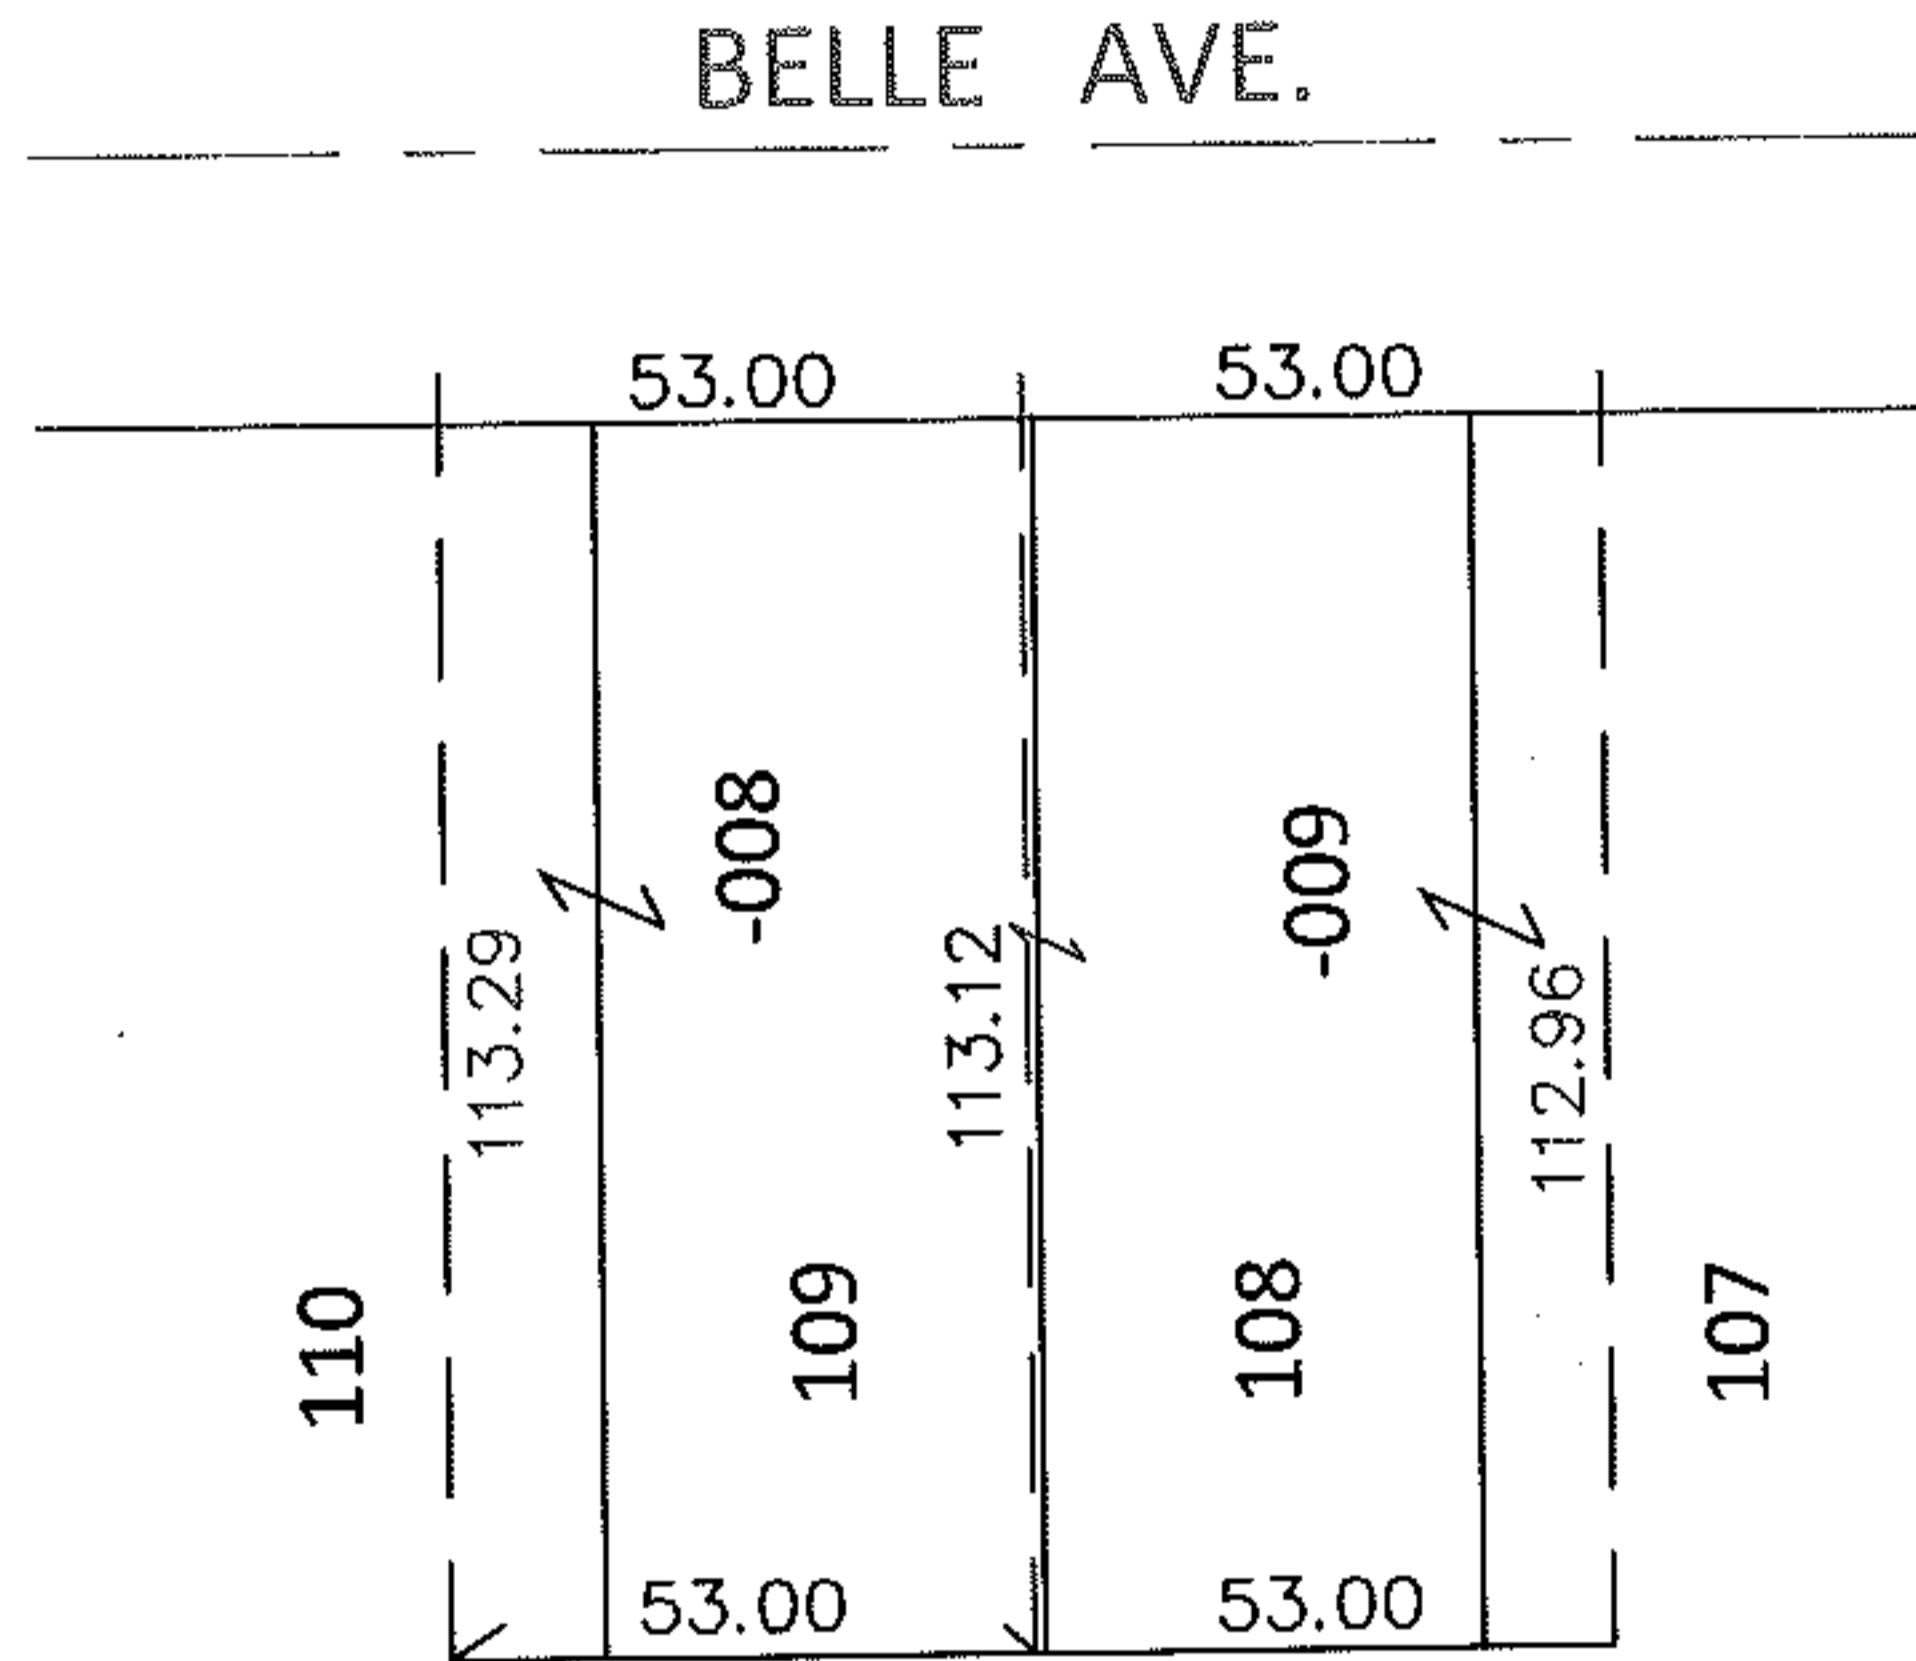


PARENT PARCEL: 03-00-029-103-008, -009

CHILD PARCEL: \_\_\_\_\_

STARTING POINT: S/L 107 THRU 110 OF KNICKERBOCKER SUB. NO. 2(VOL.12 PG.16)

10-02136-C

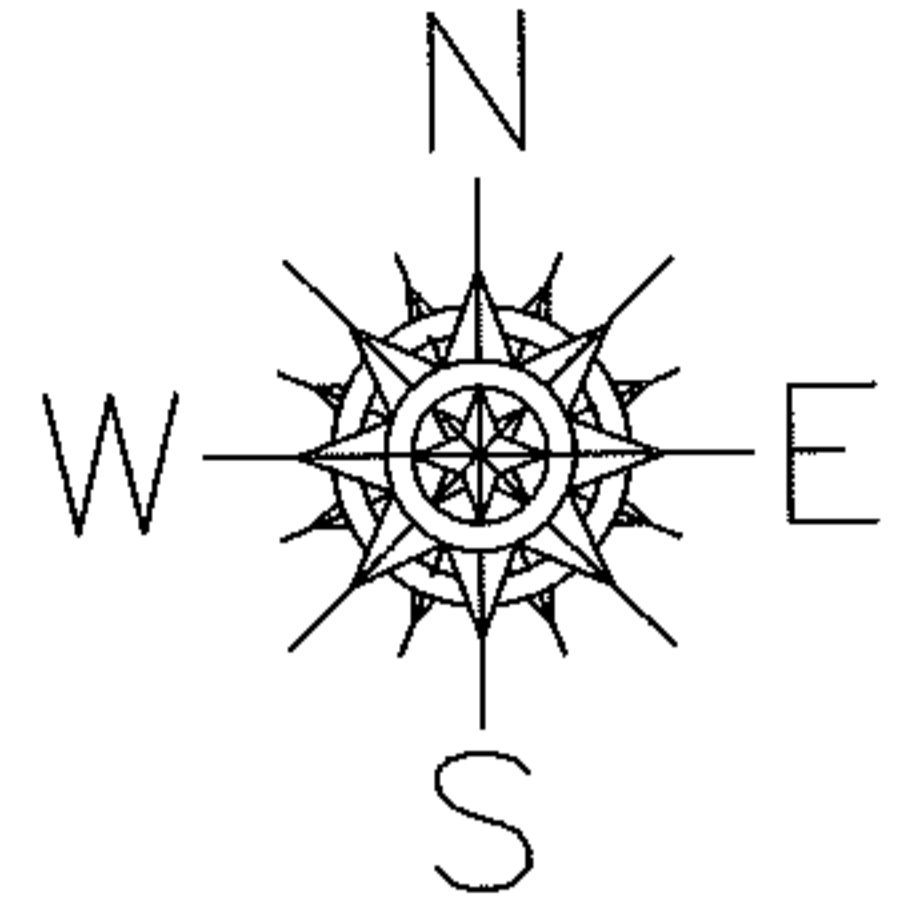

DEPTH CORRECTION

PER PRIOR DEEDS

03-00-029-103-008

53 X 113.29

~~53 X 113~~


03-00-029-103-009

53 X 113.12

~~53 X 113~~

\*DV 820/548

\*20060123081

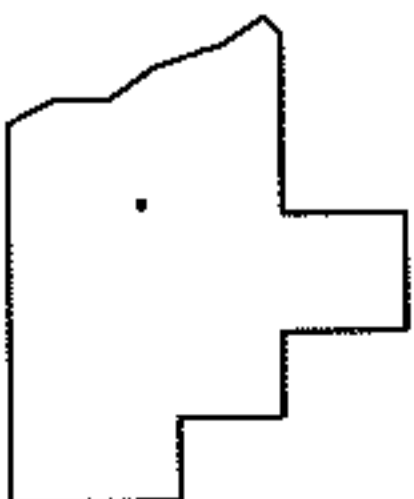

SPLITS/DEEDS PROCESSED

LORAIN COUNTY TAX MAP DEPARTMENT  
226 MIDDLE AVE. ELYRIA, OHIO

SURVEYED BY: N/A

CLOSURE: N/A

MAP PAGE(S): 3-00-029-A

APPROVED BY: RRM DATE: 12-8-10

SCALE: 1"= 50' PRIOR INST.: \*SEE ABOVE