
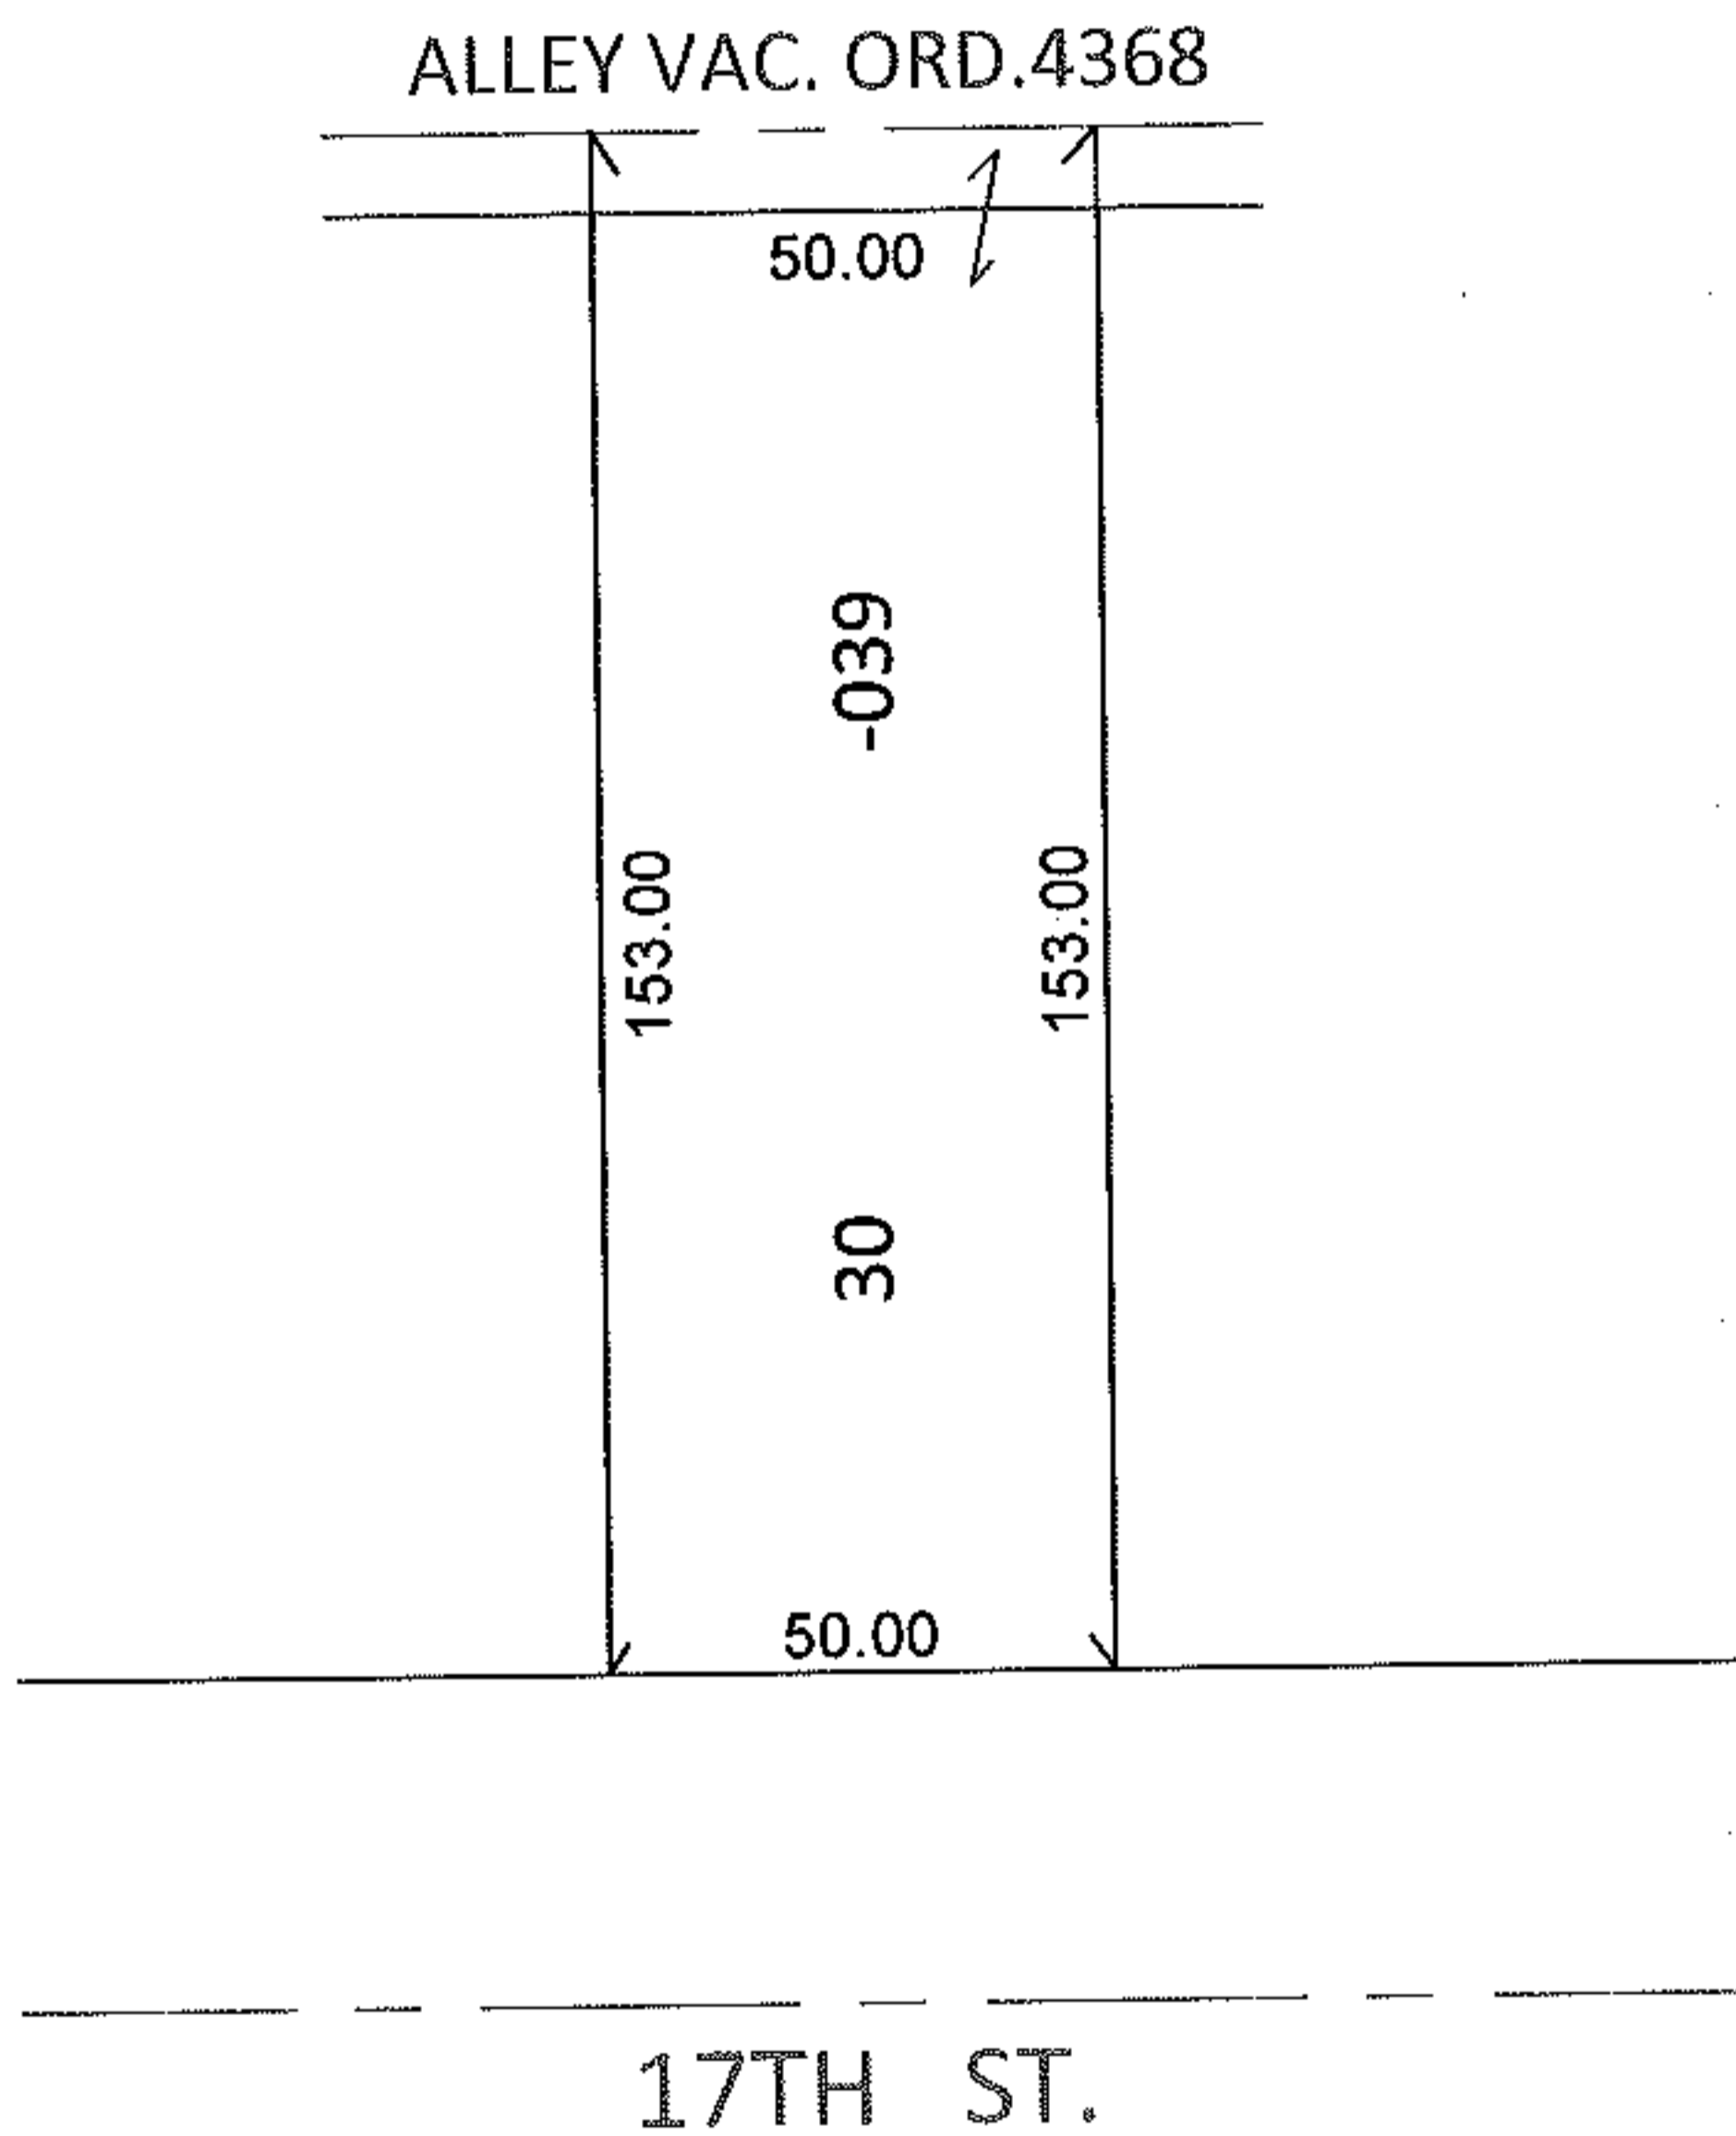


PARENT PARCEL: 02-01-006-130-039

CHILD PARCEL:

STARTING POINT: S/L 30 IN W.S.STREATOR TRUST SUB.(VOL.5 PG.11)

10-02138-C

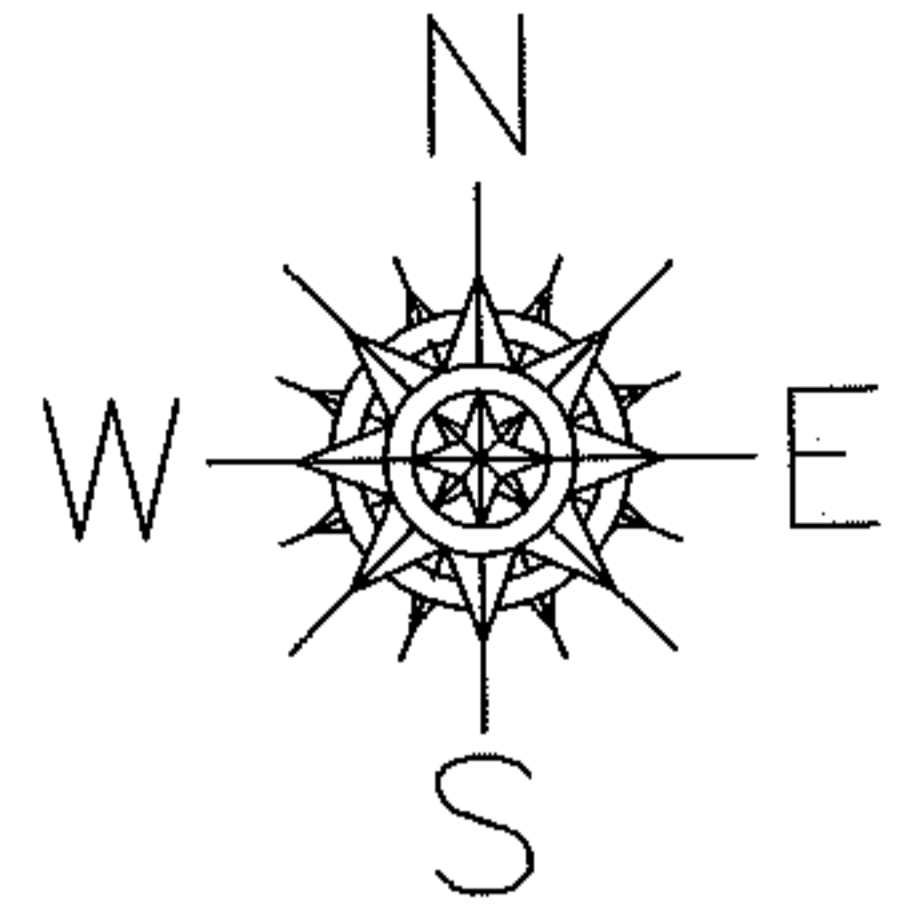


DEPTH CORRECTION

02-01-006-130-039

153

50 X ~~145~~

PER COURT CASE 10CV168203

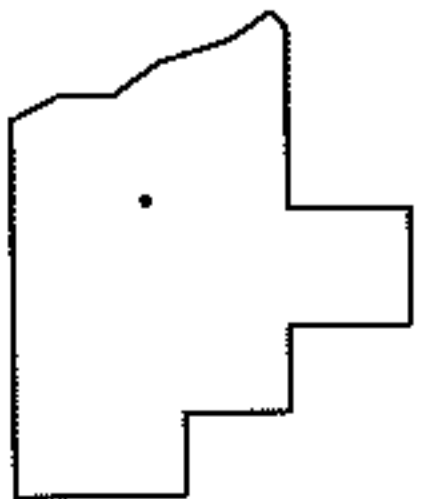

SPLITS/DEEDS PROCESSED

LORAIN COUNTY TAX MAP DEPARTMENT
226 MIDDLE AVE. ELYRIA, OHIO

SURVEYED BY: N/A

CLOSURE: N/A

MAP PAGE(S): 2-01-006-D

APPROVED BY: RRM DATE: 12-9-10

SCALE: 1"= 50' PRIOR INST.: 20090318452