
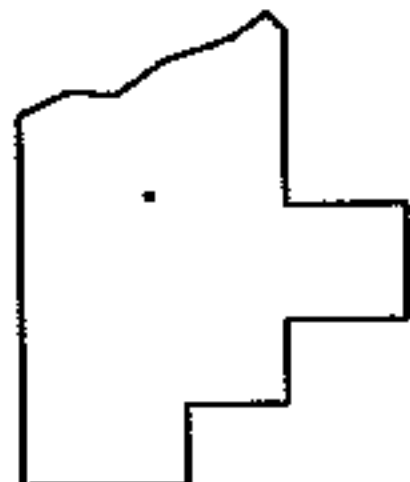
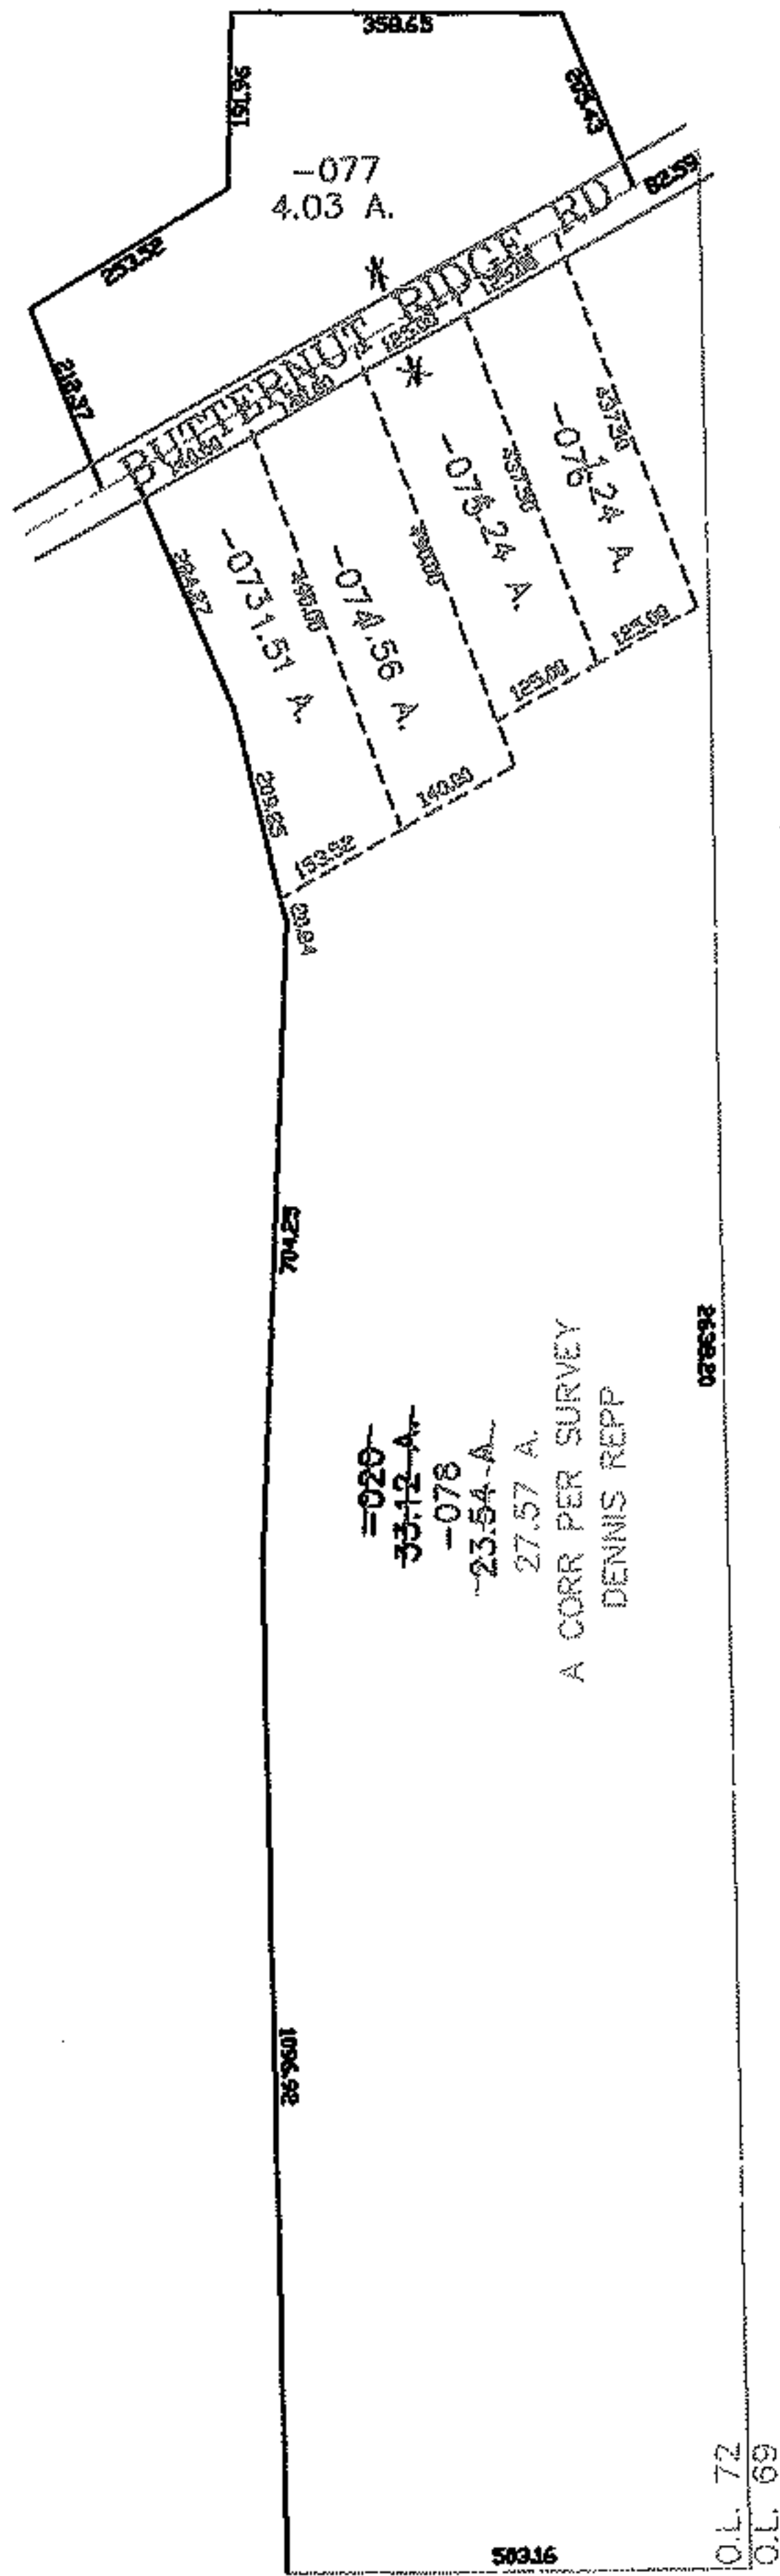


PARENT PARCEL: 11-00-072-000-020

CHILD PARCEL: 11-00-072-000-073 THRU -078

STARTING POINT: CENTERLINE OF BUTTERNUT RIDGE RD & O.L. 72

06-02142

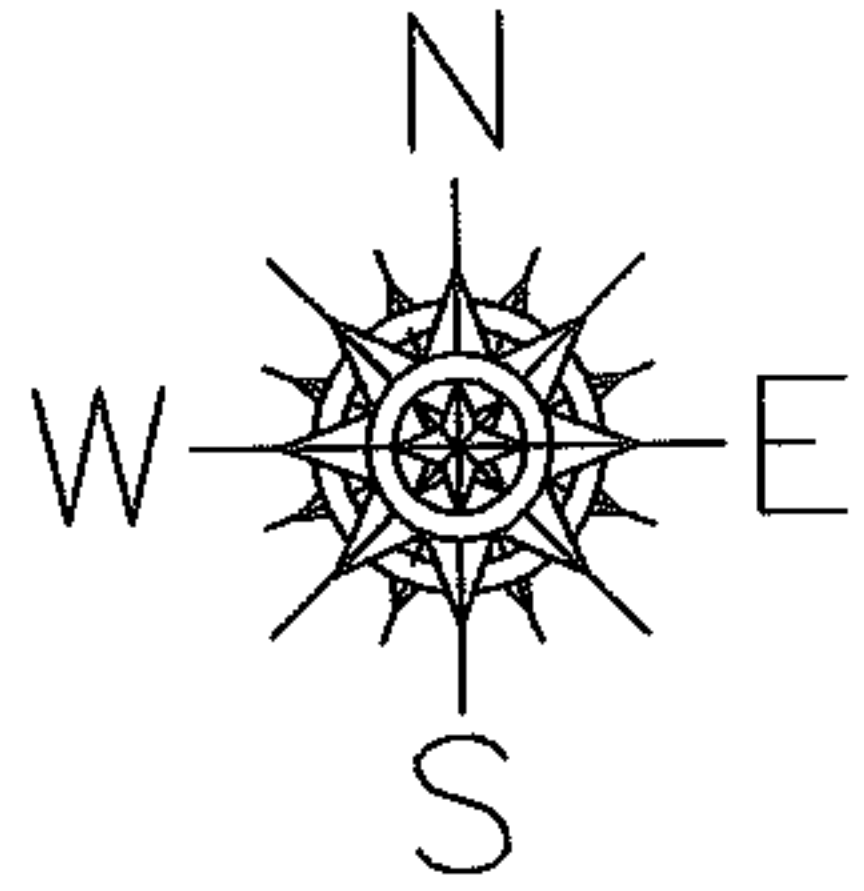

SPLITS/DEEDS PROCESSED
LORAIN COUNTY TAX MAP DEPARTMENT
226 MIDDLE AVE. ELYRIA, OHIO

SURVEYED BY: DENNIS REPP
CLOSURE: 0.00 : 10.000
MAP PAGE(S): 11-B
APPROVED BY: JAH DATE: 5-3-06
SCALE: 1" = 400 PRIOR INSTRUMENT: 20030972204