
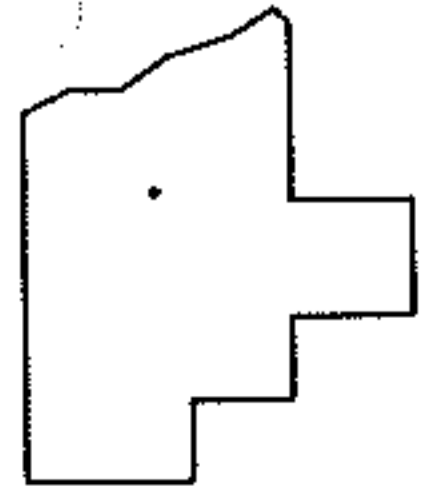
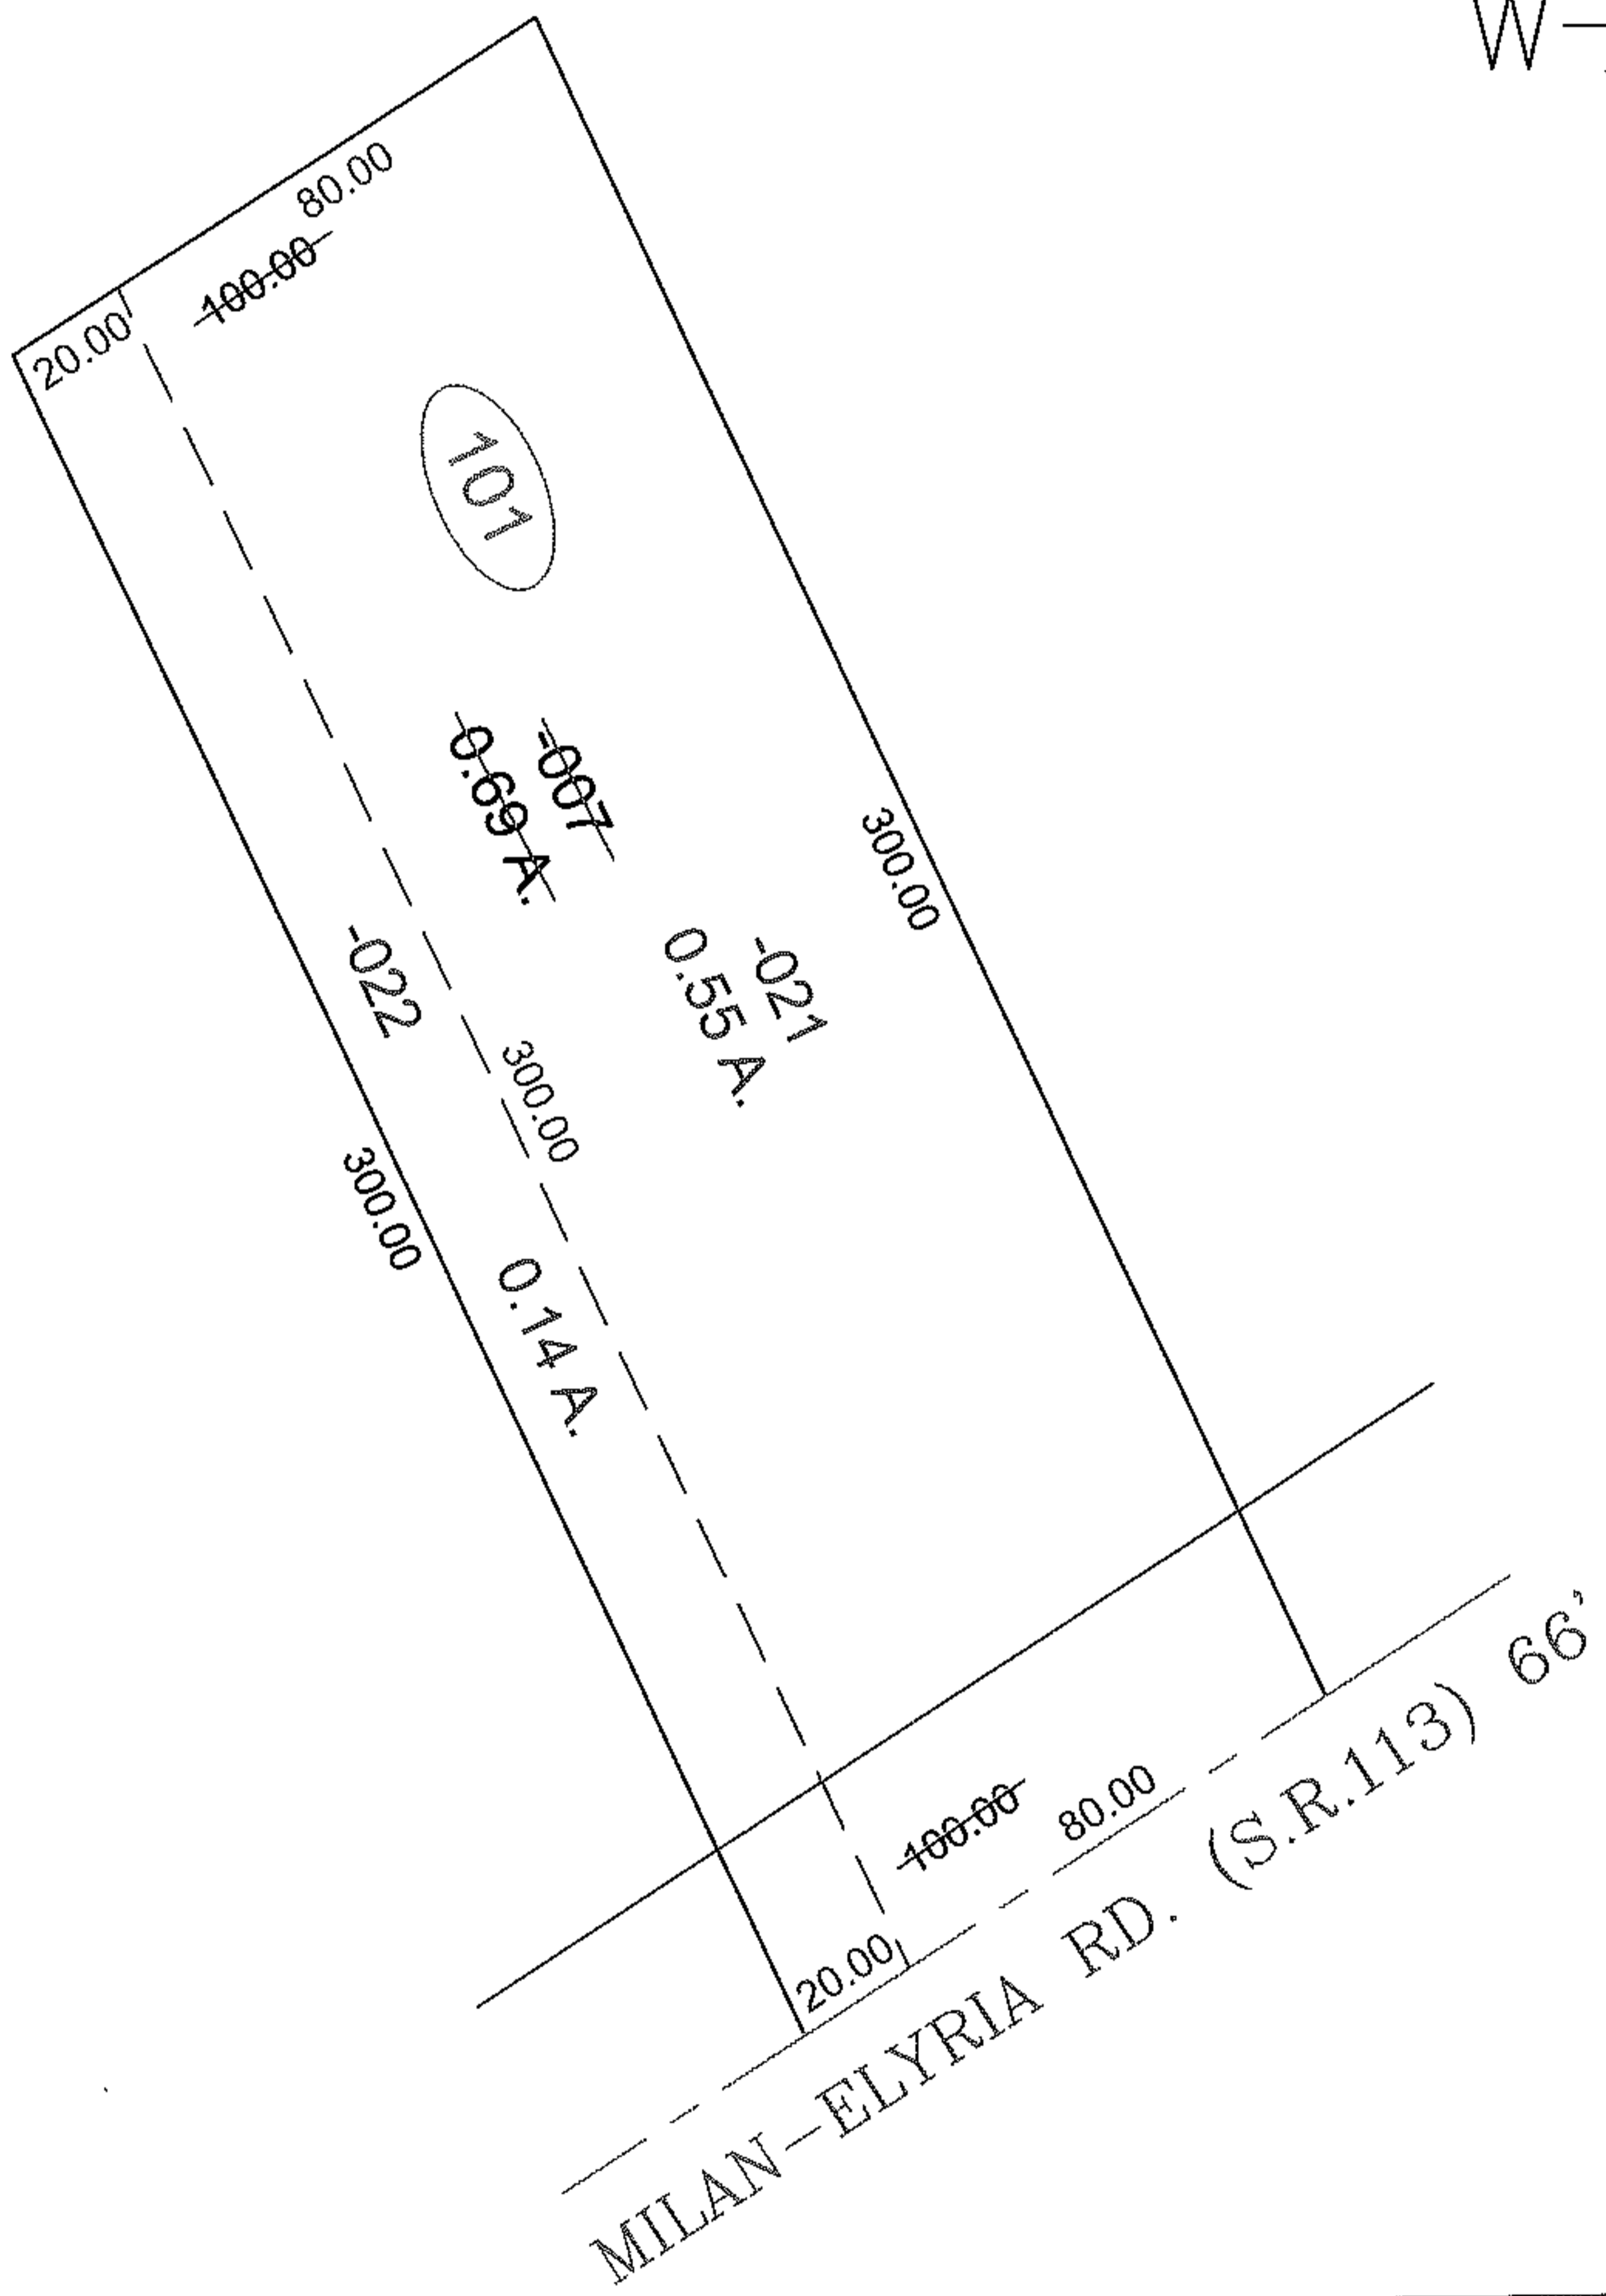


PARENT PARCEL: 09-00-001-101-007  
CHILD PARCEL: 09-00-001-101-021 & -022  
STARTING POINT: XXXXXX

10-02143-U

UNCOMBINATION

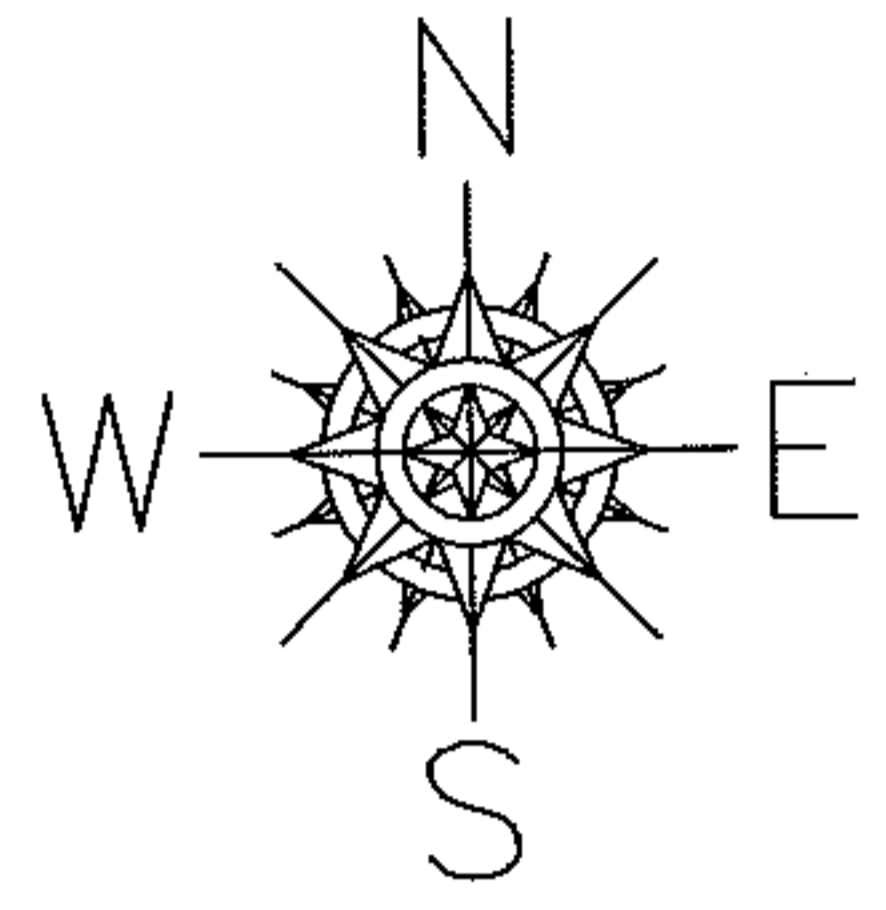

SPLITS/DEEDS PROCESSED

LORAIN COUNTY TAX MAP DEPARTMENT  
226 MIDDLE AVE. ELYRIA, OHIO

SURVEYED BY: C.T. BIGGS  
CLOSURE: 0.01 : 10,000  
MAP PAGE(S): 9-00-001-A  
APPROVED BY: TJS DATE: 12/3/10  
SCALE: 1"= 50' PRIOR INST.: DV 535/642