


PARENT PARCEL: 06-24-002-000-024 & 06-24-005-000-003
 CHILD PARCEL: XX-XX-XXX-XXX-XXX
 STARTING POINT: MON. BOX, CL OF WEST RIDGE RD. & SOUTH LINE OF O.L.2

10-02144-C

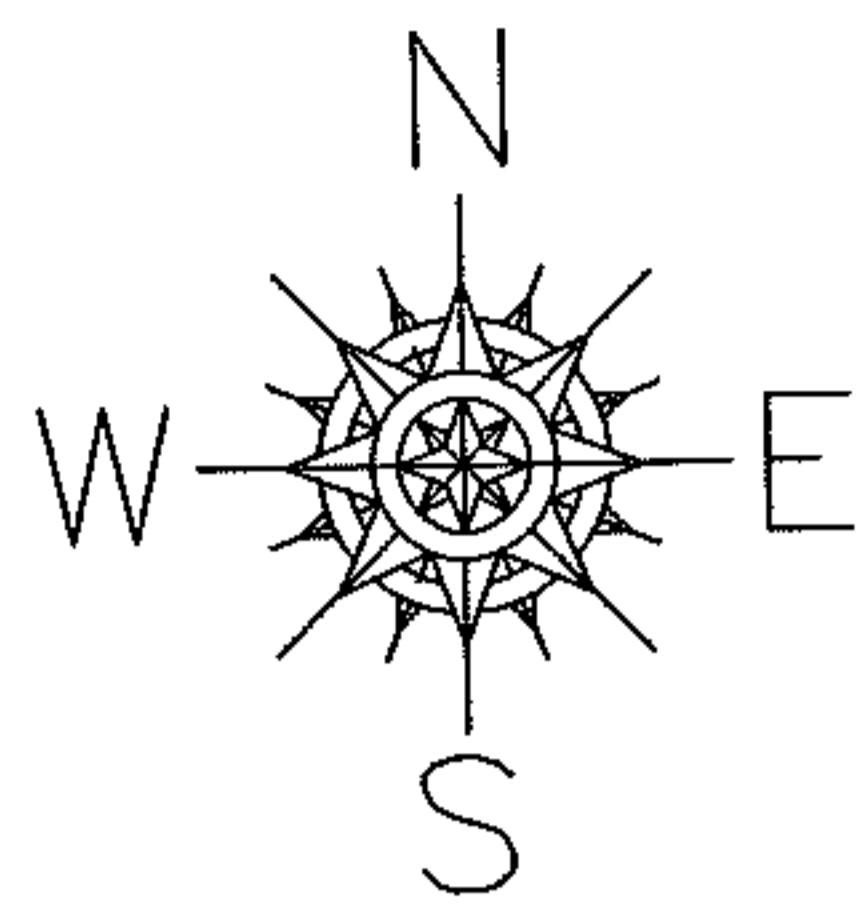



ACREAGE CORRECTION

06-24-002-000-024

~~47.31 A.~~

47.20 A.

AC. CORR. PER SURV.
 DAVID L. ELWELL

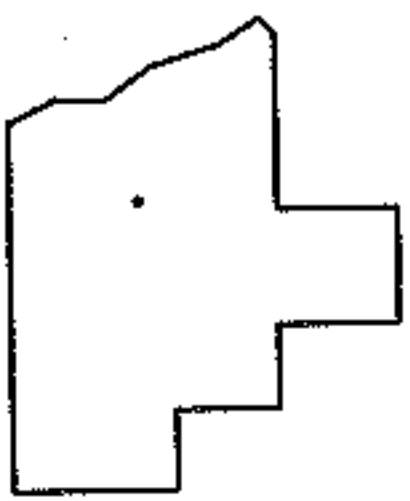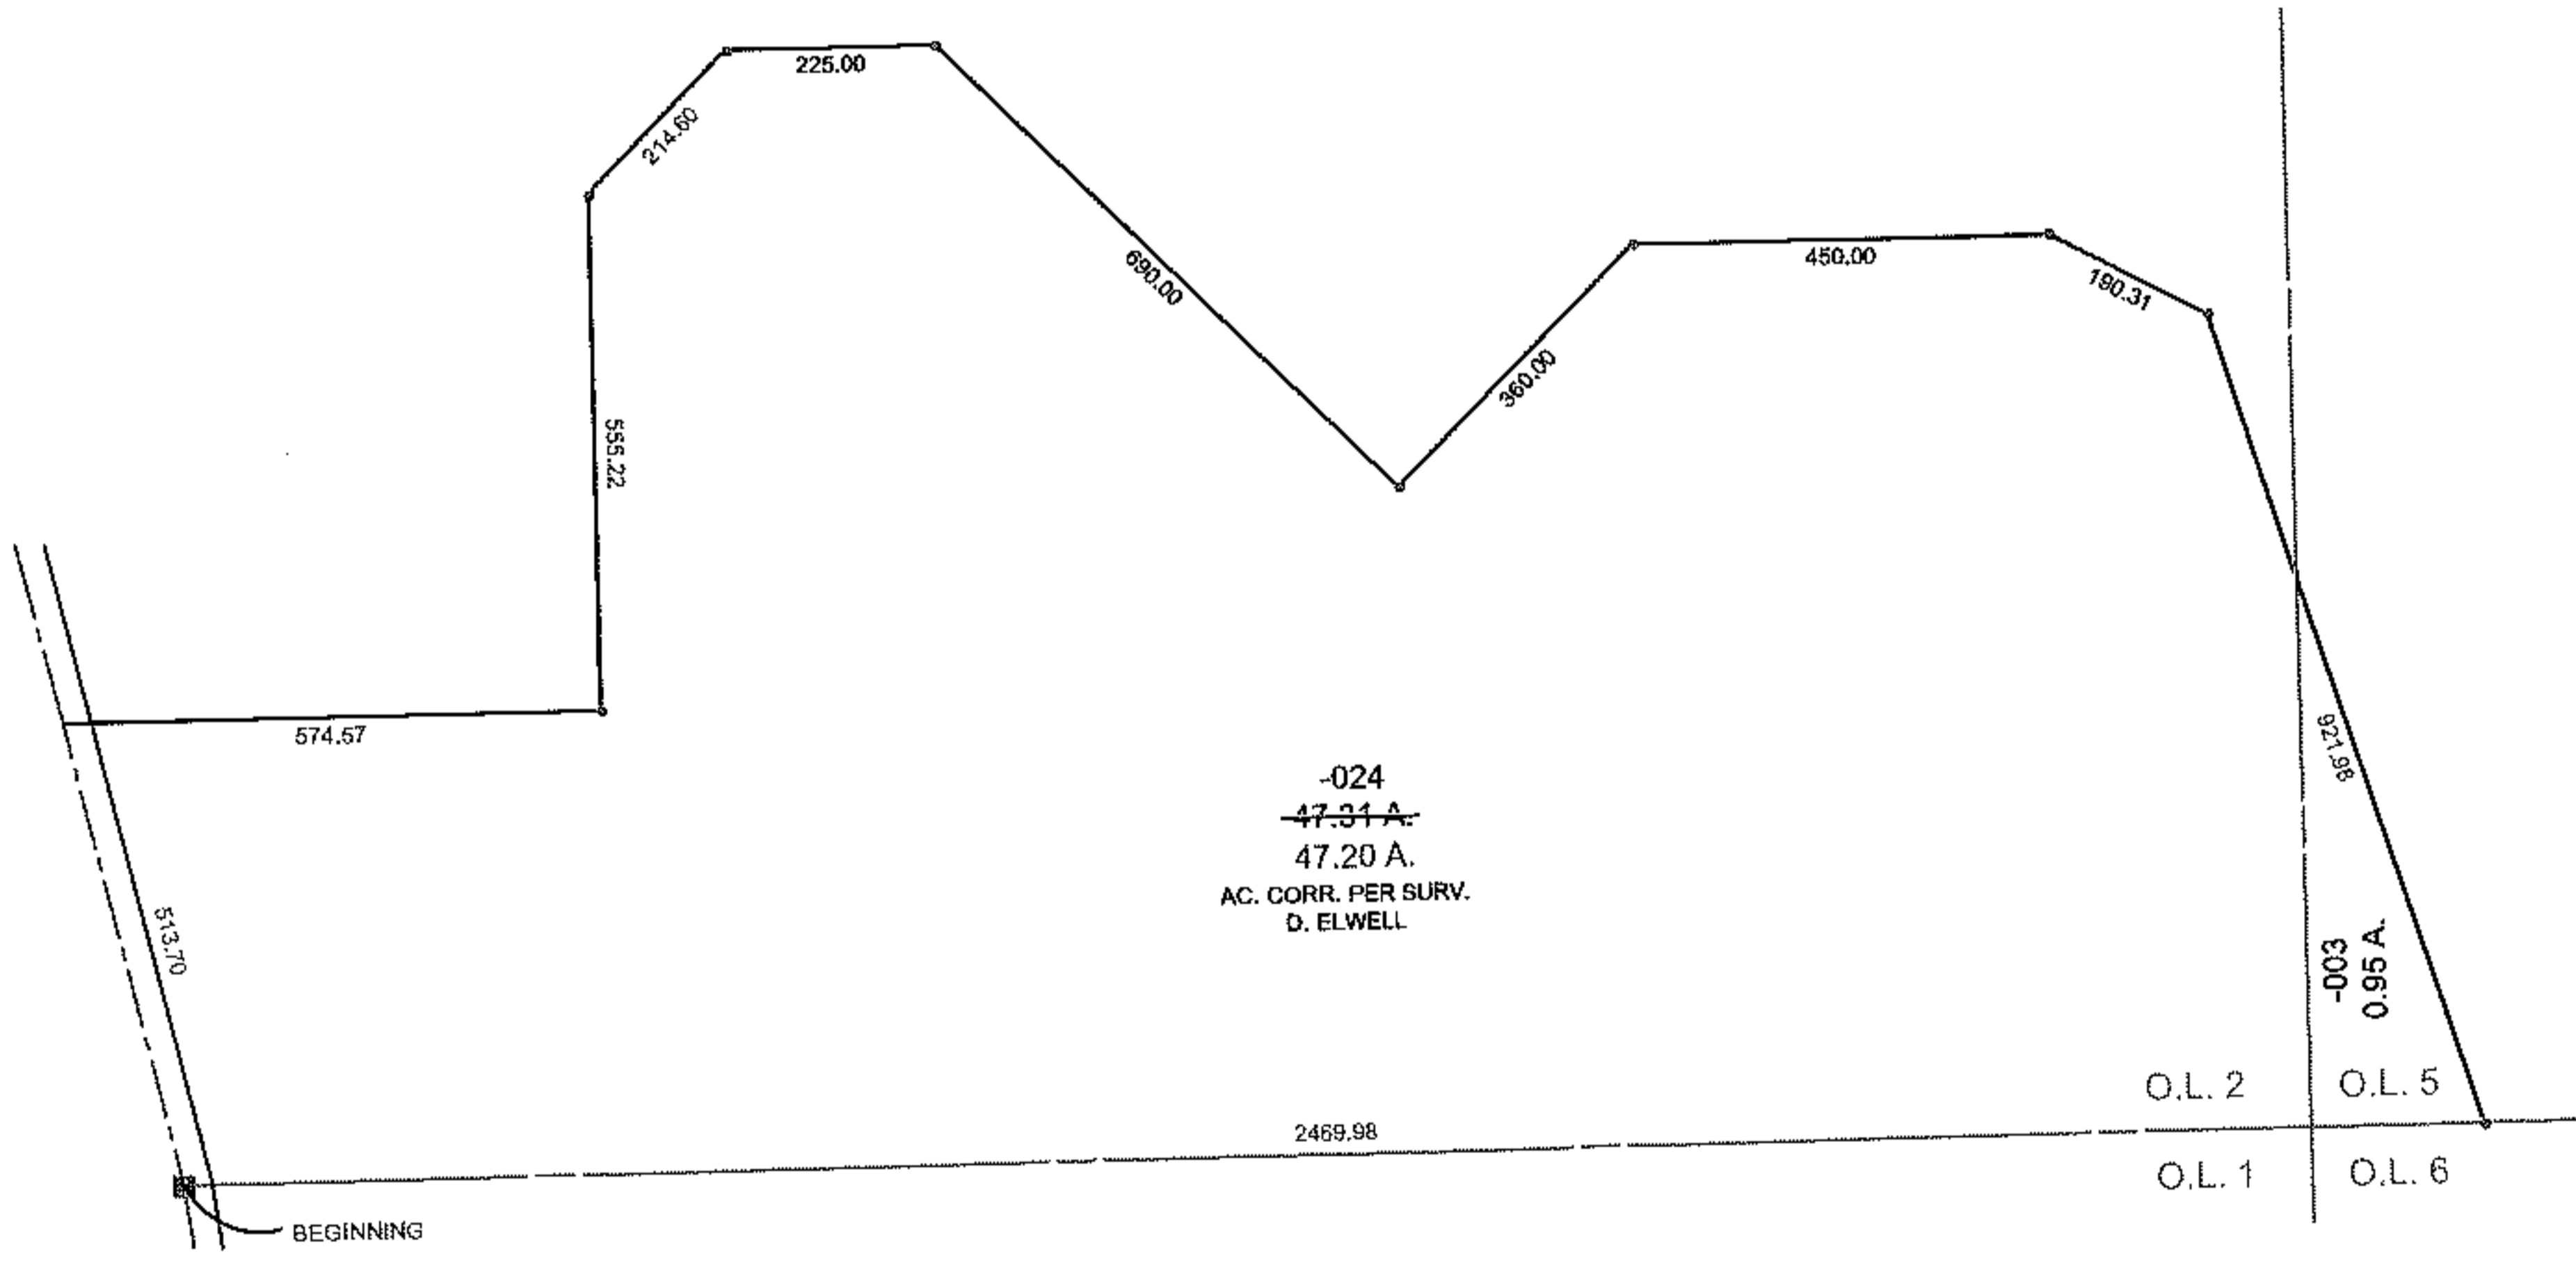

SPLITS/DEEDS PROCESSED
 LORAIN COUNTY TAX MAP DEPARTMENT
 226 MIDDLE AVE. ELYRIA, OHIO

SURVEYED BY: DAVID L. ELWELL
 CLOSURE: 0.01 : 10.000
 MAP PAGE(S): 6-128, 6-129 & 6-130
 APPROVED BY: TJS DATE: 12/7/10
 SCALE: 1" = 400 PRIOR INSTRUMENT: OR 940/576