
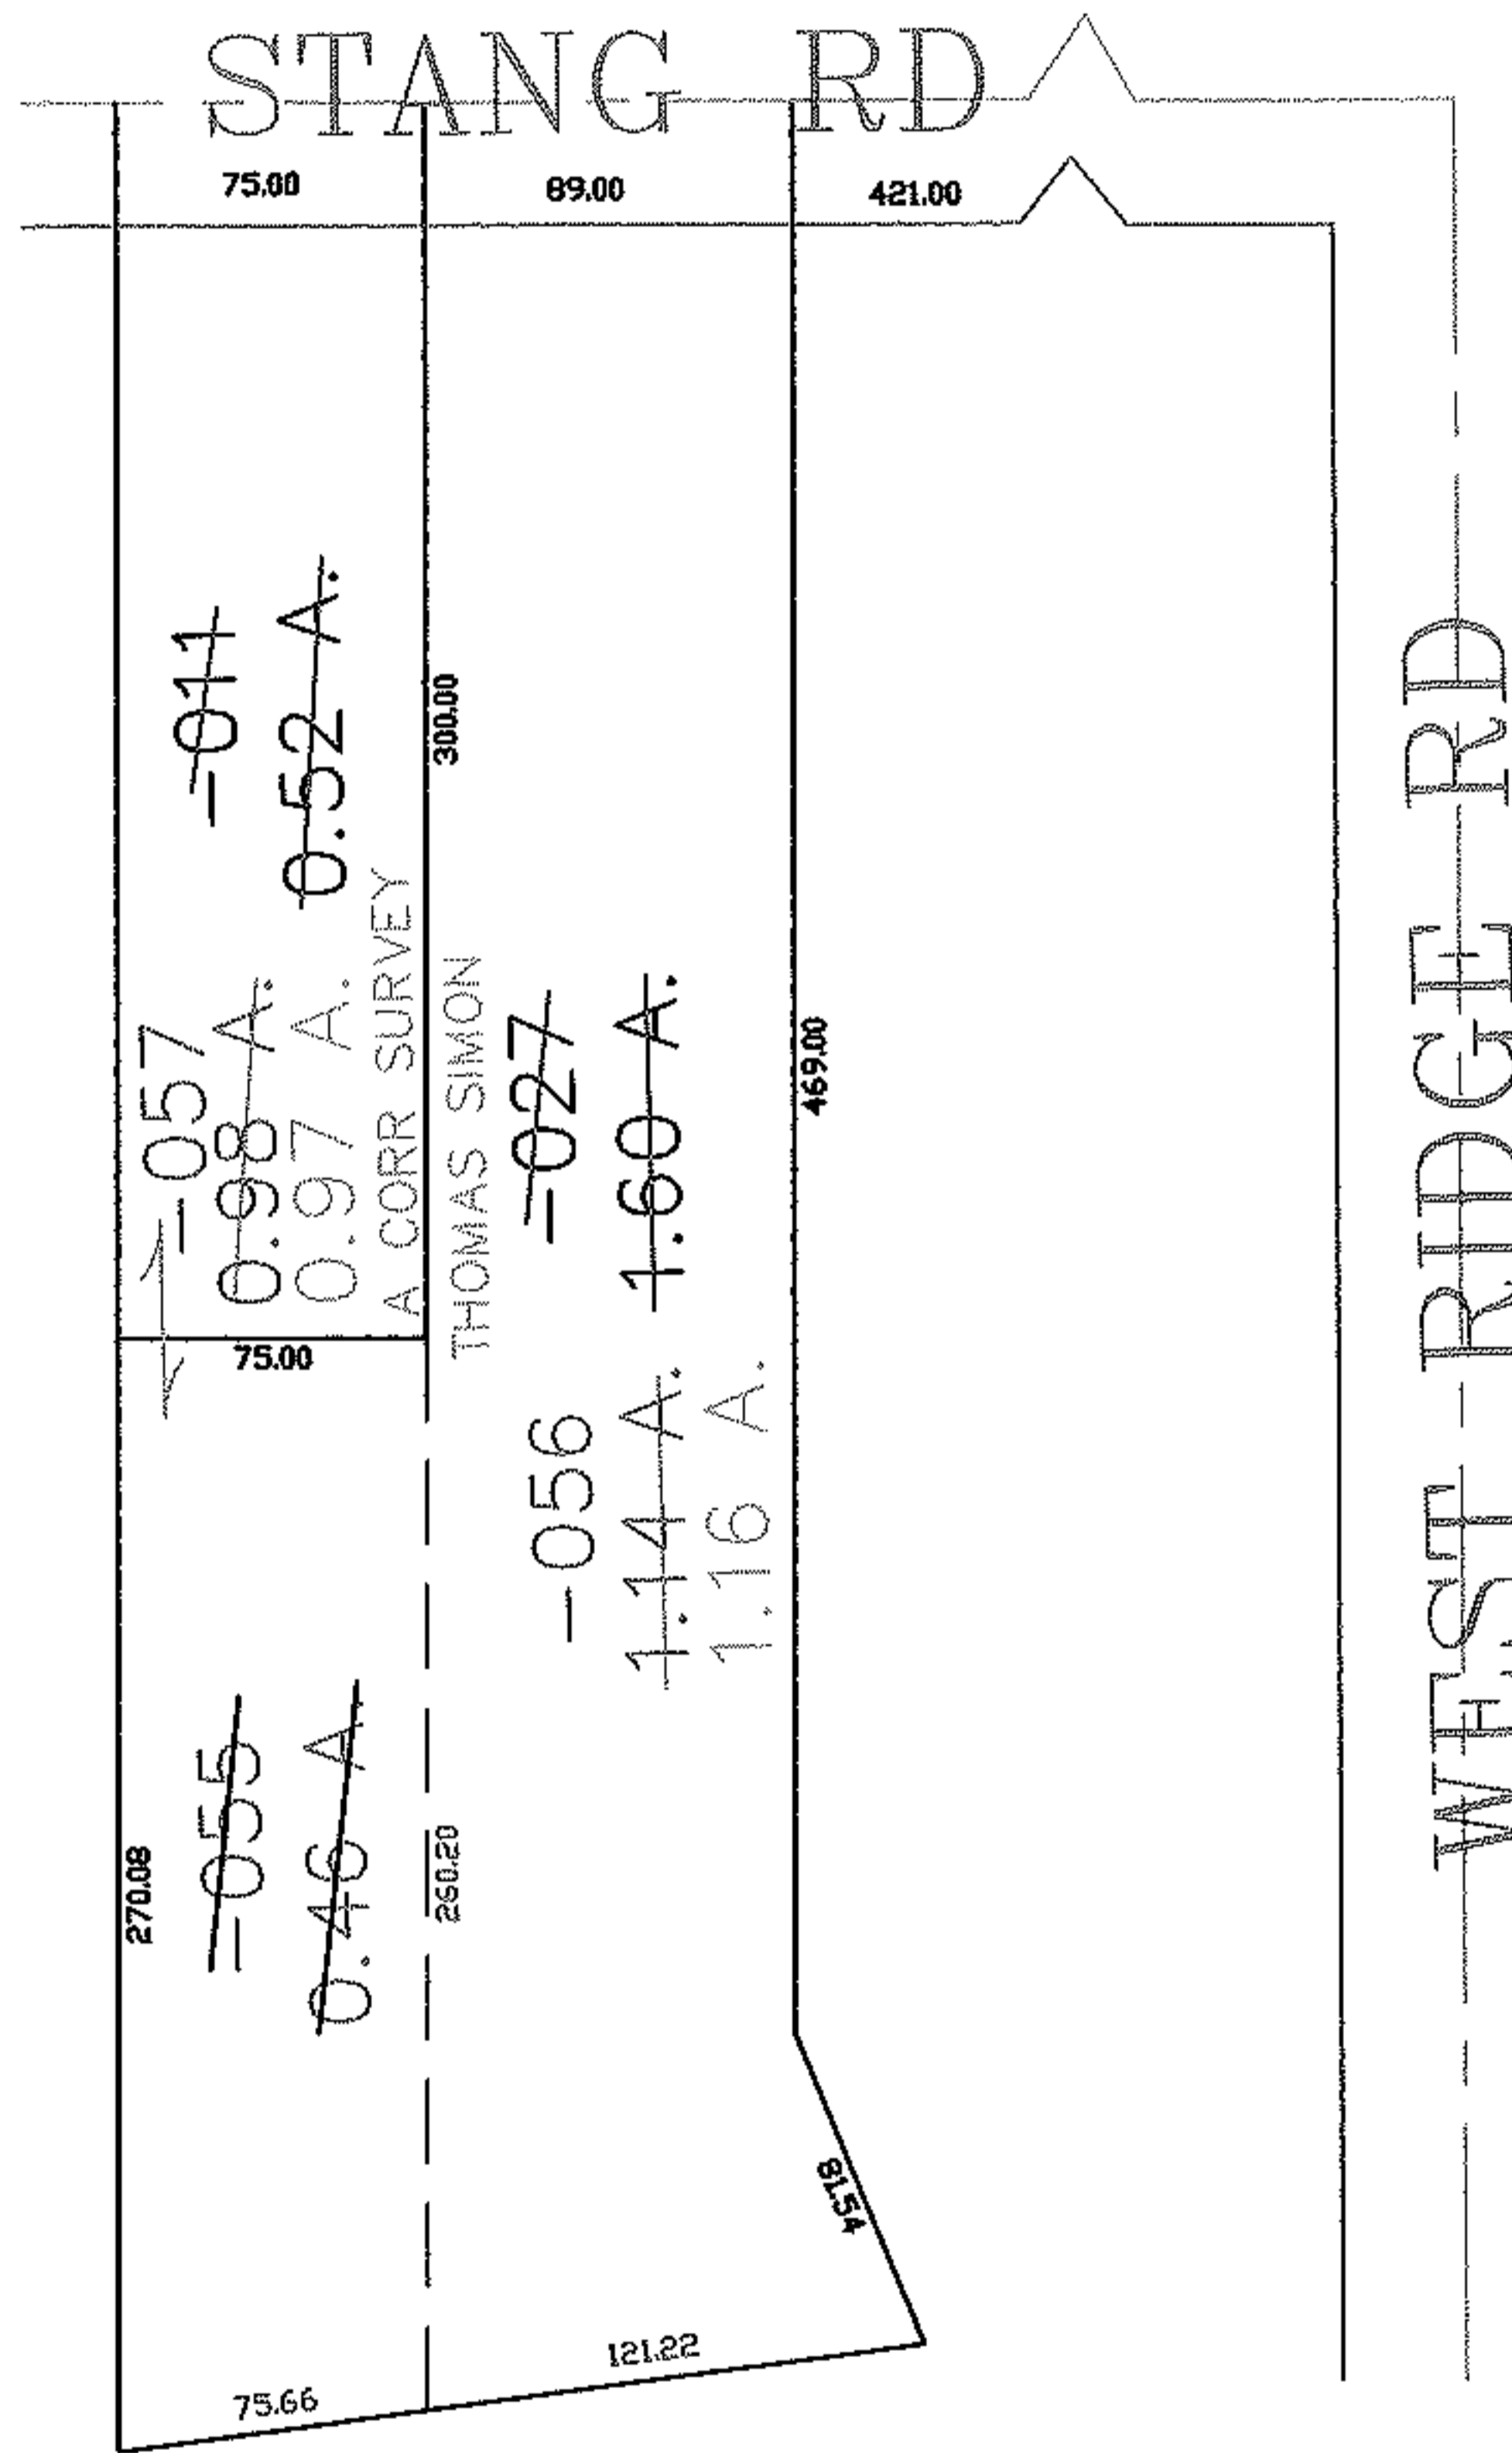


PARENT PARCEL: 05-00-085-000-027, -011  
CHILD PARCEL: 05-00-085-000-055 THRU -057  
STARTING POINT: CENTERLINE OF STANG RD & WEST RIDGE RD

06-02149

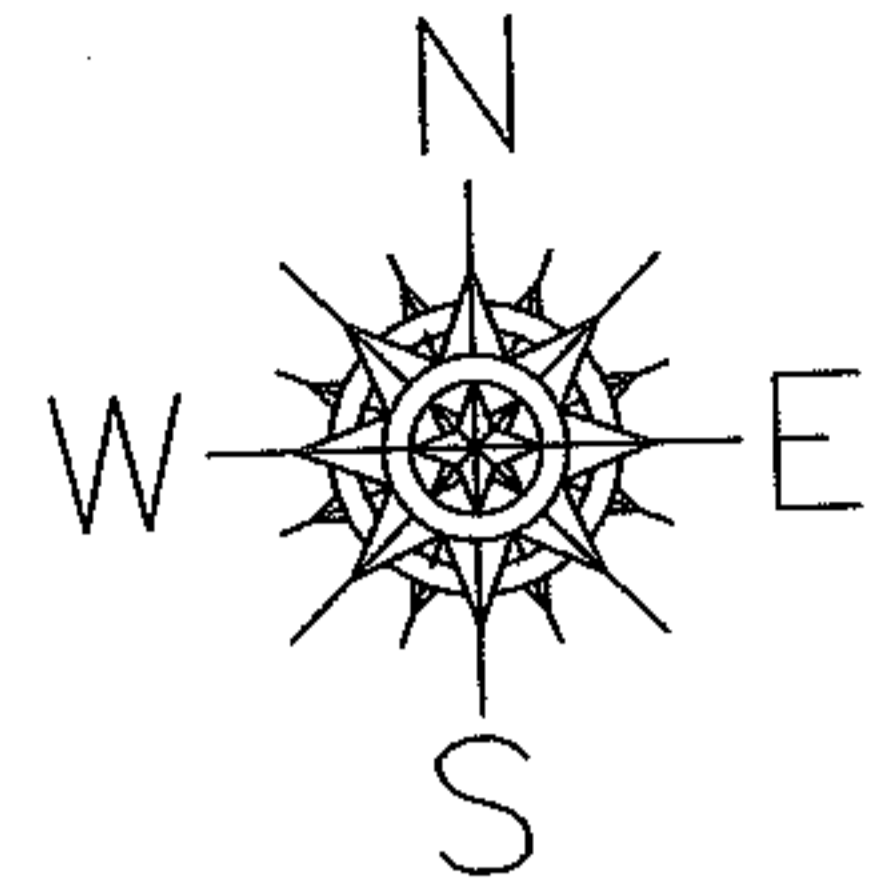

**SPLITS/DEEDS PROCESSED**

LORAIN COUNTY TAX MAP DEPARTMENT  
226 MIDDLE AVE. ELYRIA, OHIO

SURVEYED BY: THOMAS SIMON  
CLOSURE: 1:10.000  
MAP PAGE(S): 05-00-085  
APPROVED BY: JAH DATE: 5/15/06  
SCALE: 1" = 100' PRIOR INSTRUMENT: DV XXXX/XXX