
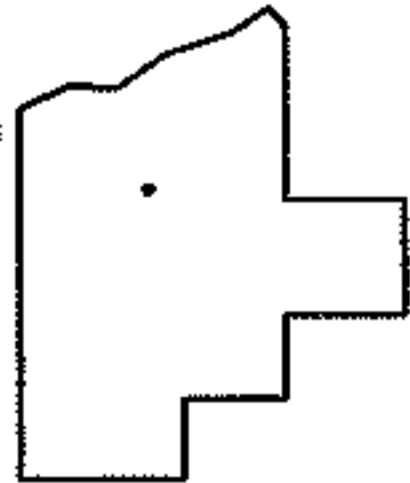
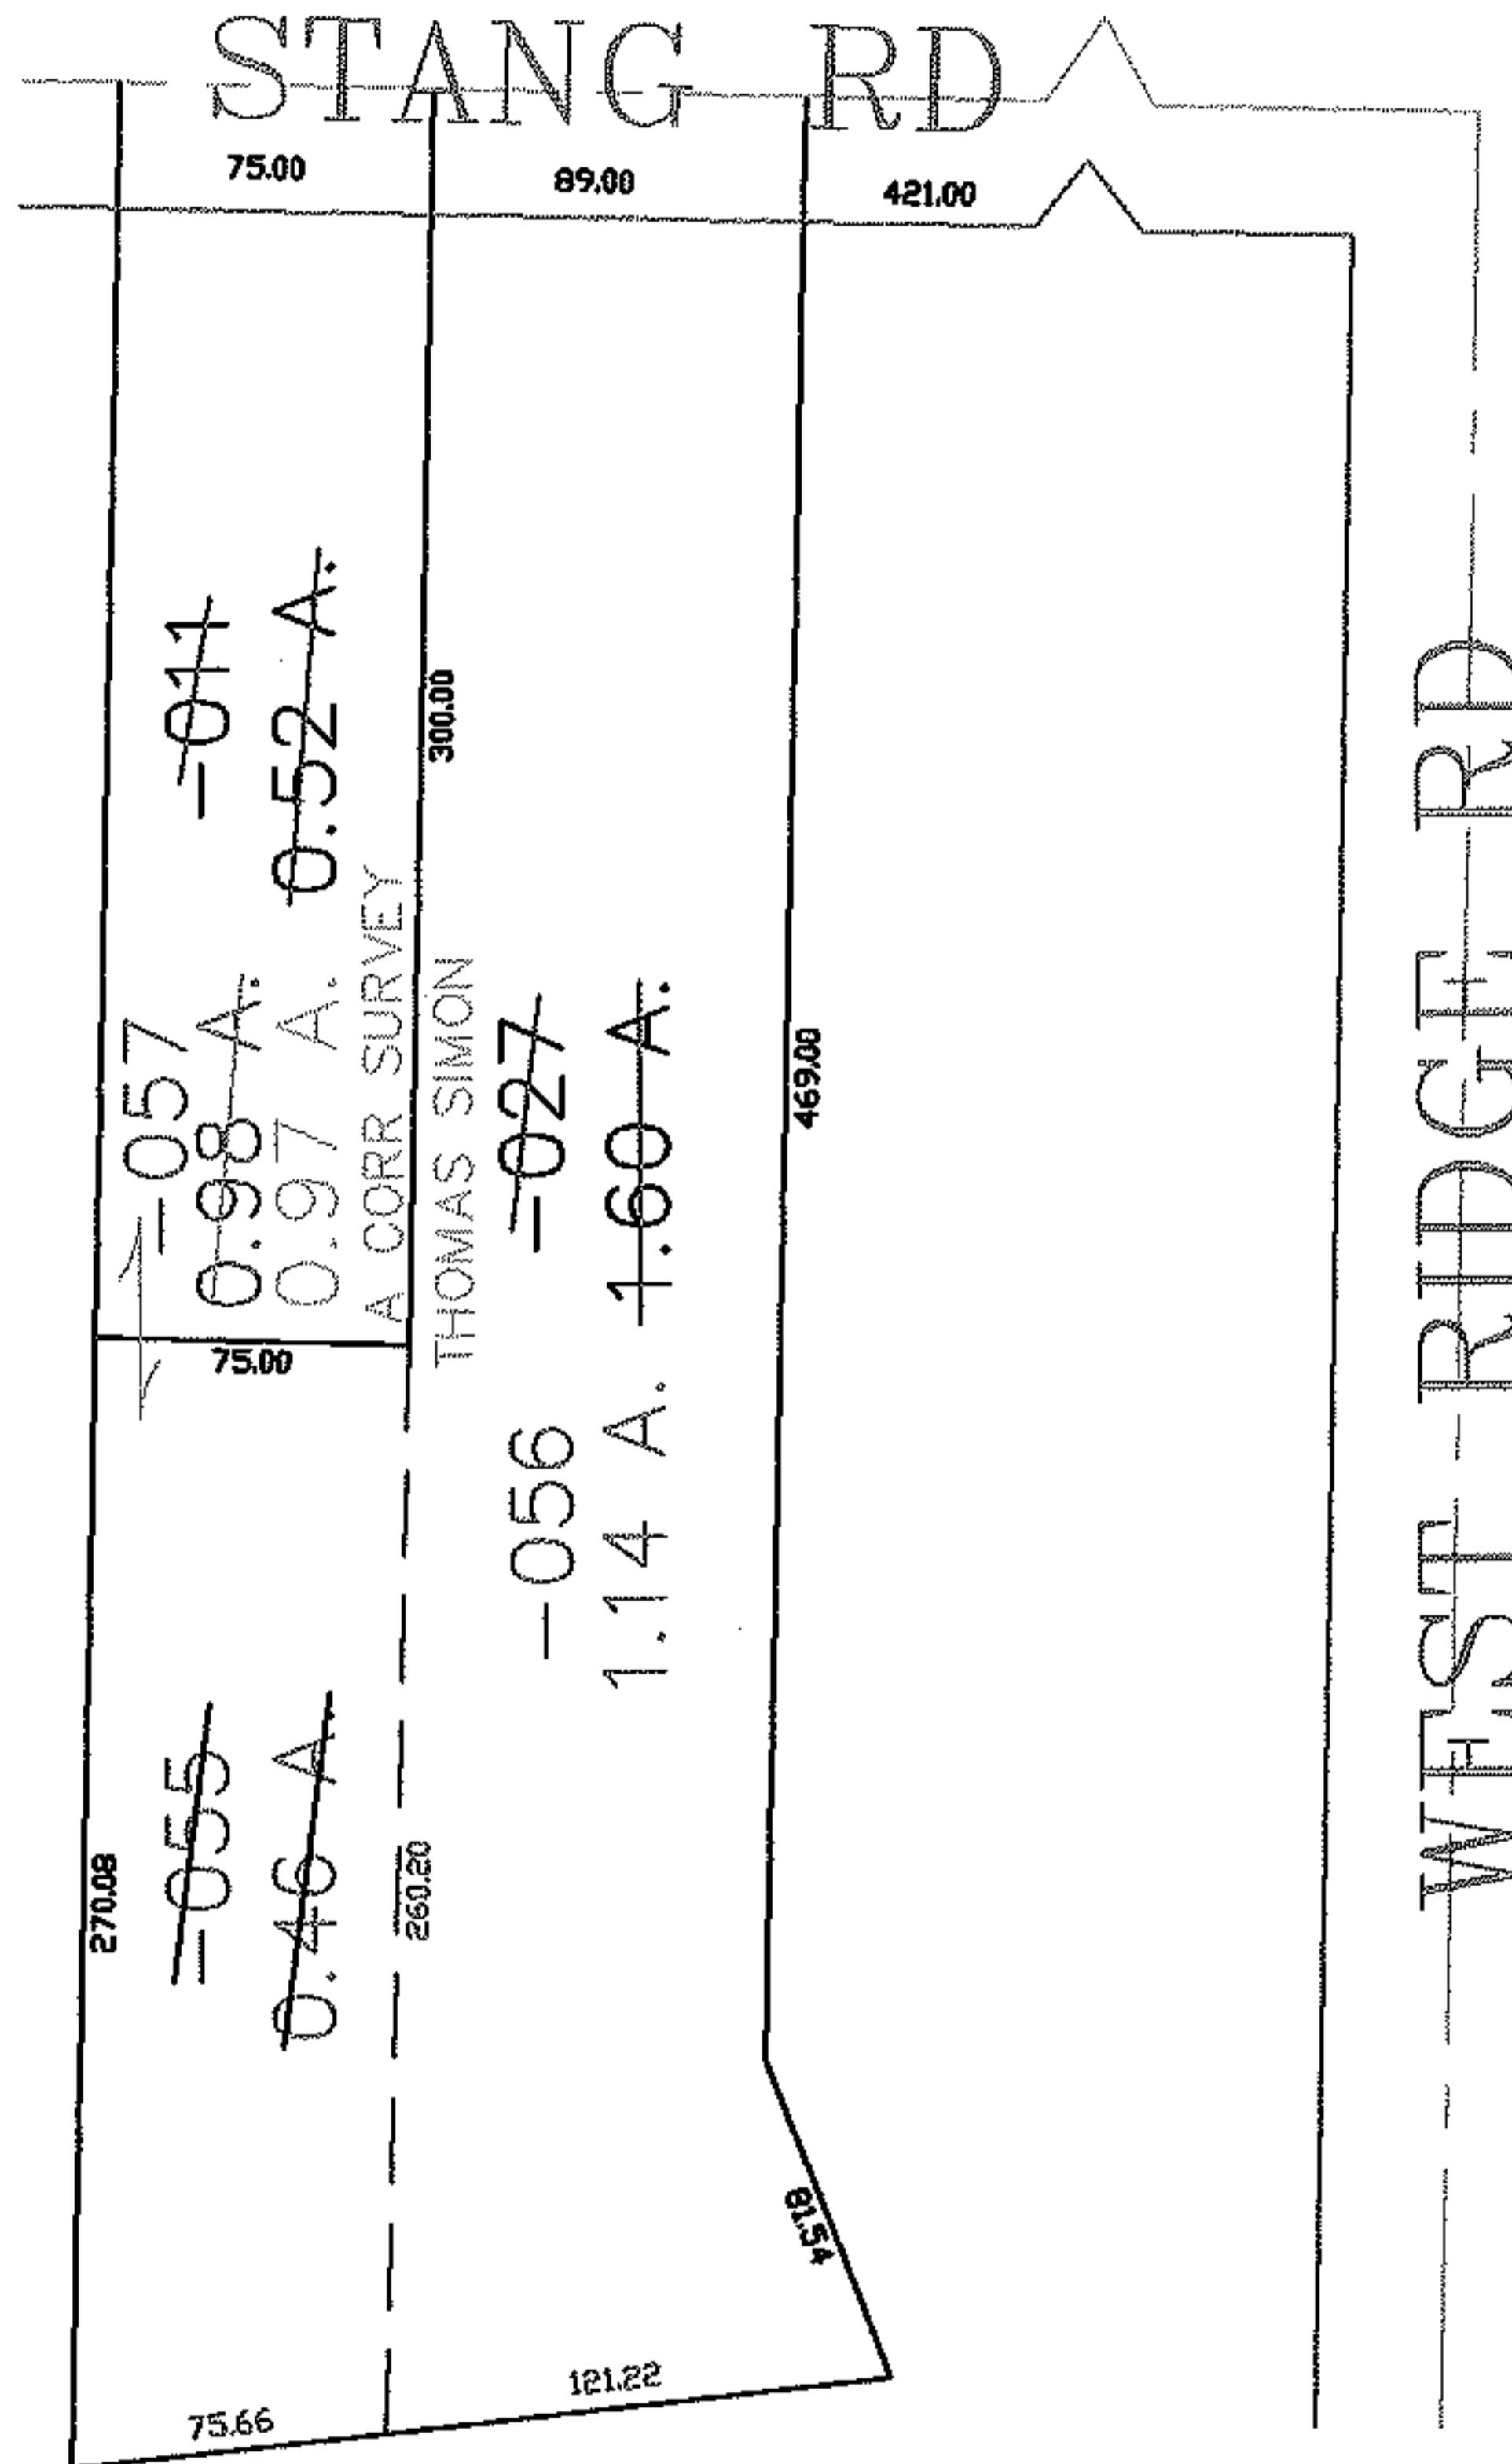


PARENT PARCEL: 05-00-085-000-027, -011

CHILD PARCEL: 05-00-085-000-055 THRU -057

STARTING POINT: CENTERLINE OF STANG RD & WEST RIDGE RD

06-02149

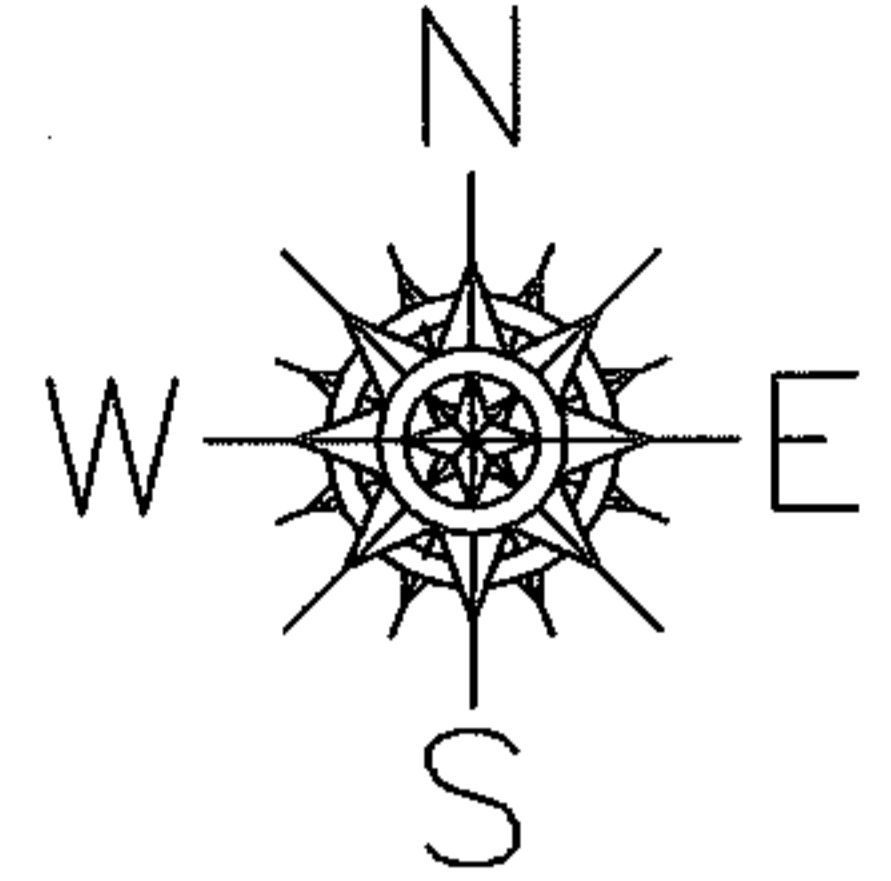

SPLITS/DEEDS PROCESSED

LORAIN COUNTY TAX MAP DEPARTMENT
226 MIDDLE AVE. ELYRIA, OHIO

SURVEYED BY: XXXXXXXXXX
 CLOSURE: XXXXXX
 MAP PAGE(S): XX-XX-XXX
 APPROVED BY: XXX DATE: XX/XX/XX
 SCALE: 1" = 100' PRIOR INSTRUMENT: DV XXXX/XXX