
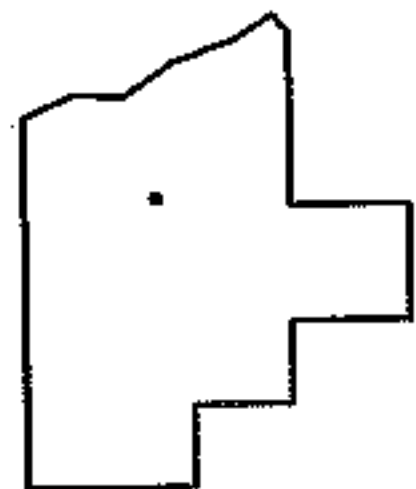
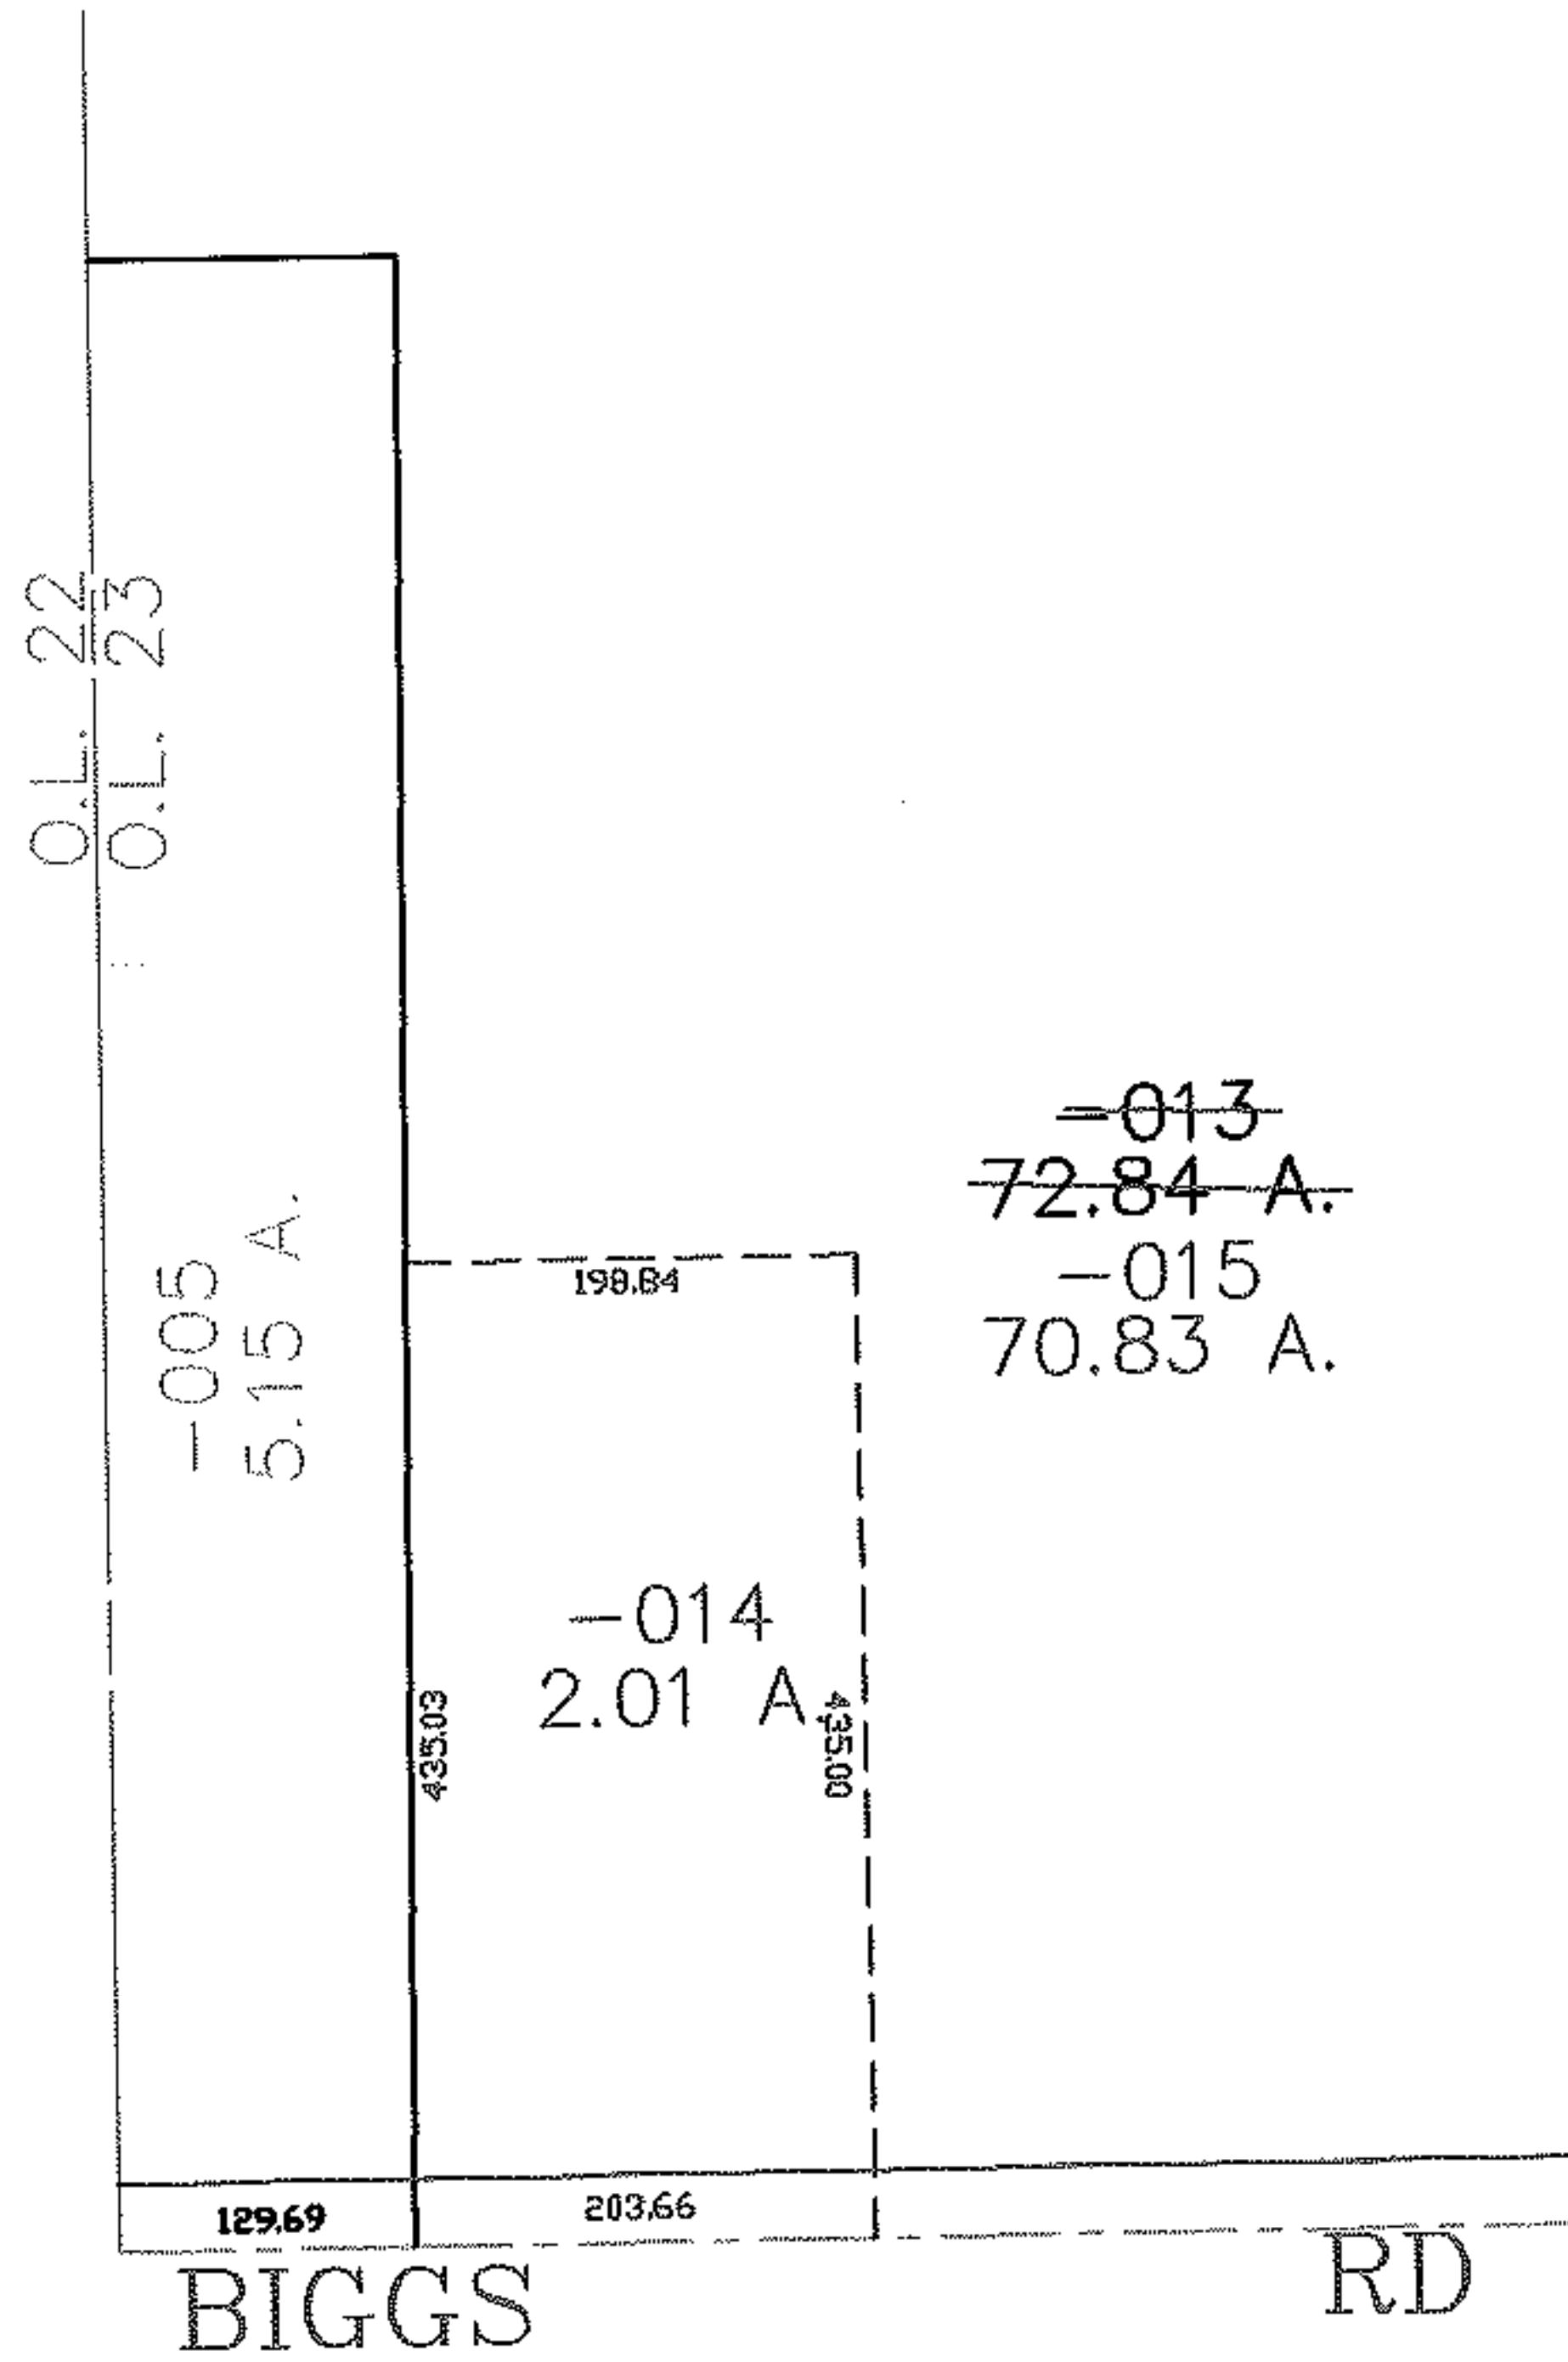


PARENT PARCEL: 15-00-023-000-013

CHILD PARCEL: 15-00-023-000-014, -015

STARTING POINT: CENTERLINE OF BIGGS RD & O.L. 23

06-02154

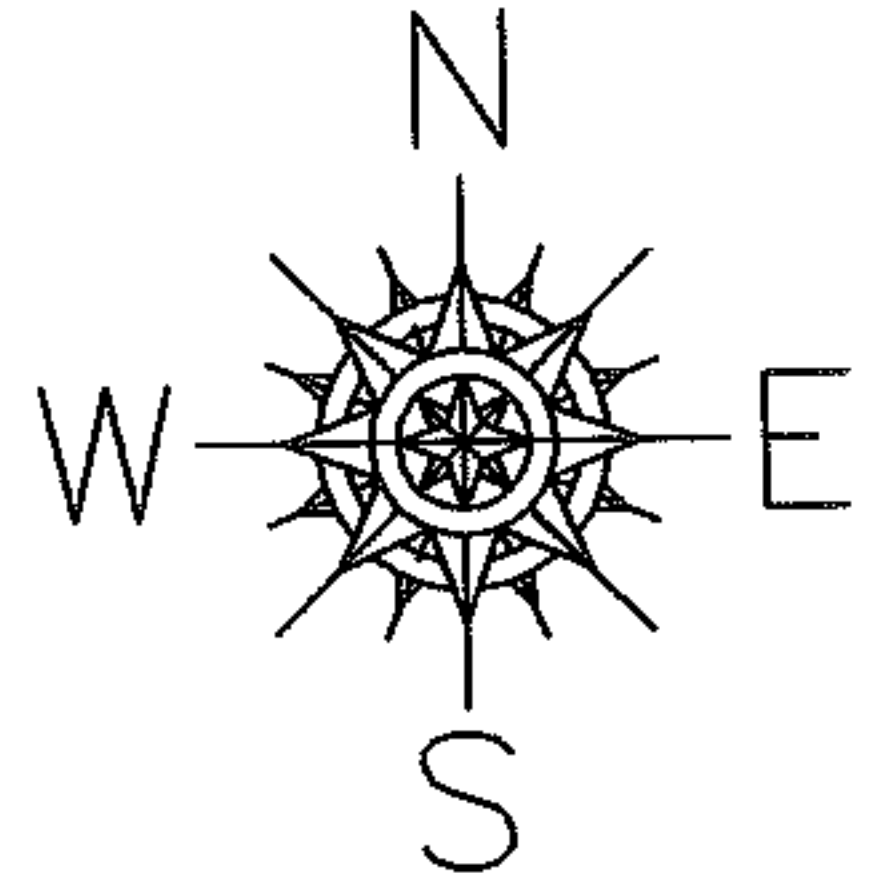

**SPLITS/DEEDS PROCESSED**  
 LORAIN COUNTY TAX MAP DEPARTMENT  
 226 MIDDLE AVE. ELYRIA, OHIO

SURVEYED BY: DANE HAPONEK  
 CLOSURE: 0.00 : 10.000  
 MAP PAGE(S): 15-A  
 APPROVED BY: JAH DATE: 5-17-06  
 SCALE: 1" = 200 PRIOR INSTRUMENT: 2005096336