
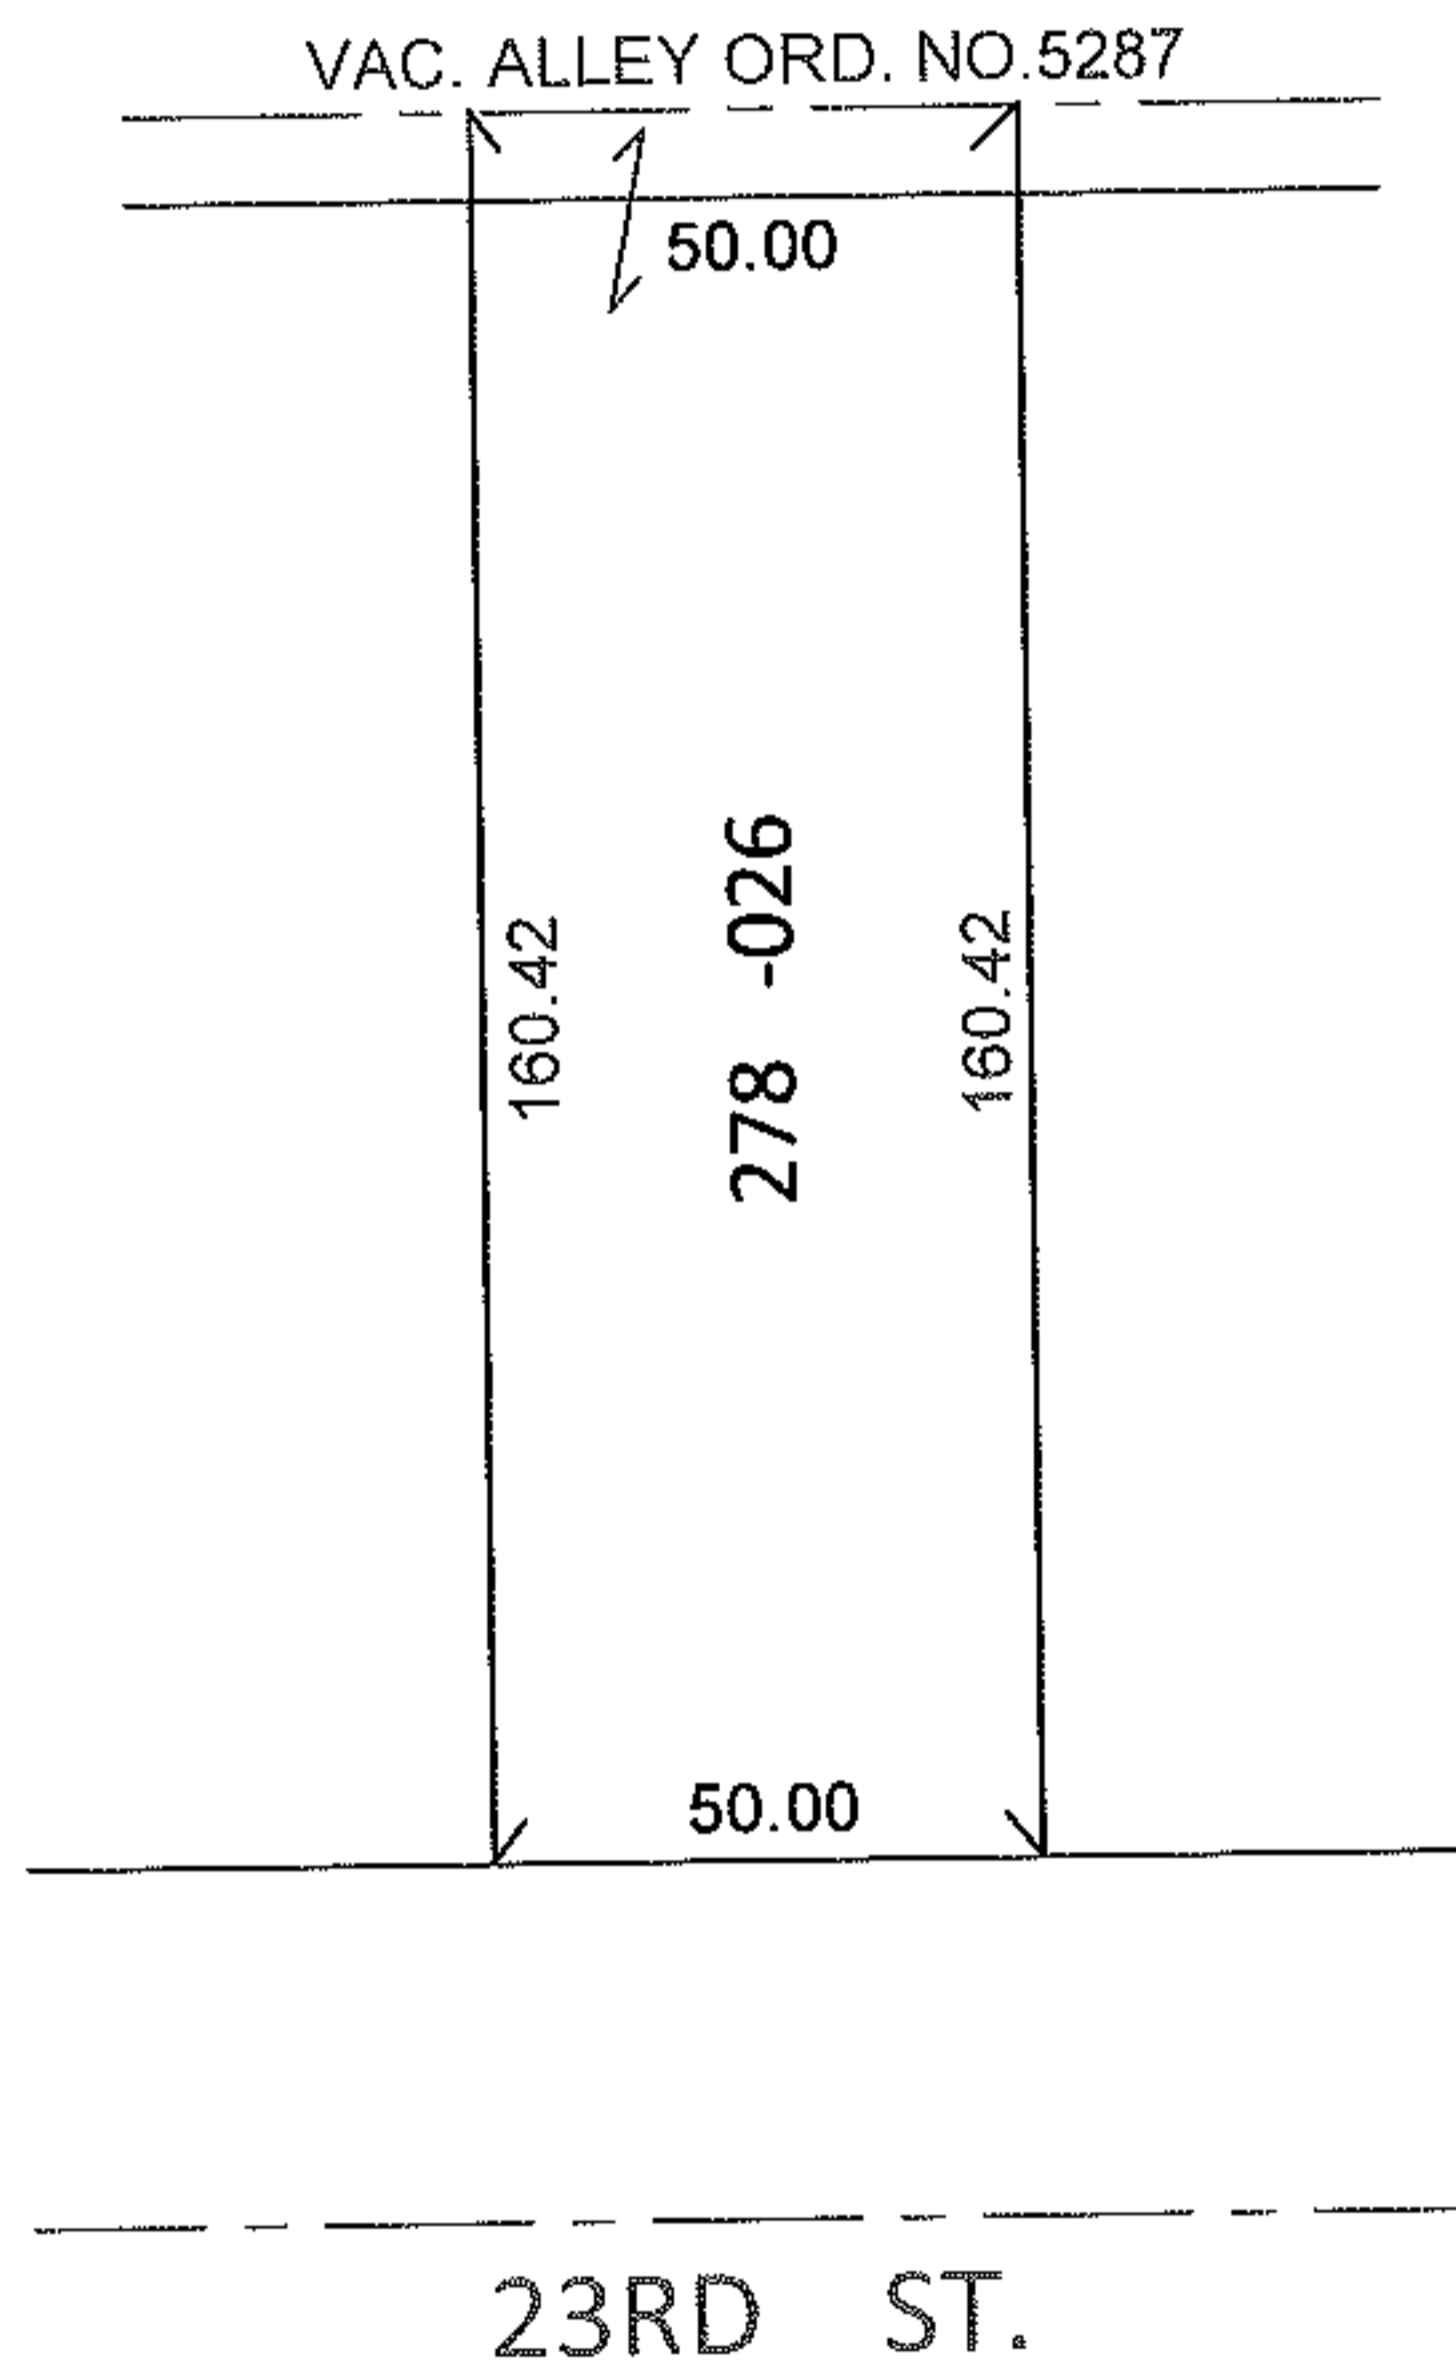


PARENT PARCEL: 02-01-006-152-026

CHILD PARCEL: _____

STARTING POINT: S/L 278 IN STANG'S SECOND ADD.(VOL.4 PG.18)

10-02156-C

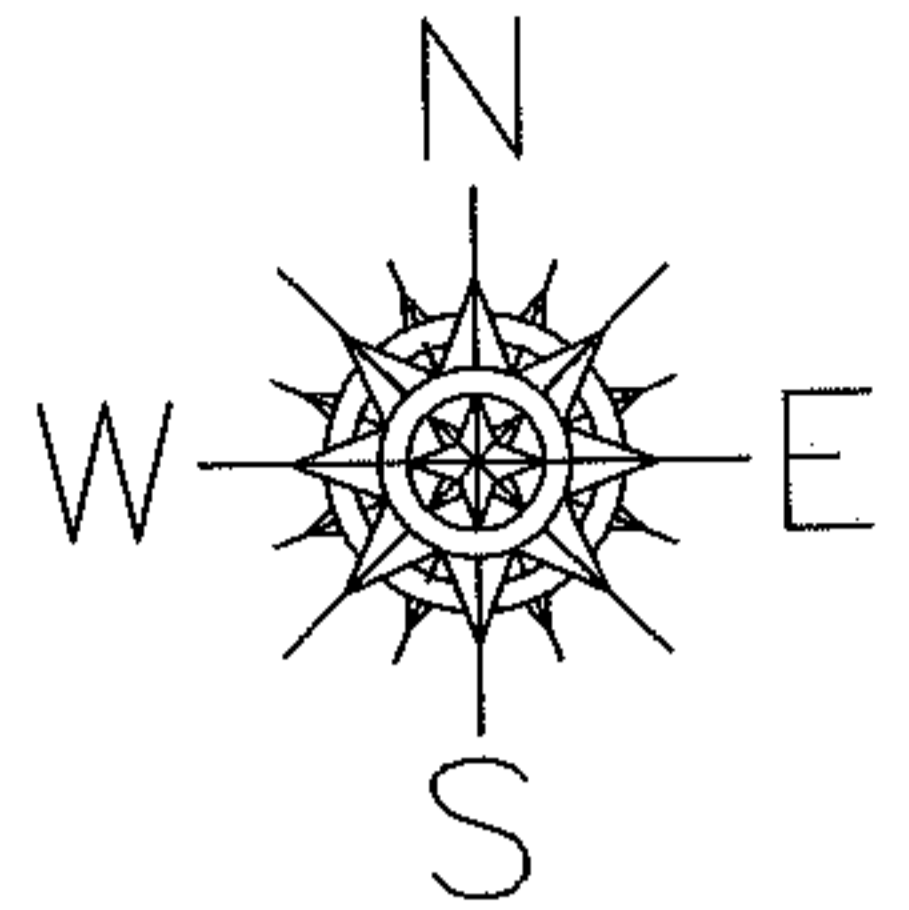


DEPTH CORRECTION

02-01-006-152-026

160.42

50 X ~~152~~

PER DEED AND ORD. NO.5287

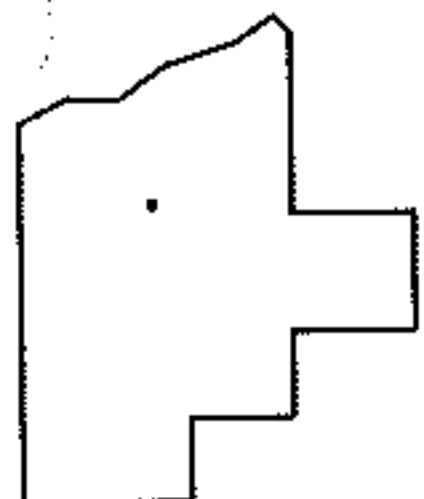

SPLITS/DEEDS PROCESSED

LORAIN COUNTY TAX MAP DEPARTMENT
226 MIDDLE AVE. ELYRIA, OHIO

SURVEYED BY: N/A

CLOSURE: N/A

MAP PAGE(S): 2-01-006-E

APPROVED BY: RRM DATE: 1-3-11

SCALE: 1"= 50' PRIOR INST.: 20080241528