



RASTER

PARENT PARCEL: 04-00-020-104-565

CHILD PARCEL: 04-00-020-104-636 THRU -642

STARTING POINT: CENTERLINE OF TEASEL CT & LEAR RD

06-02159

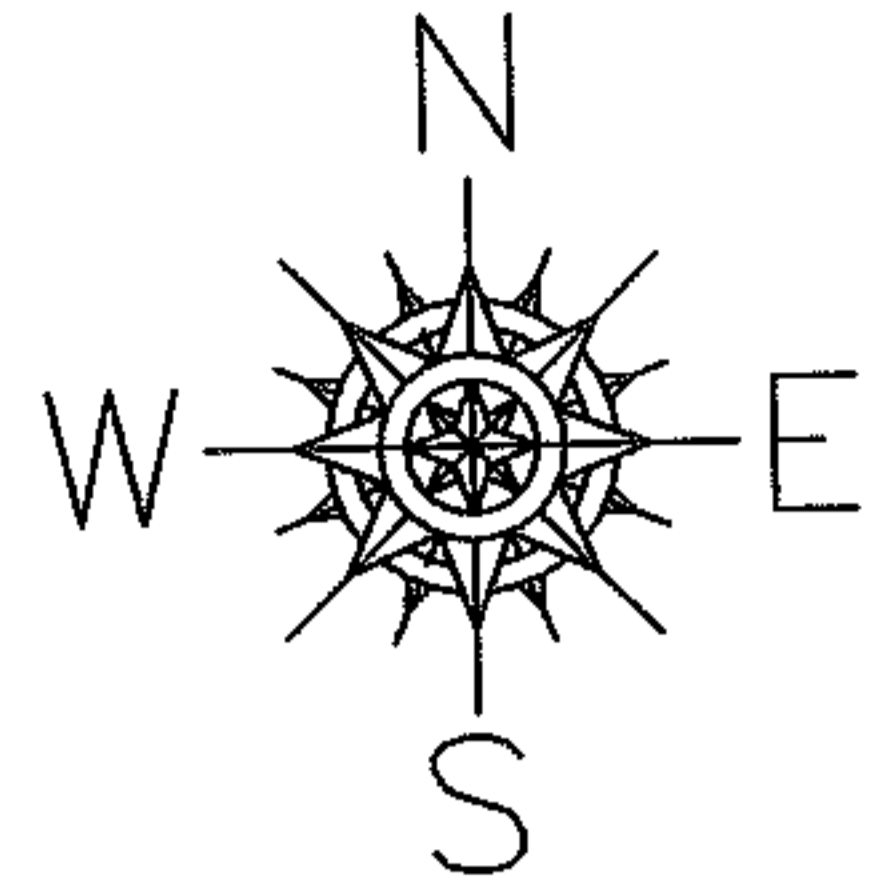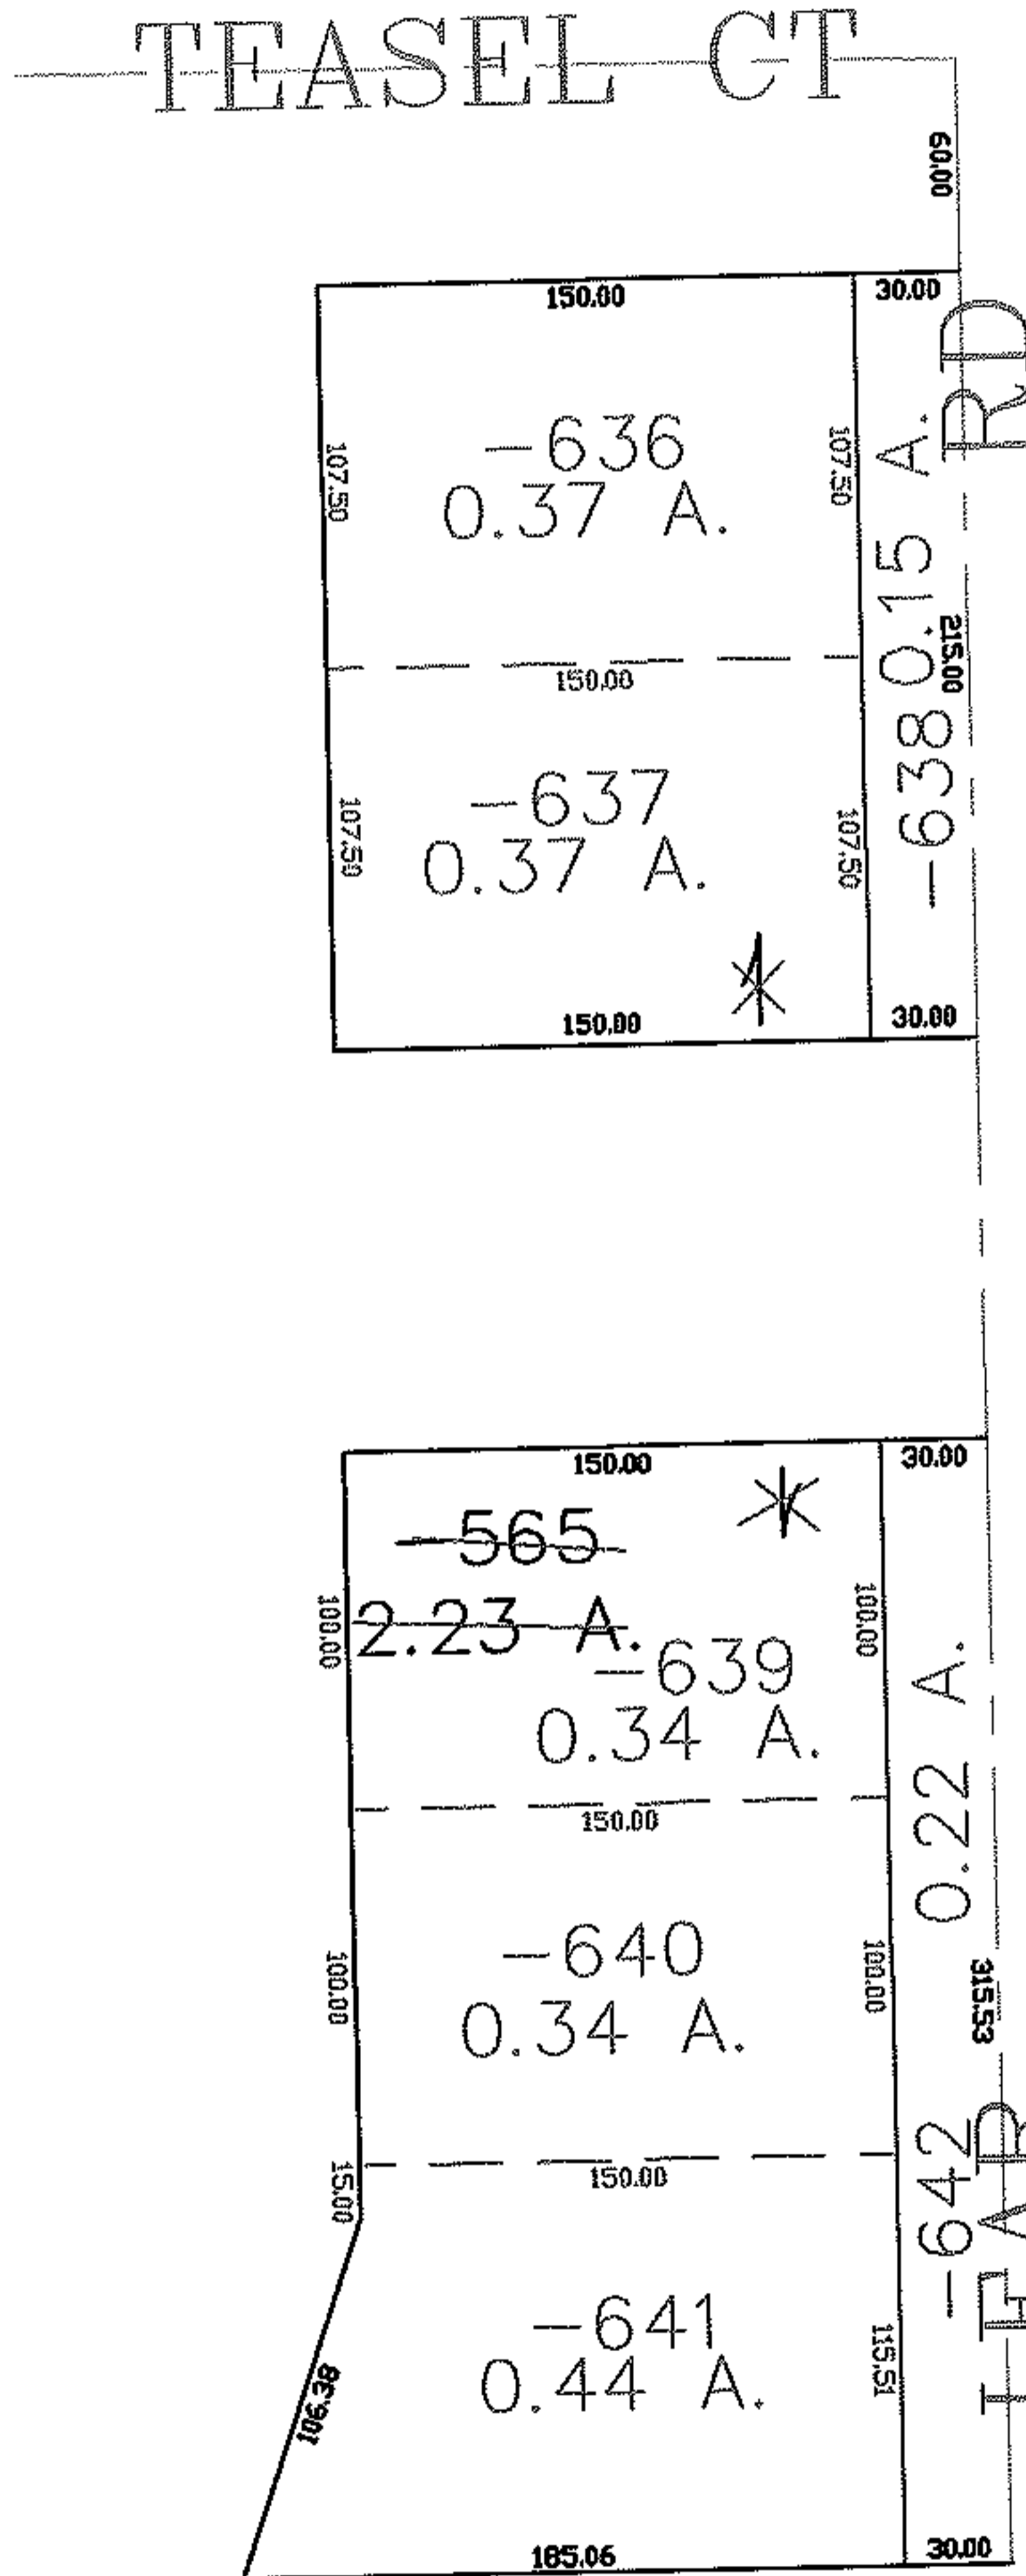

SPLITS/DEEDS PROCESSED

LORAIN COUNTY TAX MAP DEPARTMENT
226 MIDDLE AVE. ELYRIA, OHIO

SURVEYED BY: JAMES T SAYLER

CLOSURE: 0.00 : 10.000

MAP PAGE(S): 04-00-020-H

APPROVED BY: JAH DATE: 5-23-06

SCALE: 1" = 100 PRIOR INSTRUMENT: OR 854/523