
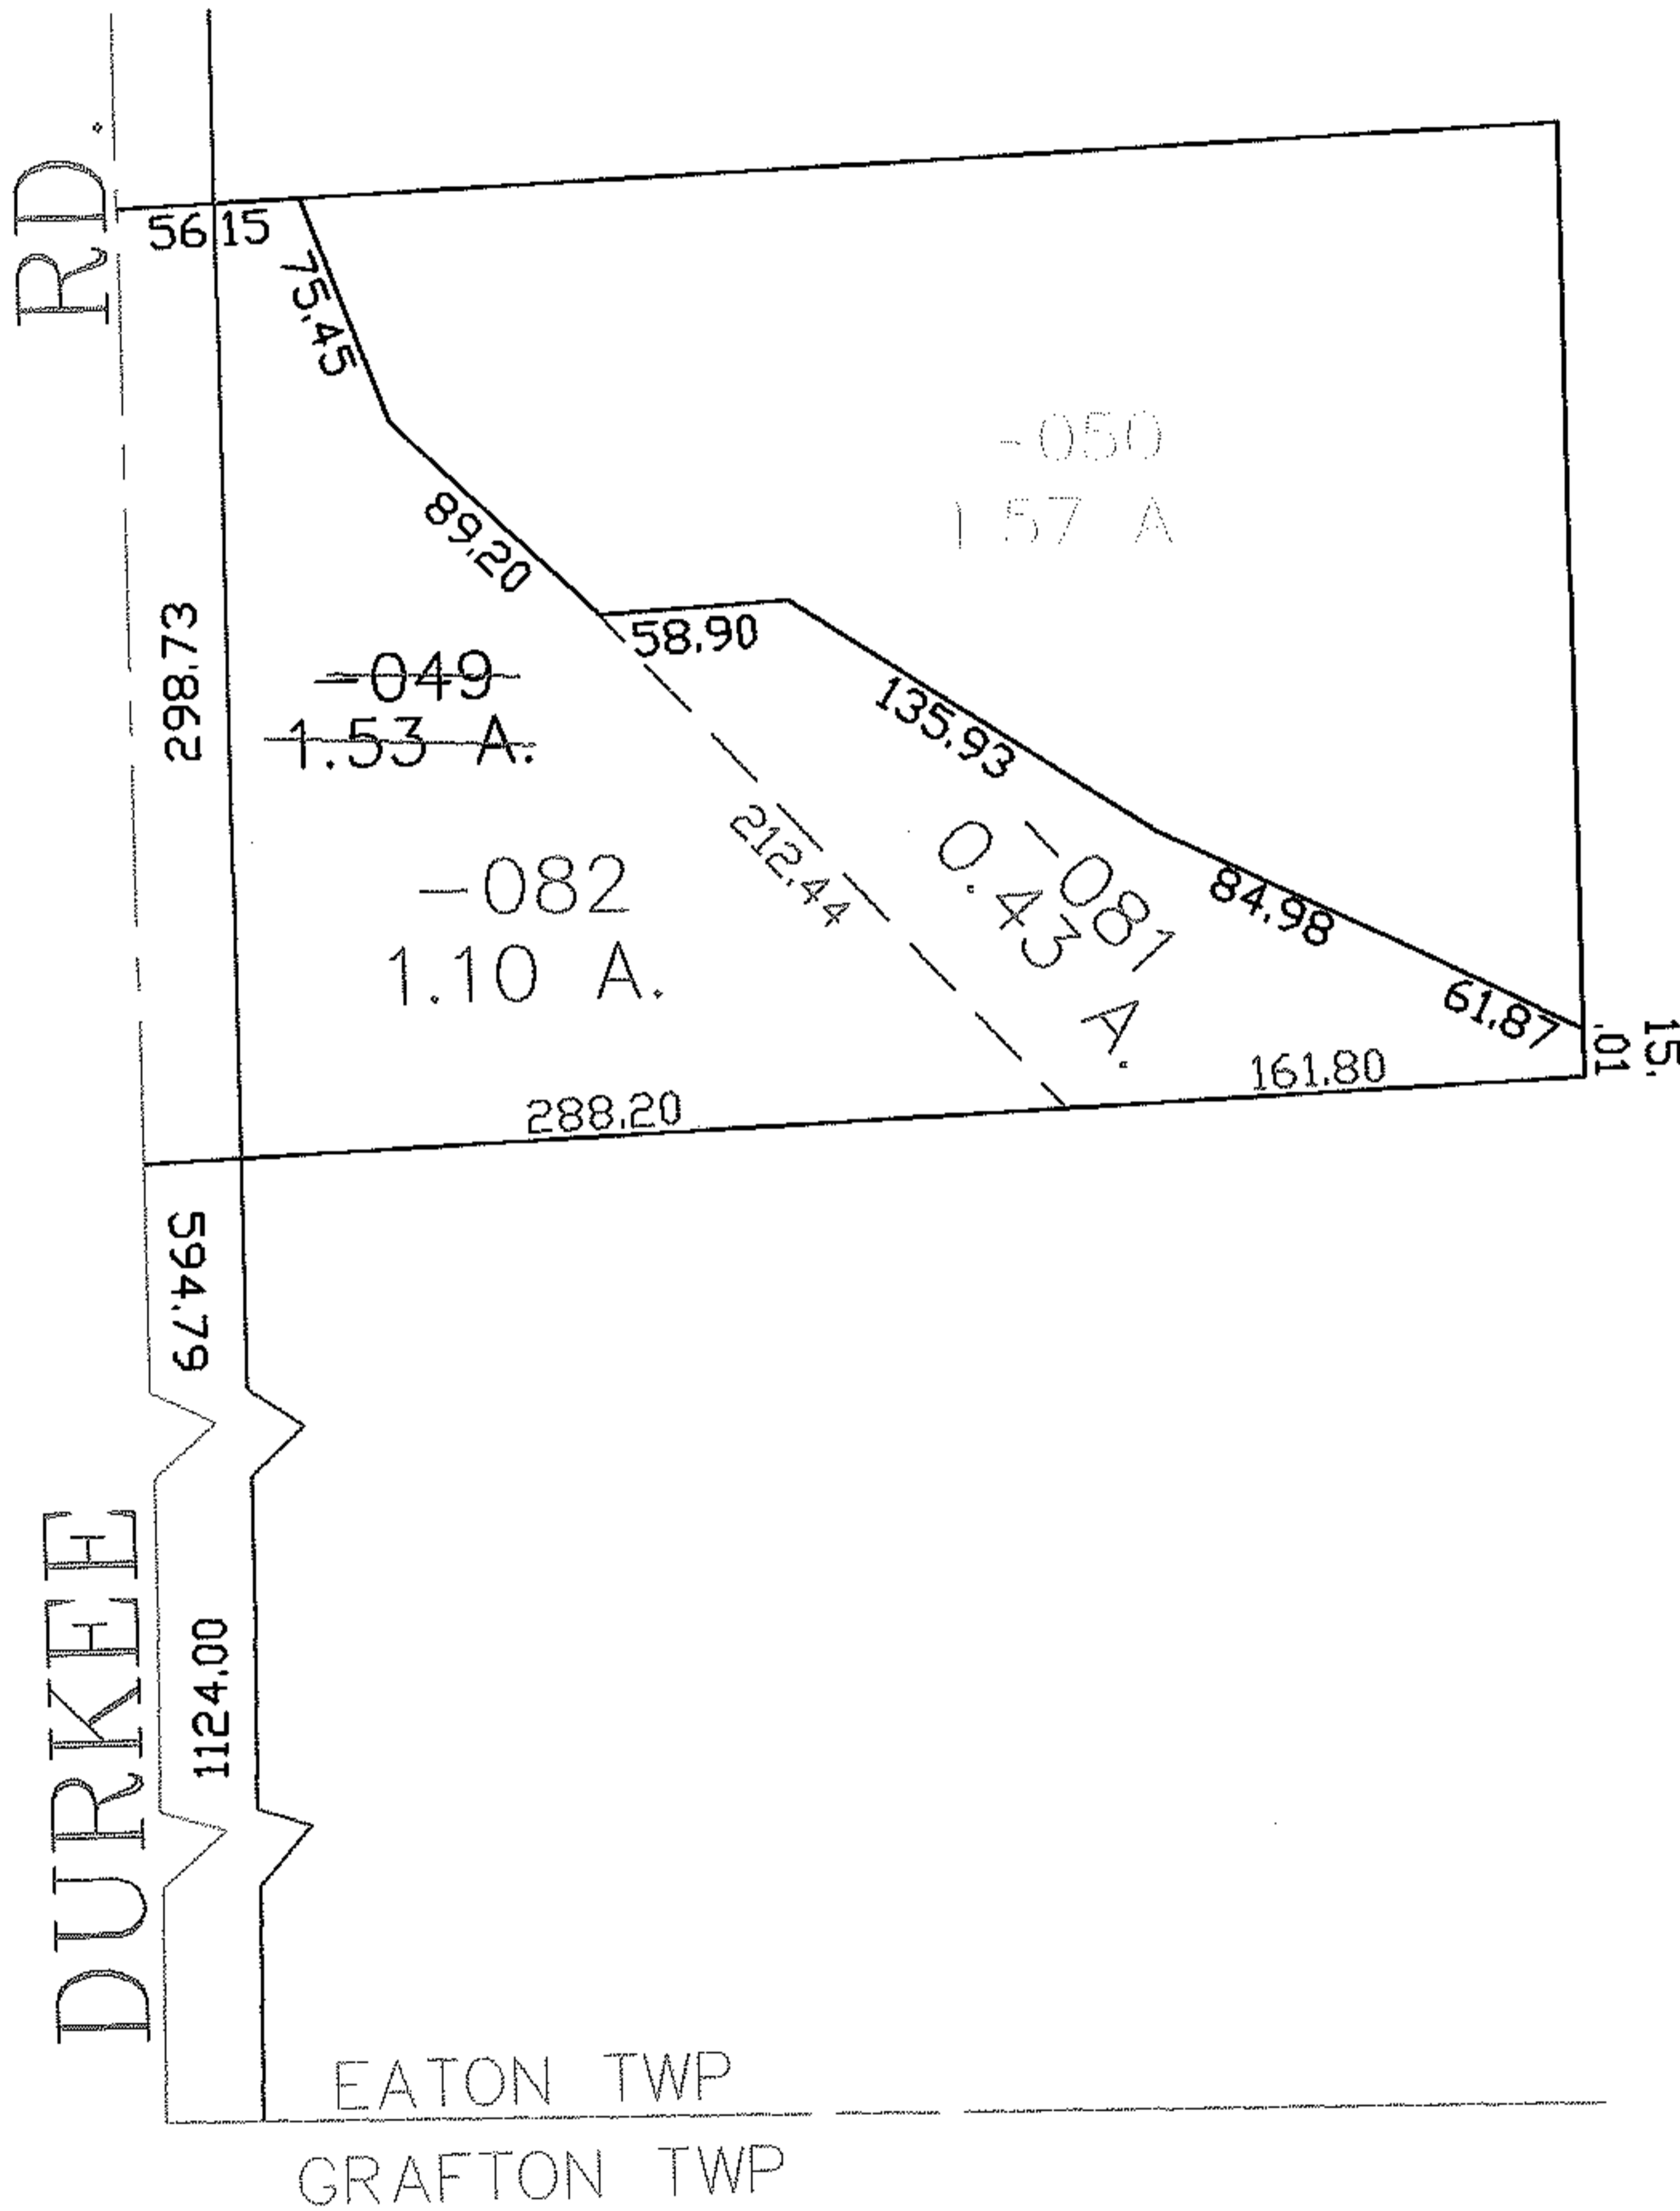


PARENT PARCEL: 11-00-080-000-049

CHILD PARCEL: 11-00-080-000-081, -082

STARTING POINT: CENTERLINE OF DURKEE RD & EATON TWP LINE

06-02160

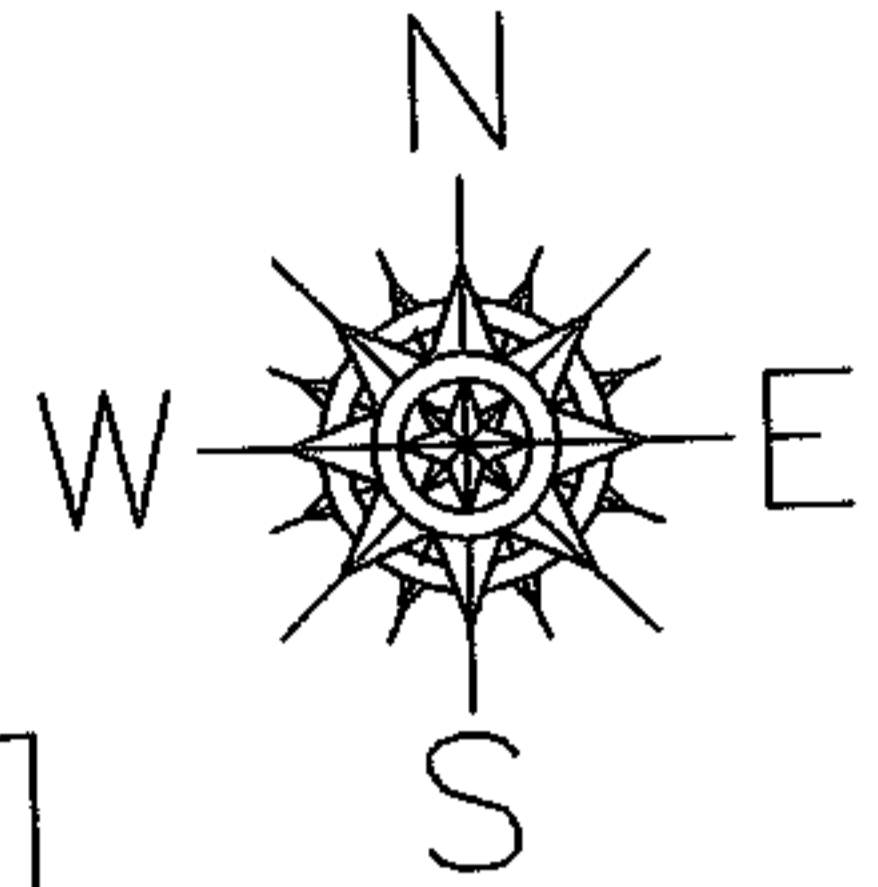

SPLITS/DEEDS PROCESSED

LORAIN COUNTY TAX MAP DEPARTMENT
226 MIDDLE AVE. ELYRIA, OHIO

SURVEYED BY: CHARLES P. UNTERREINER
 CLOSURE: 0.00 : 10.000
 MAP PAGE(S): 11-00-080-A
 APPROVED BY: JAH DATE: 5-24-06
 SCALE: 1" = 100 PRIOR INSTRUMENT: 20050078328