



RASTER

PARENT PARCEL: 09-00-058-000-018

CHILD PARCEL: 09-00-058-000-033, -034

STARTING POINT: CENTERLINE OF OBERLIN RD & BUTTERNUT RIDGE RD

06-02163

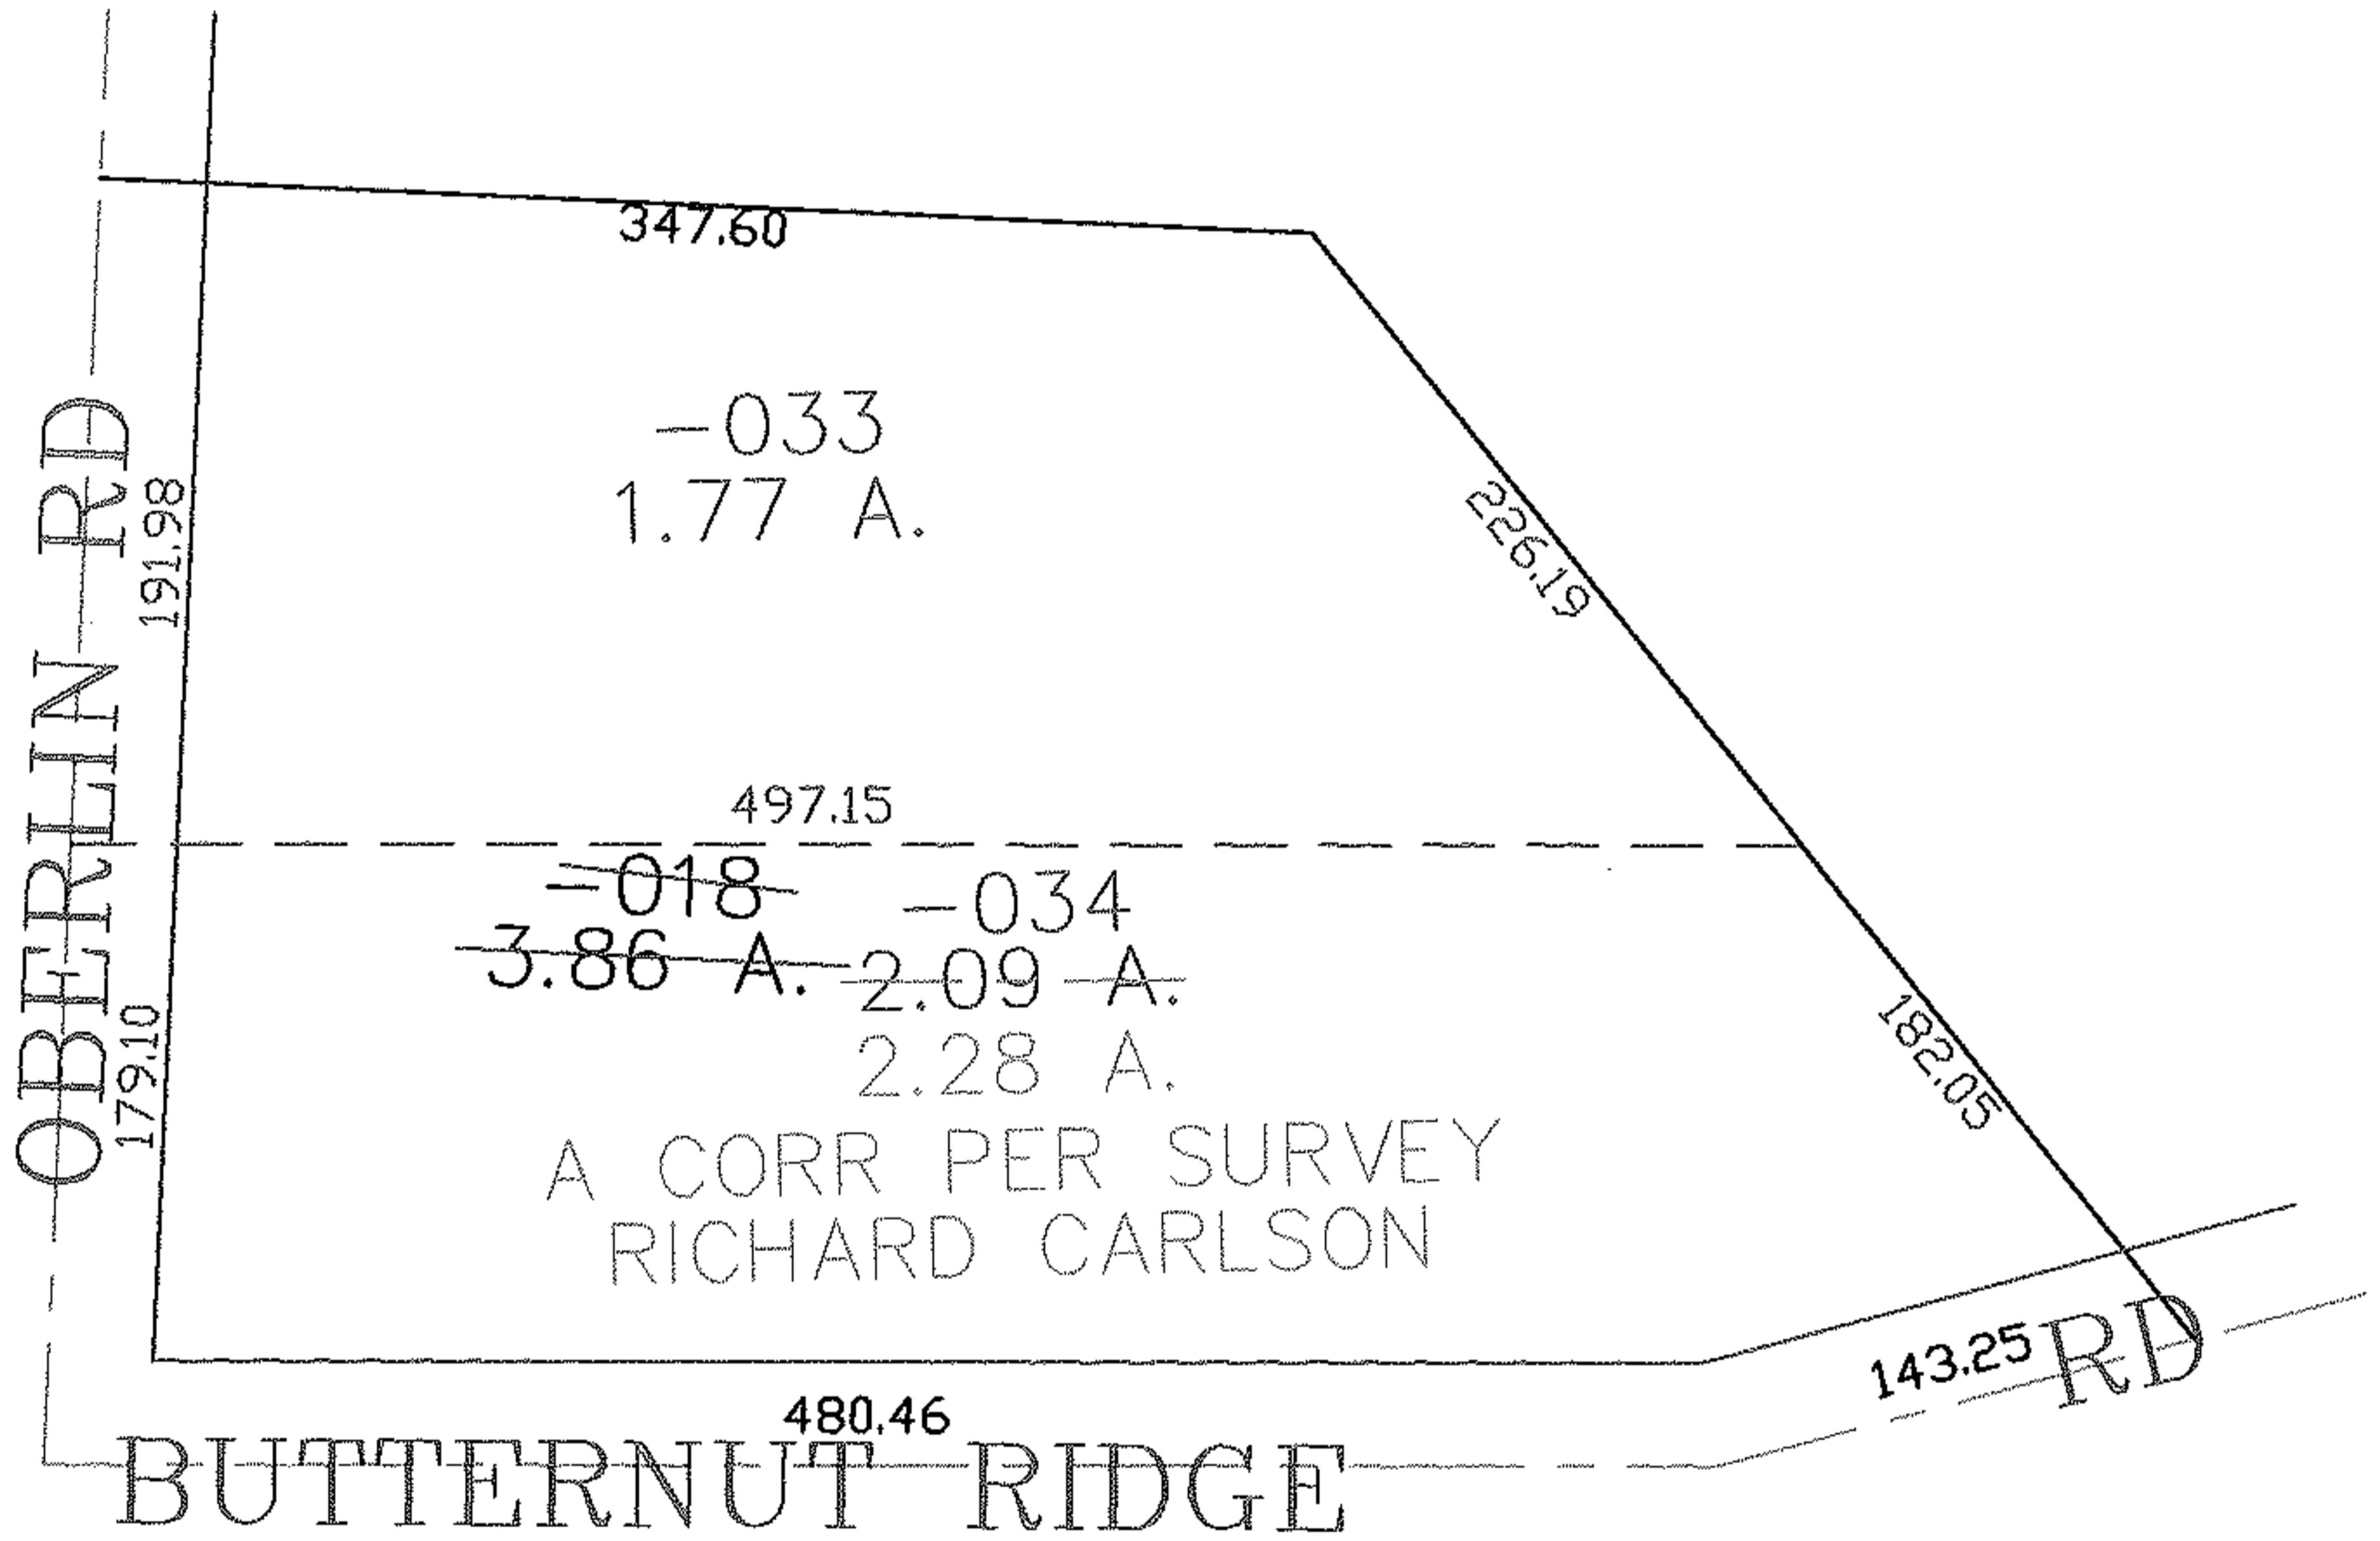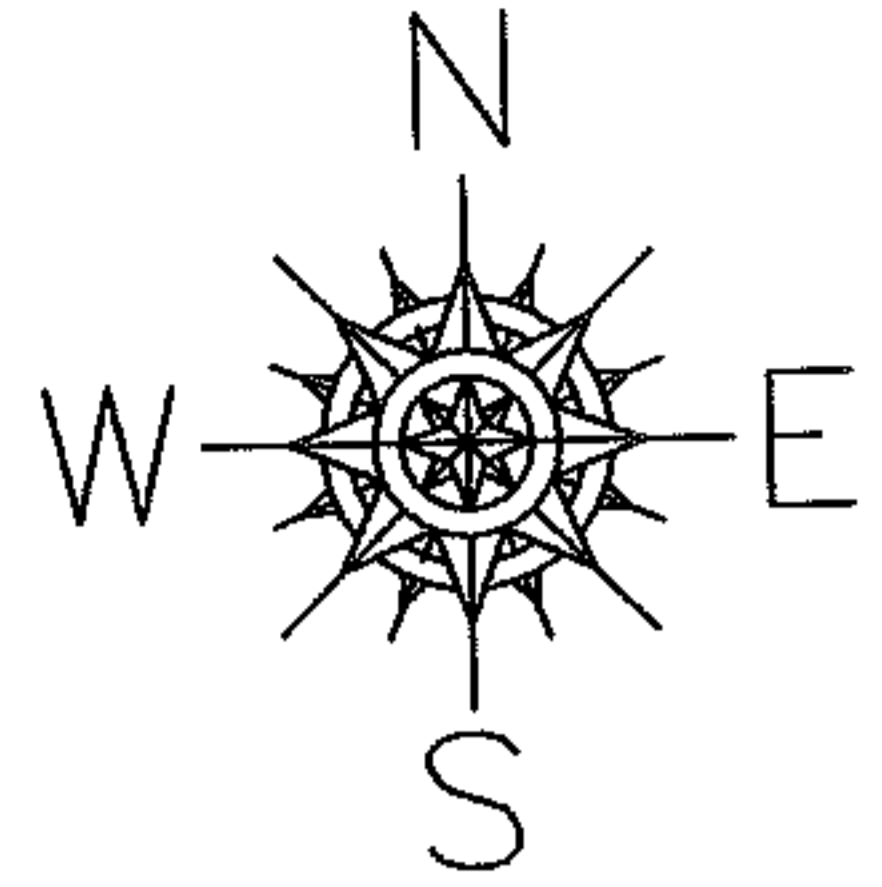

SPLITS/DEEDS PROCESSED

LORAIN COUNTY TAX MAP DEPARTMENT  
226 MIDDLE AVE. ELYRIA, OHIO

SURVEYED BY: RICHARD CARLSON

CLOSURE: 0.00 : 10.000

MAP PAGE(S): 9-H

APPROVED BY: JAH DATE: 6-7-06

SCALE: 1" = 100 PRIOR INSTRUMENT: 2000068151