
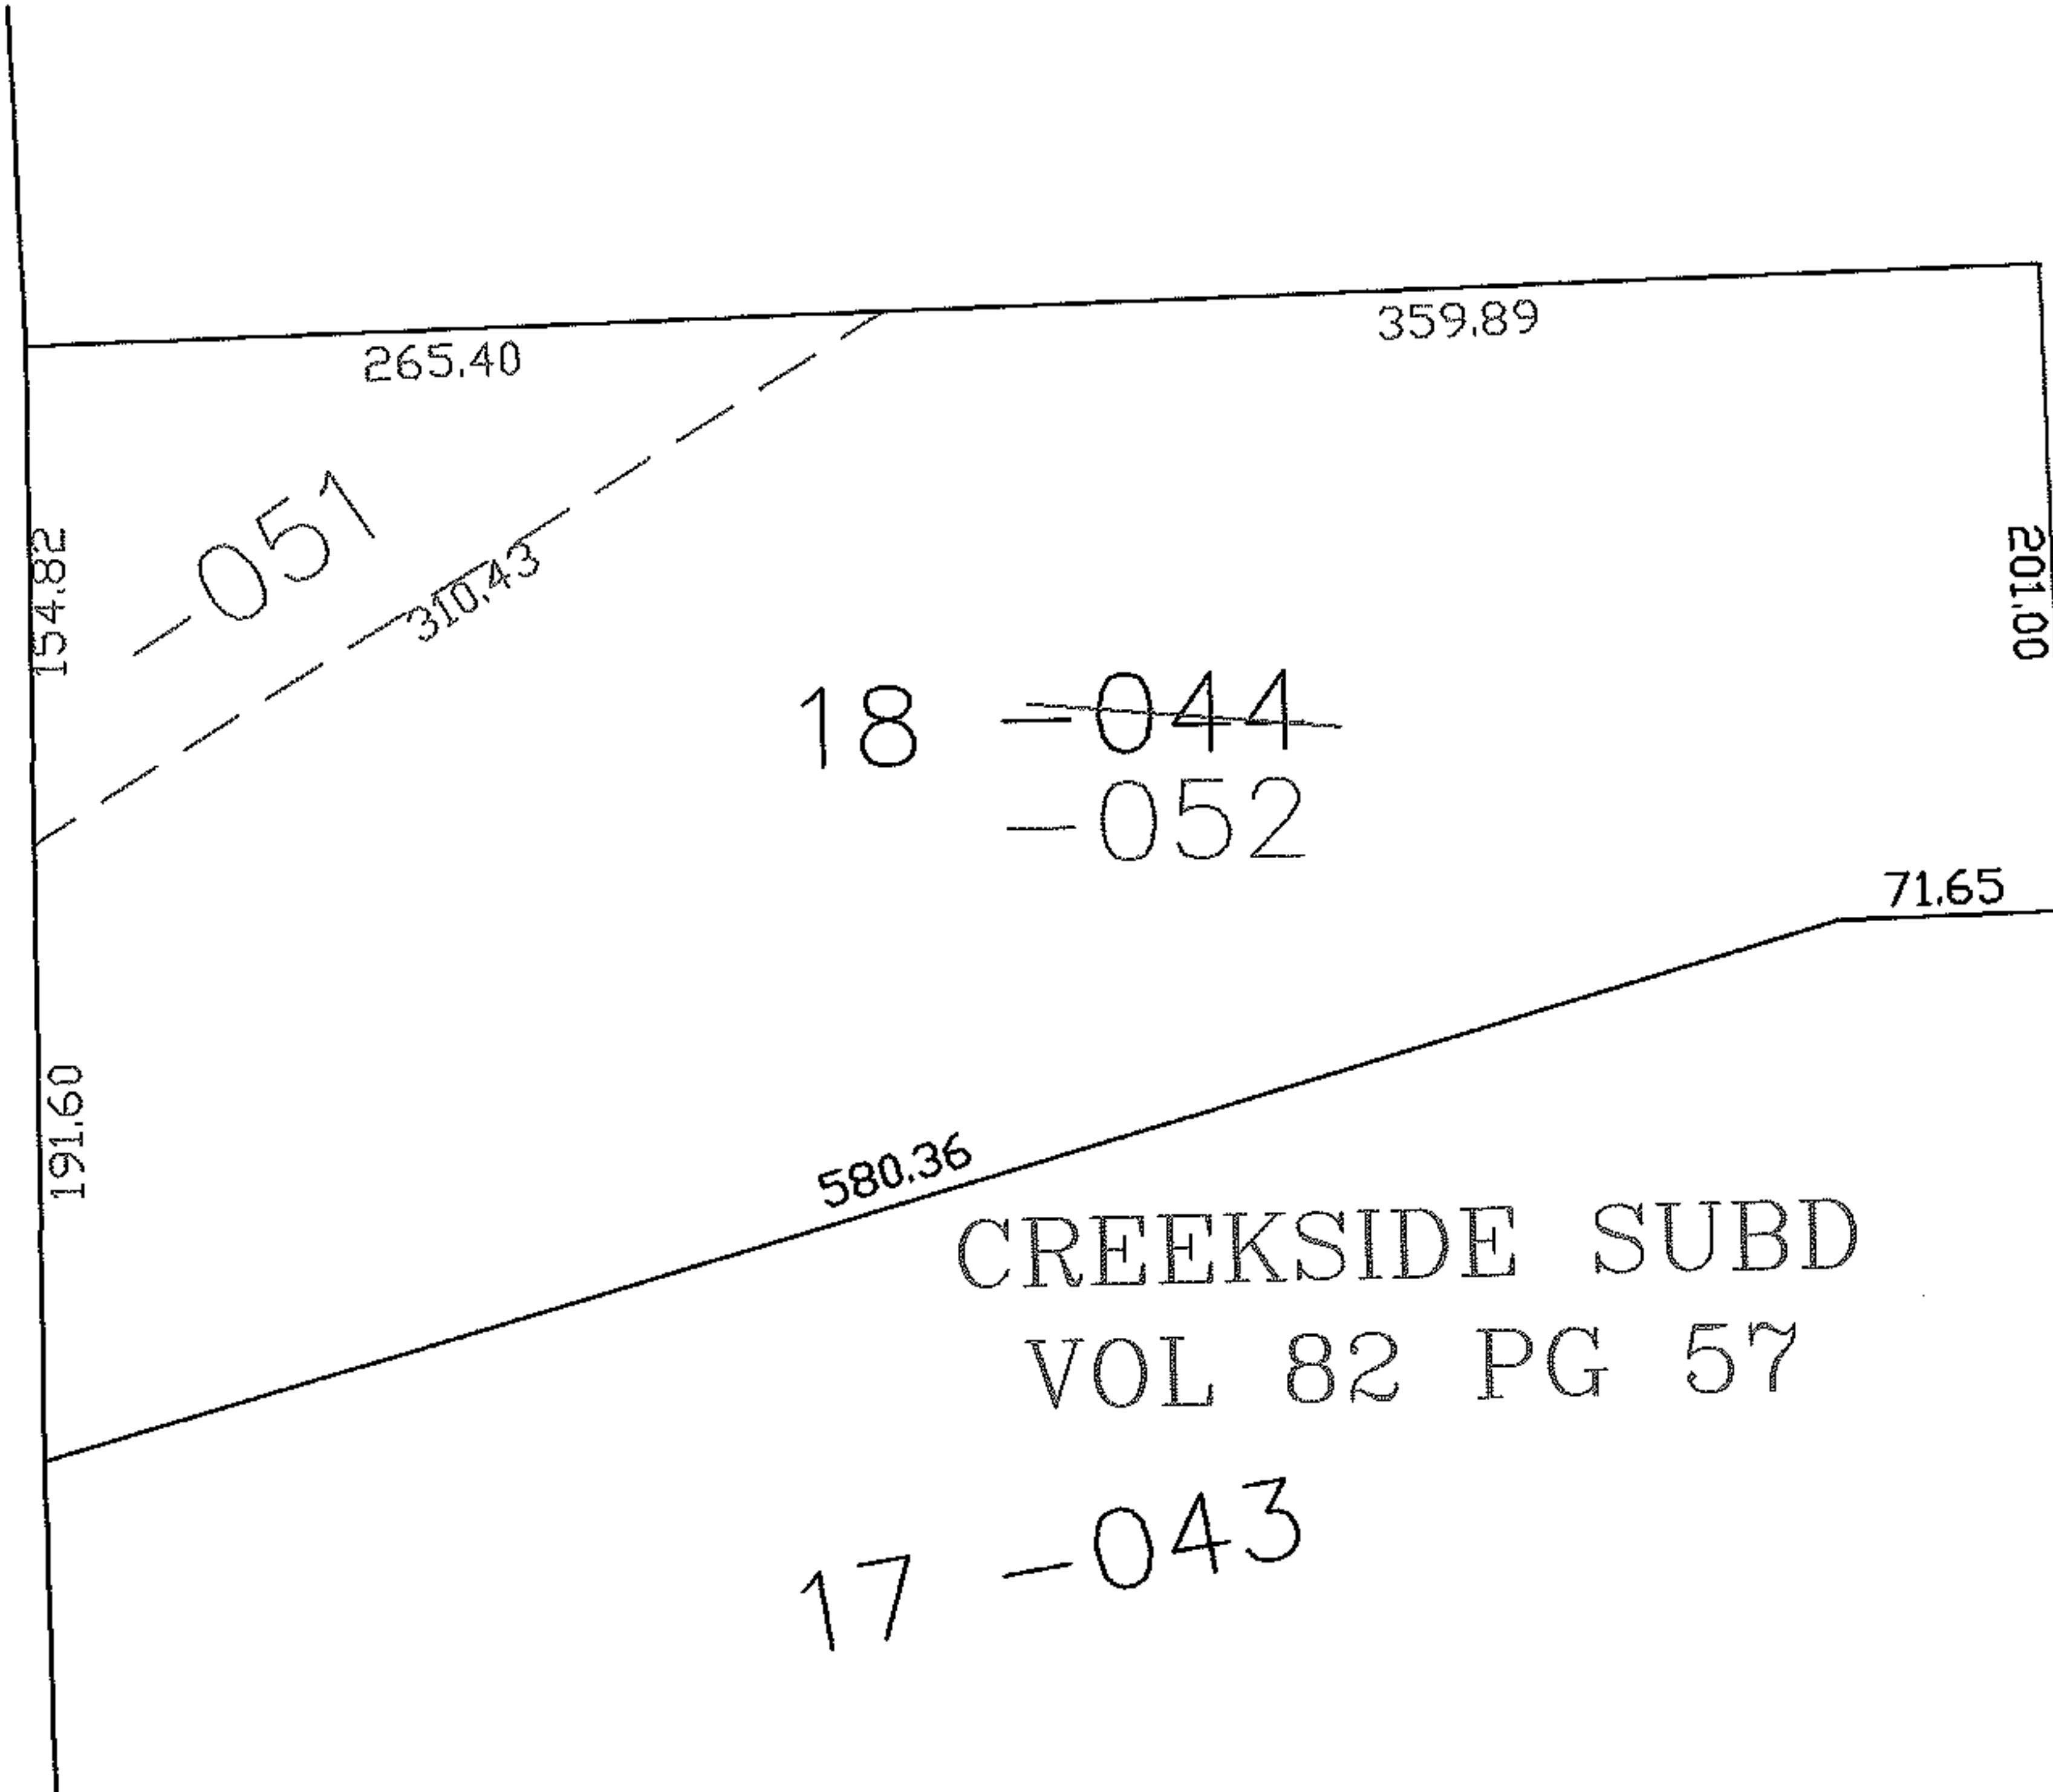


PARENT PARCEL: 15-00-058-000-044

CHILD PARCEL: 15-00-058-000-051, -052

STARTING POINT: CORNER OF S/L 18 & CREEKSIDE ST

06-02164

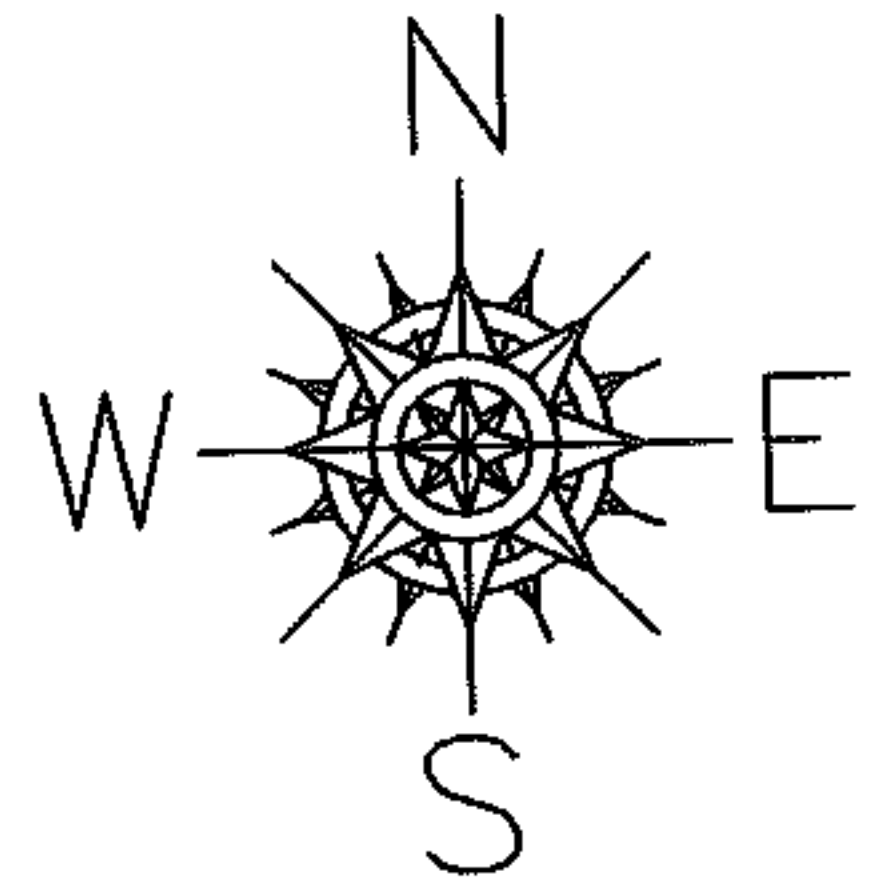

SPLITS/DEEDS PROCESSED

LORAIN COUNTY TAX MAP DEPARTMENT
226 MIDDLE AVE. ELYRIA, OHIO

SURVEYED BY: DALE HAYWOOD

CLOSURE: 0.00 : 10.000

MAP PAGE(S): 15-00-058-A

APPROVED BY: JAH DATE: 6-8-06

SCALE: 1" = 100' PRIOR INSTRUMENT: PL VL 82/57