


PARENT PARCEL: 07-00-039-000-028

10-02165-A



CHILD PARCEL:

STARTING POINT: INTERSECTION OF SOUTH LINE OF CENTER RIDGE RD. AND WEST LINE OF LAND CONVEYED TO GEORGE KLINE ETAL(DV 967/606)

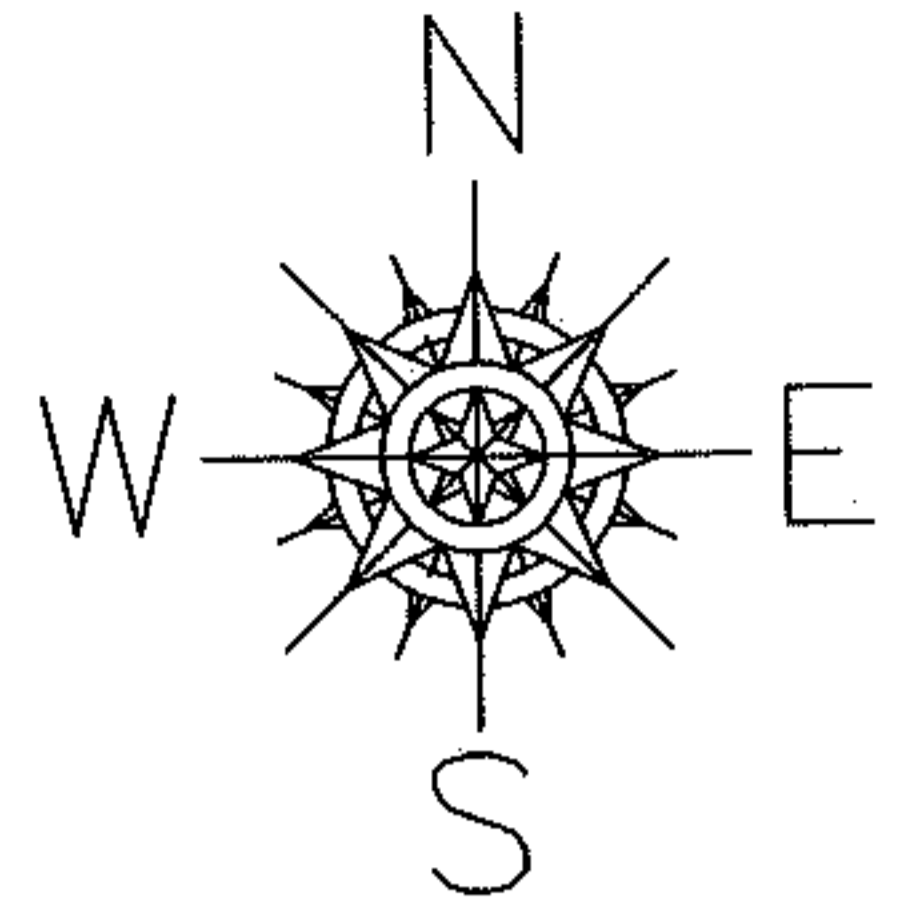

ACERAGE CORRECTION
PER TAX MAP MISTAKE

CENTER RIDGE RD. (S.R.20)

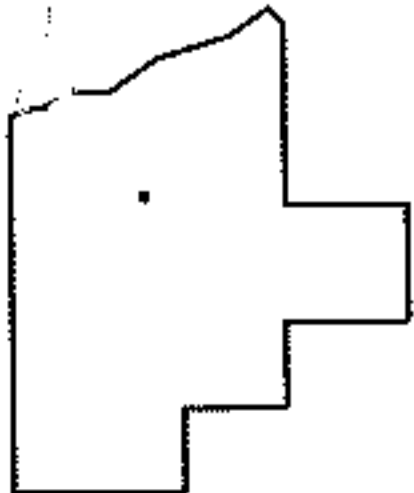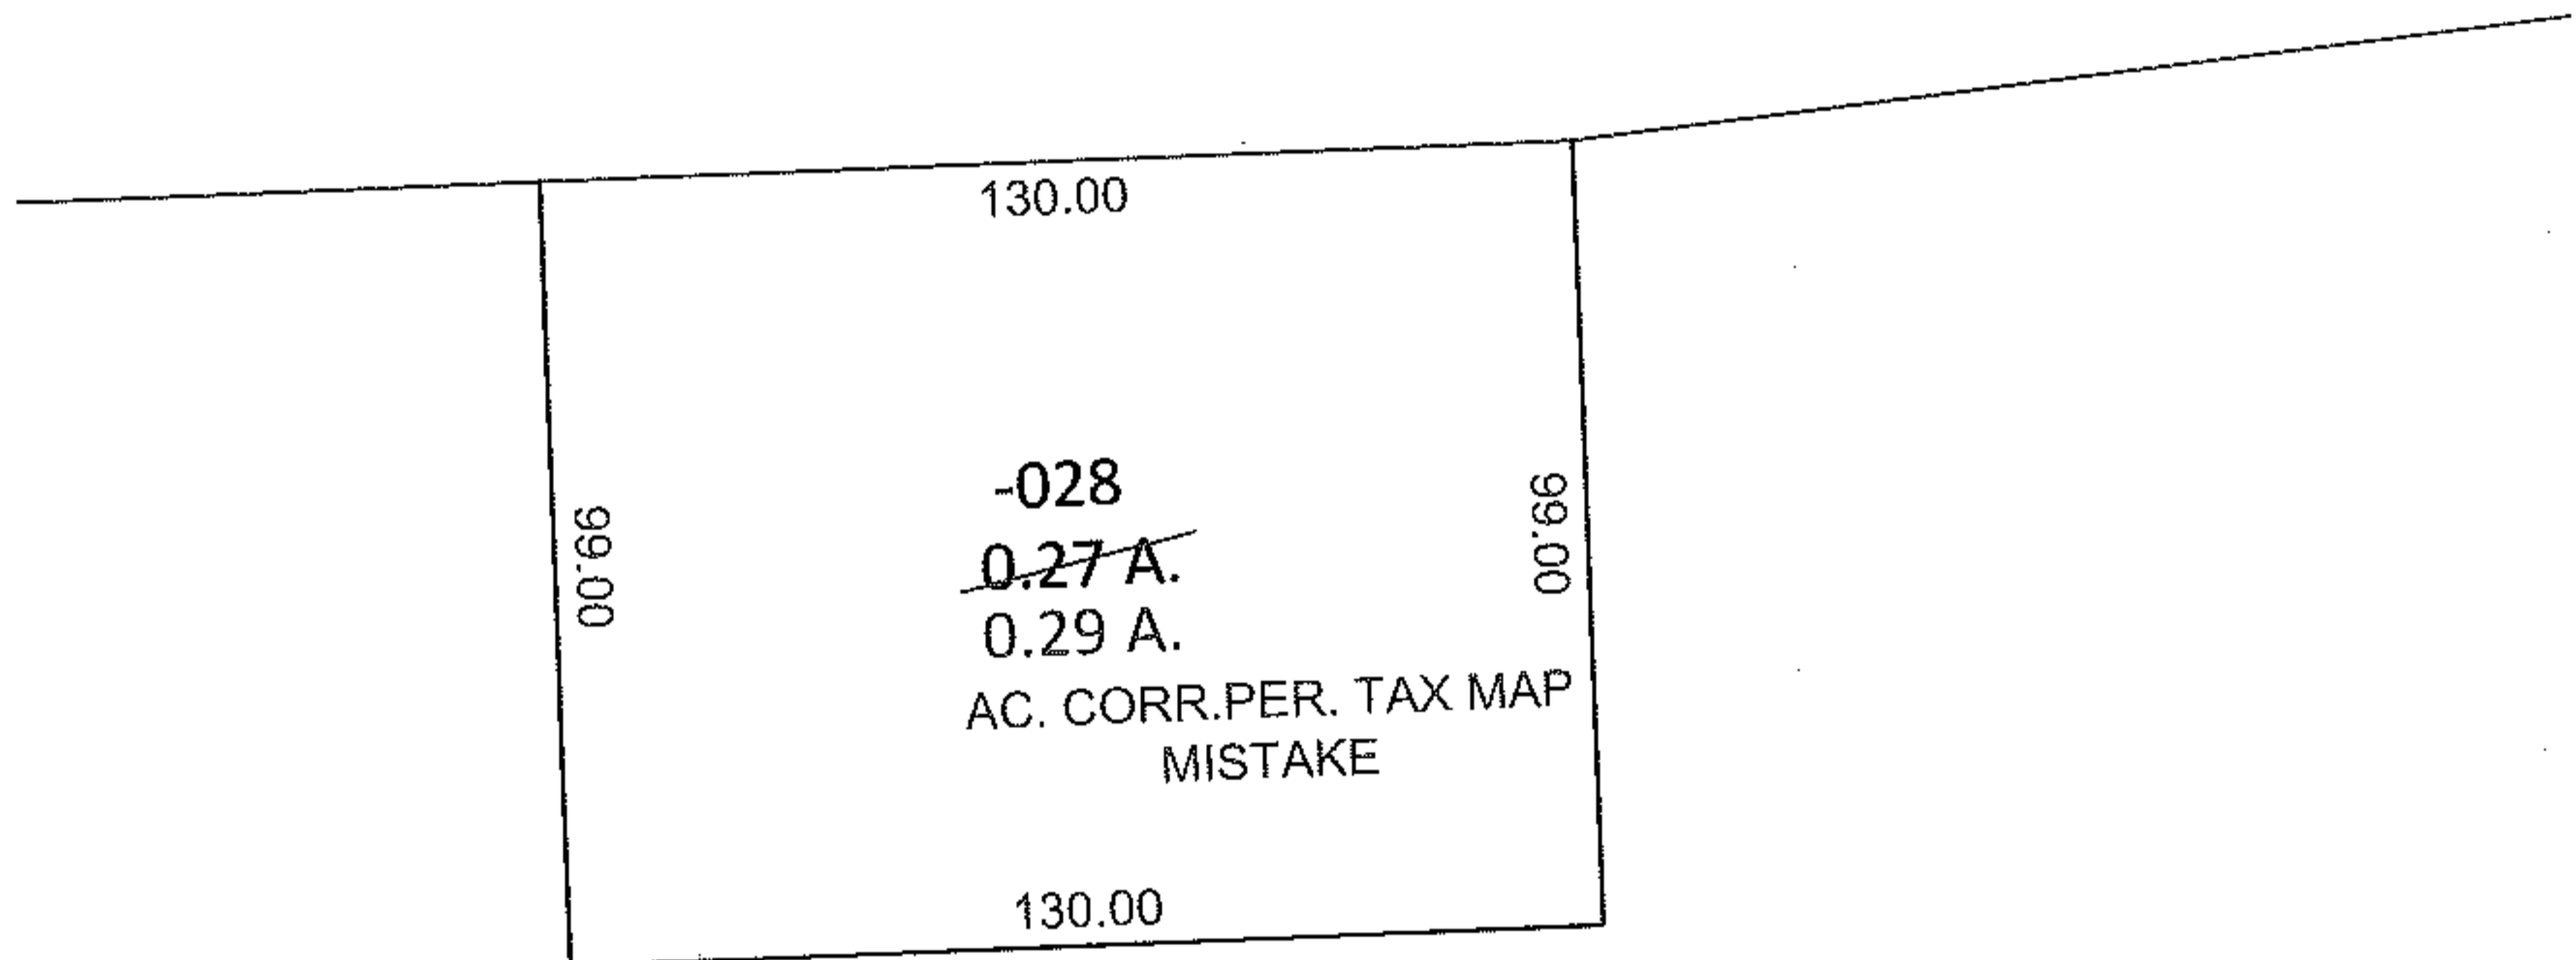

SPLITS/DEEDS PROCESSED

LORAIN COUNTY TAX MAP DEPARTMENT
226 MIDDLE AVE. ELYRIA, OHIO

SURVEYED BY: N/A

CLOSURE: N/A

MAP PAGE(S): 7-00-039-B

APPROVED BY: RRM DATE: 12-20-10

SCALE: 1"= 50' PRIOR INST.: DV 973/307