
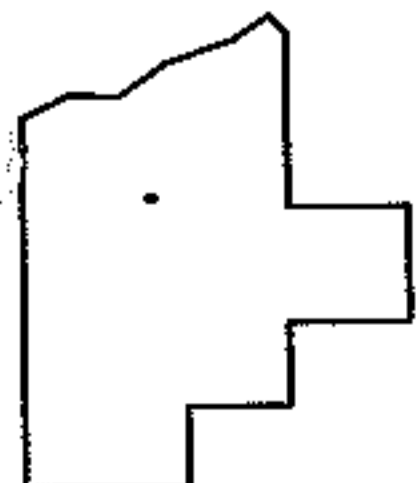
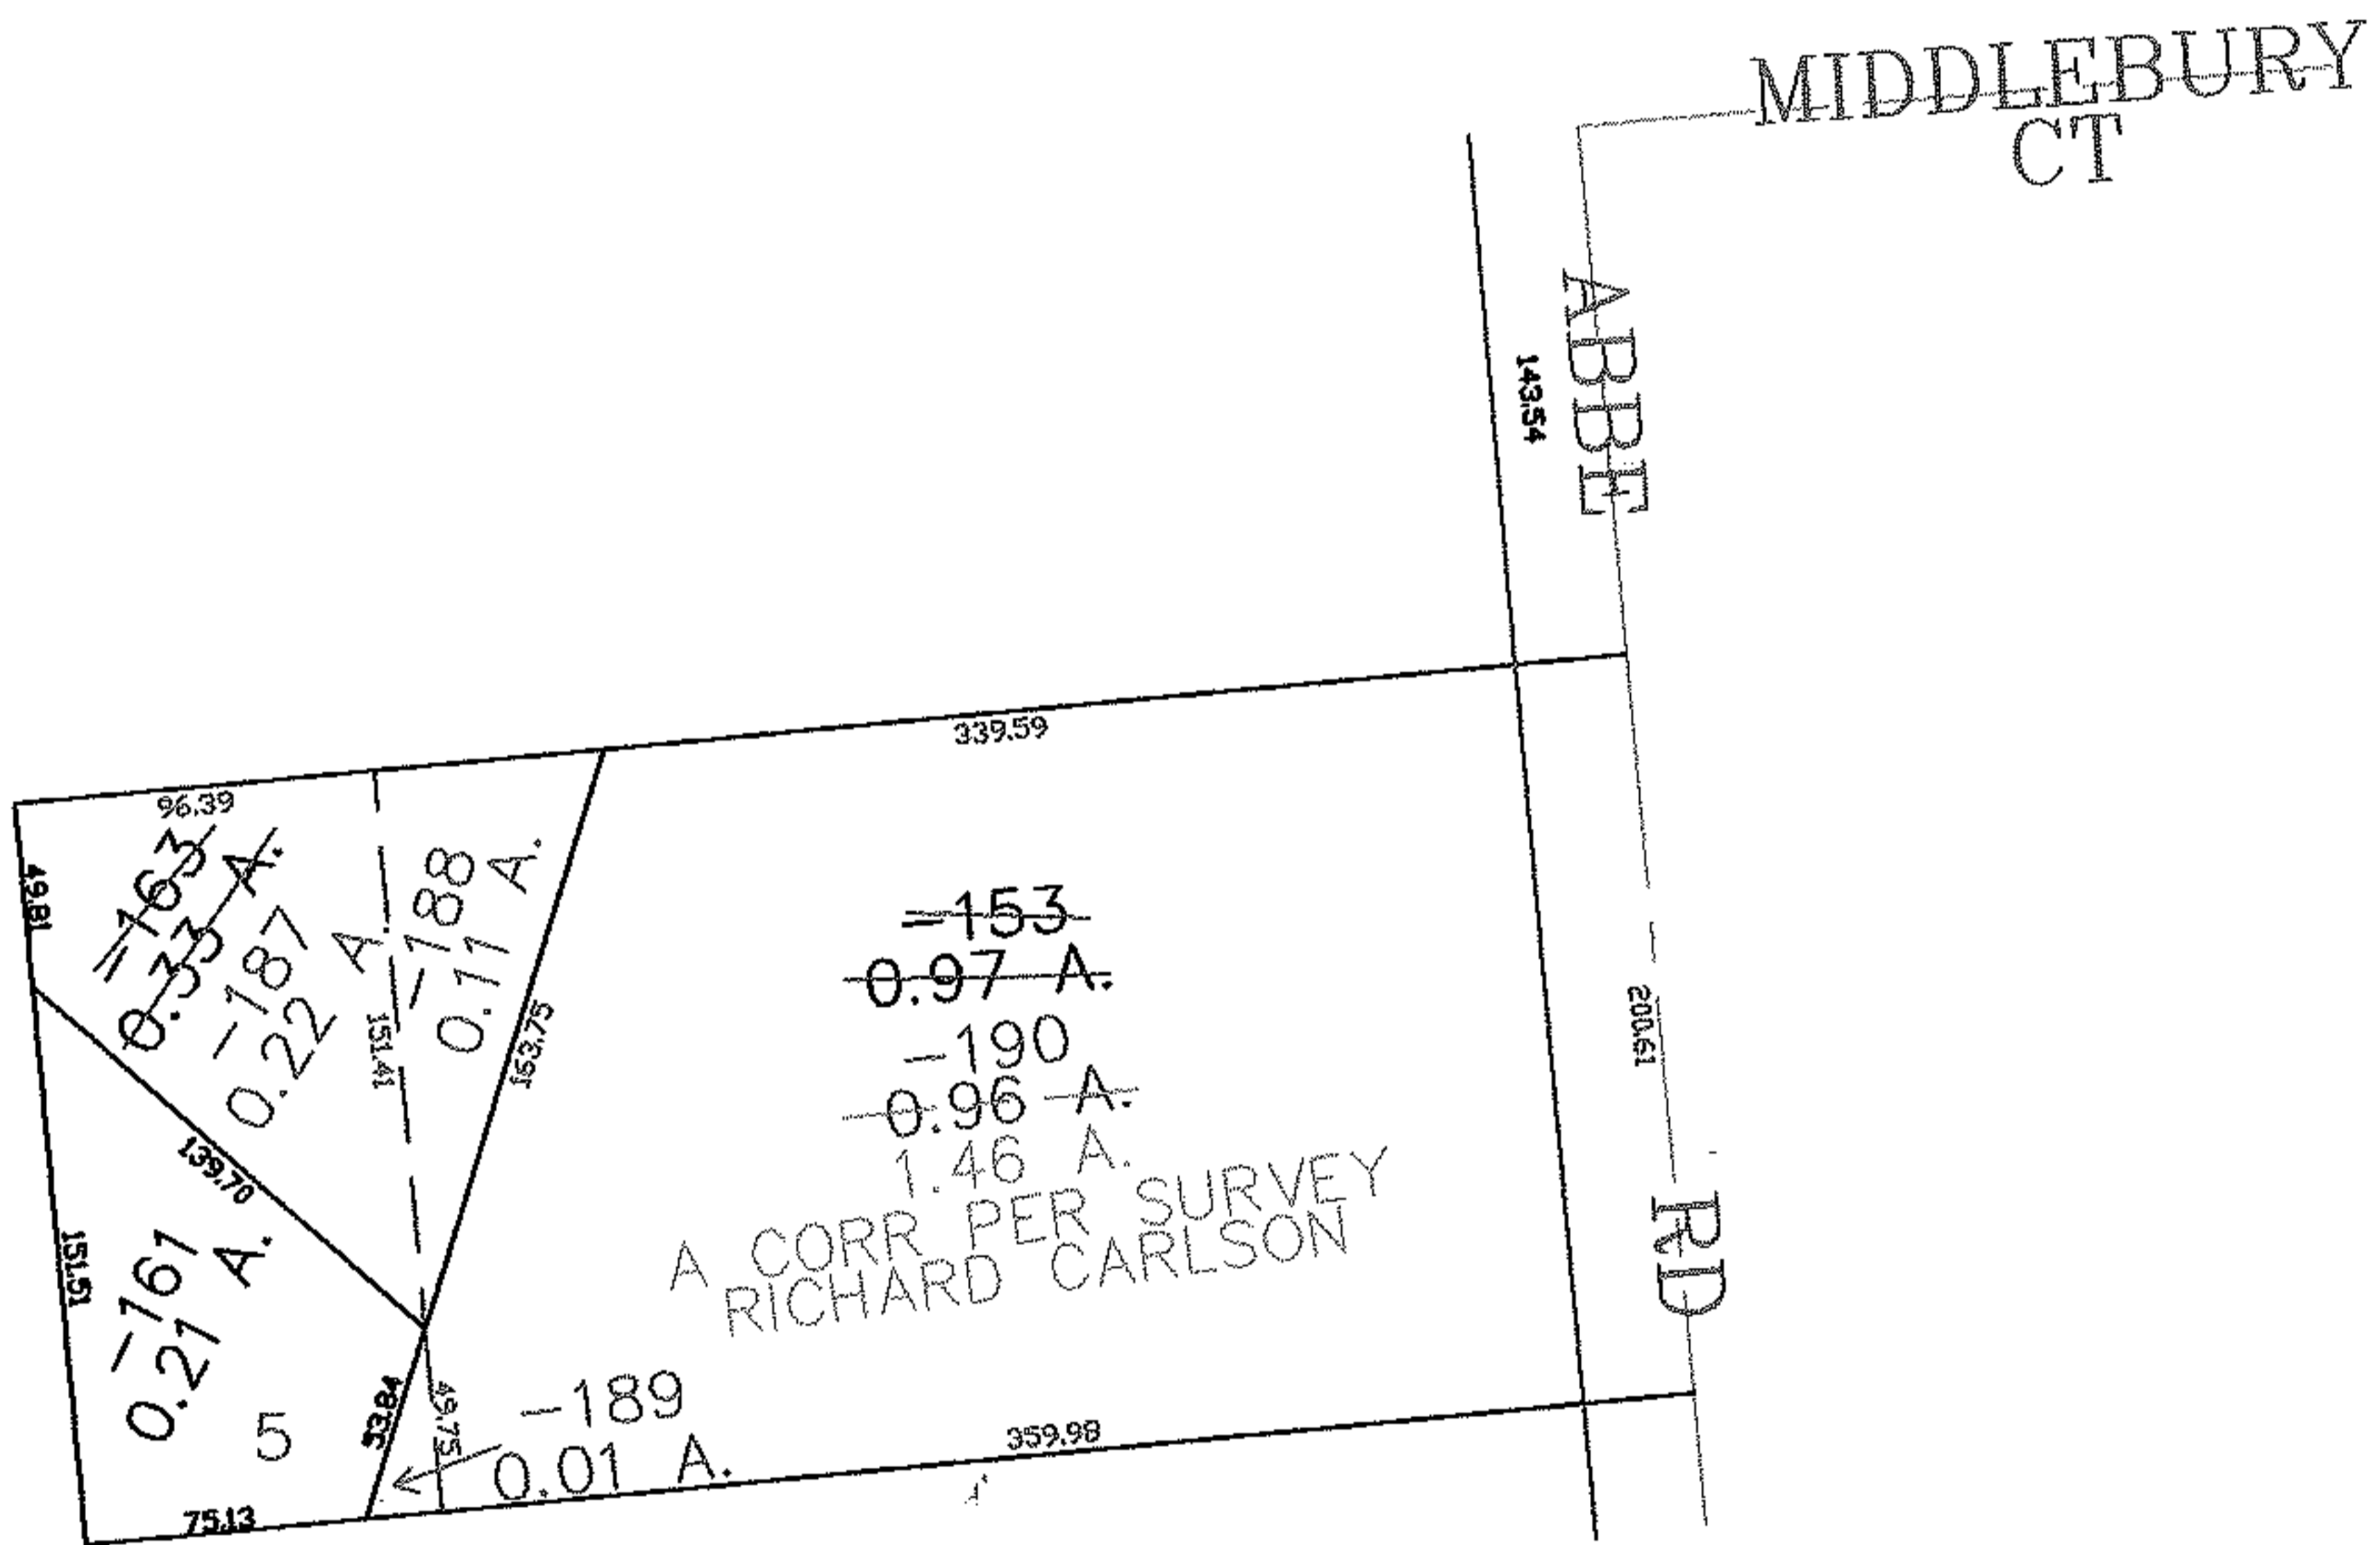


RASTER

PARENT PARCEL: 03-00-012-000-163, 153, -161
CHILD PARCEL: 03-00-012-000-187 THRU -190
STARTING POINT: CENTERLINE OF MIDDLEBURY CT & ABBE RD

06-02166

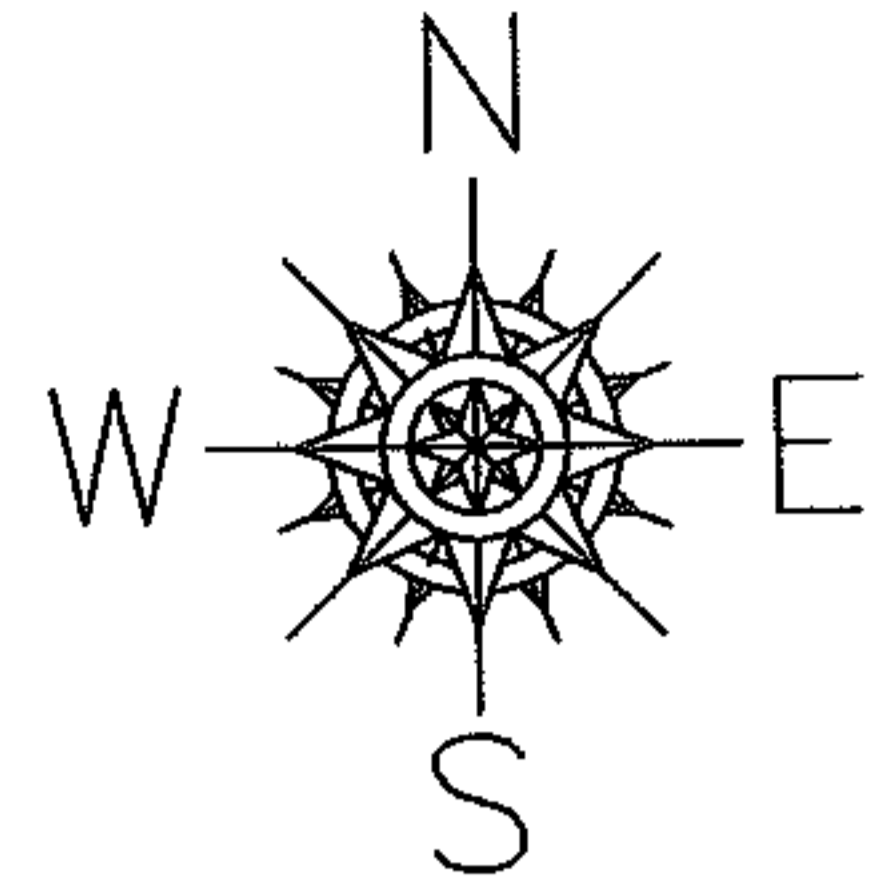

SPLITS/DEEDS PROCESSED
LORAIN COUNTY TAX MAP DEPARTMENT
226 MIDDLE AVE. ELYRIA, OHIO

SURVEYED BY: RICHARD CARLSON
CLOSURE: 0.00 : 10.000
MAP PAGE(S): 03-00-012-B
APPROVED BY: JAH DATE: 6-13-06
SCALE: 1" = 100 PRIOR INSTRUMENT: PL VL 53/25