


RASTER 12/21/10

PARENT PARCEL: 17-08-031-000-004, -005, -015

CHILD PARCEL: XX-XX-XXX-XXX-XXX

STARTING POINT: I.P. , CL OF ASHLAND-KIPTON RD. & CL OF PECK-WADSWORTH RD.

10-02167-C

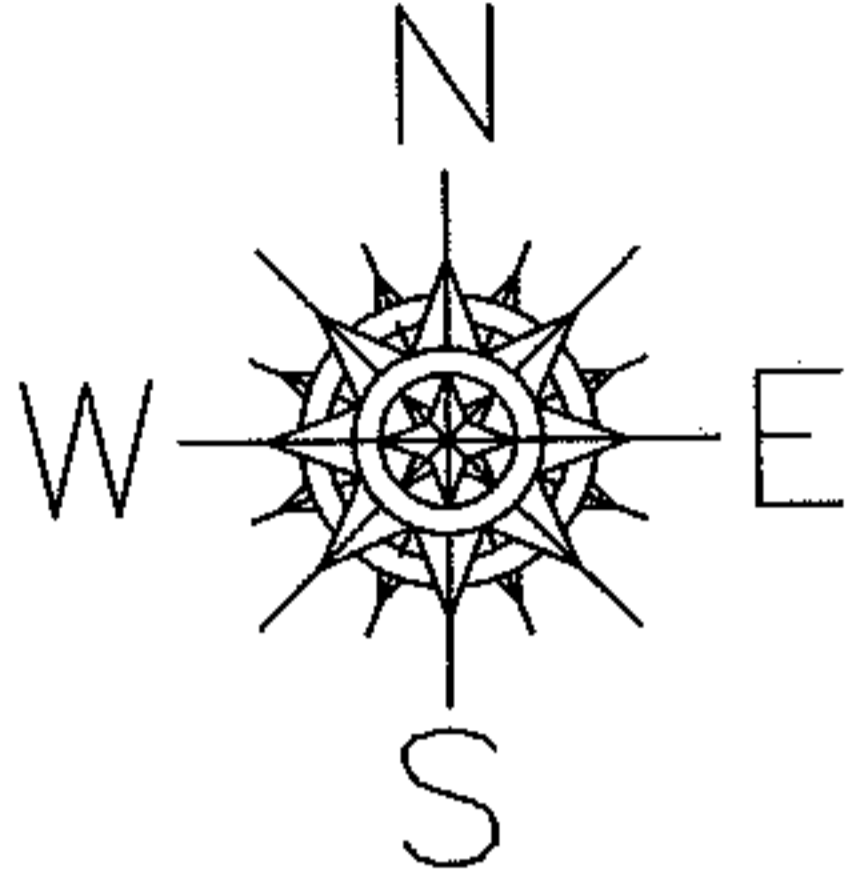

MAP CORRECTION

SUVEY BEFORE NEXT TRANSFER

17-08-031-000-015

BAD LEGAL DESCRIPTION

DOESN'T PROPERLY DESCRIBE PARCEL

ASHLAND - KIPTON RD. 60'

TRACT 8 O.L. 31

570.58
570.53

-005
7.00 A.

570.58

-004
7.00 A.


570.58

410.00
-007 1.50 A.
410.00

160.58
160.58

-015
57.02 A.

400.00

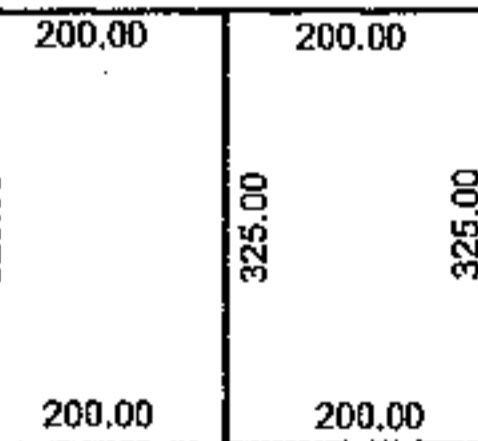

MAP CORRECTION IS THE
SHIFT OF 60' TO THE WEST
PER DEEDS
DV 1229/469
DV 1229/464
OR 665/377

FROM HERE
TO HERE

I.P.
BEGINNING

PECK - WADSWORTH RD. 60'

SPLITS/DEEDS PROCESSED

LORAIN COUNTY TAX MAP DEPARTMENT
226 MIDDLE AVE. ELYRIA, OHIO

SURVEYED BY: ARNOLD KOEPP

CLOSURE: 0.01 : 10.000

MAP PAGE(S): 17-C

APPROVED BY: TJS DATE: 12/21/10

SCALE: 1" = 400' PRIOR INSTRUMENT: SEE ABOVE