




MASTER

PARENT PARCEL: 06-24-044-101-061, -062 06-24-047-101-021

CHILD PARCEL: 06-24-044-101-063 THRU -067

STARTING POINT: CENTERLINE OF MURRAY RIDGE RD & ADELBERT ST

06-02169

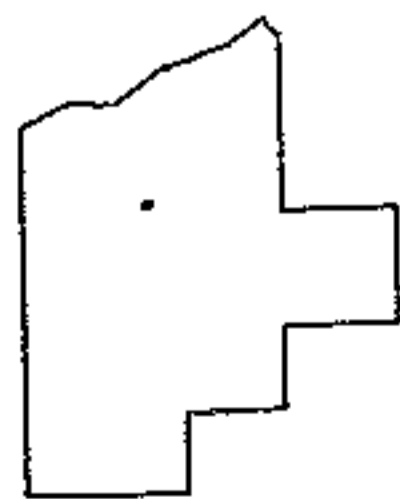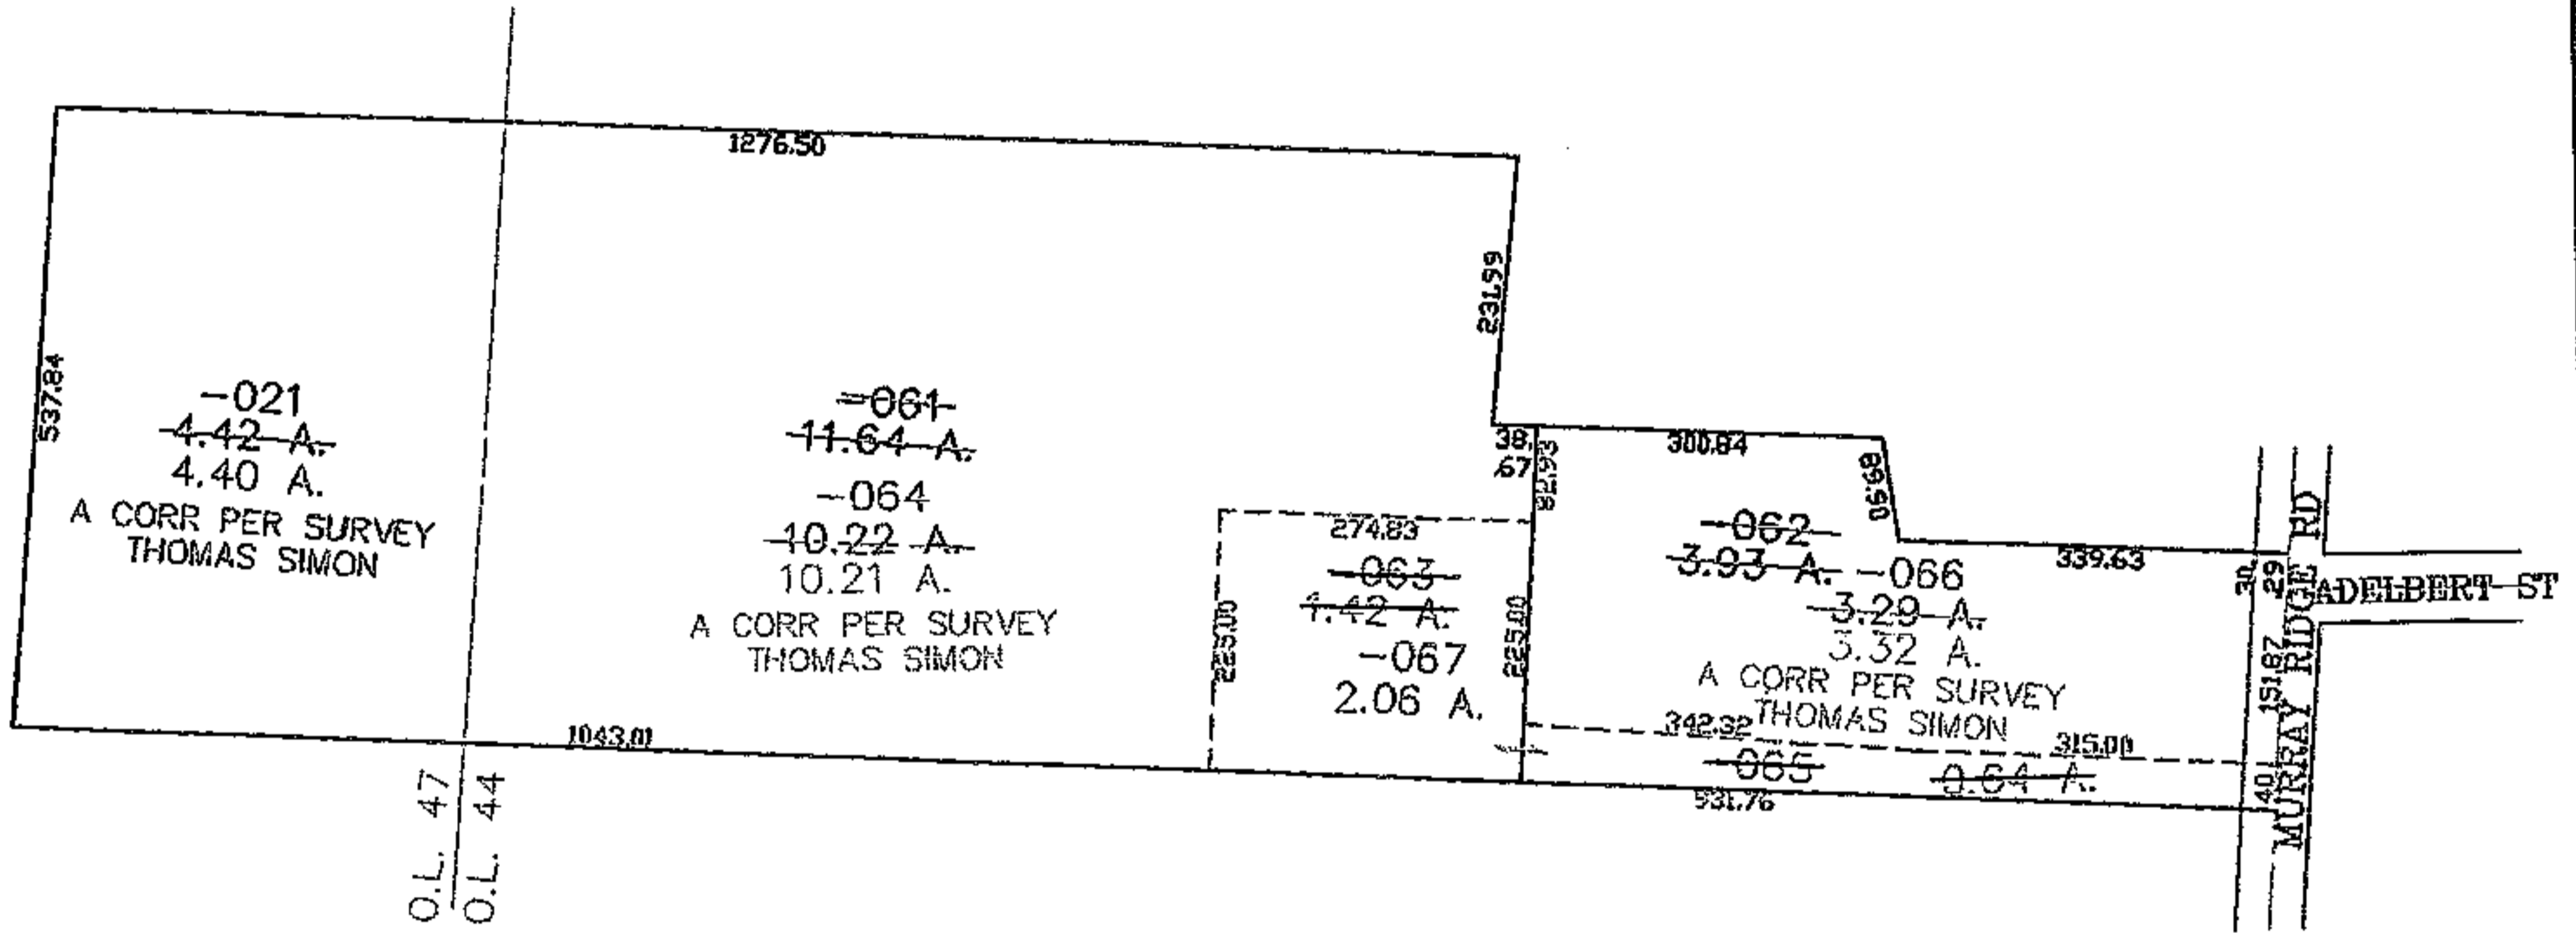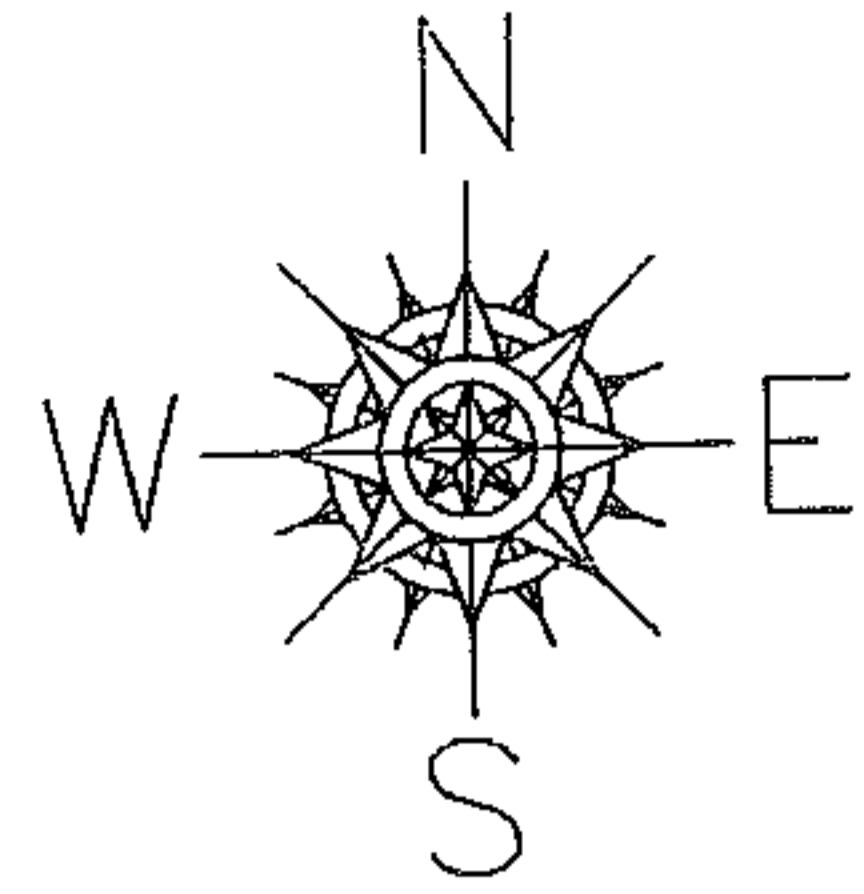

SPLITS/DEEDS PROCESSED

LORAIN COUNTY TAX MAP DEPARTMENT
226 MIDDLE AVE. ELYRIA, OHIO

SURVEYED BY: THOMAS SIMON
 CLOSURE: 0.00 : 10.000
 MAP PAGE(S): 6-39, 6-38
 APPROVED BY: JAH DATE: 6-20-06
 SCALE: 1" = 300 PRIOR INSTRUMENT: 980551937