




RASTER

PARENT PARCEL: 11-00-054-000-018, -019, -020

CHILD PARCEL: 11-00-054-000-040

STARTING POINT: CENTERLINE OF COOLEY RD & AVON BELDEN RD

06-02173

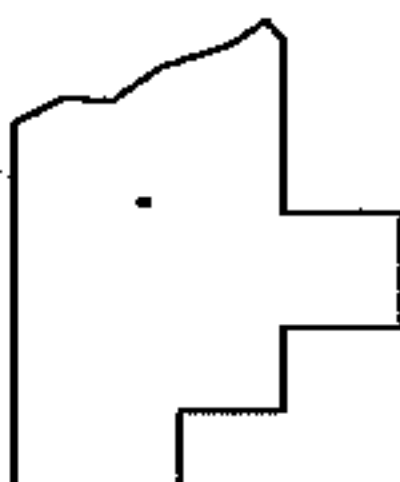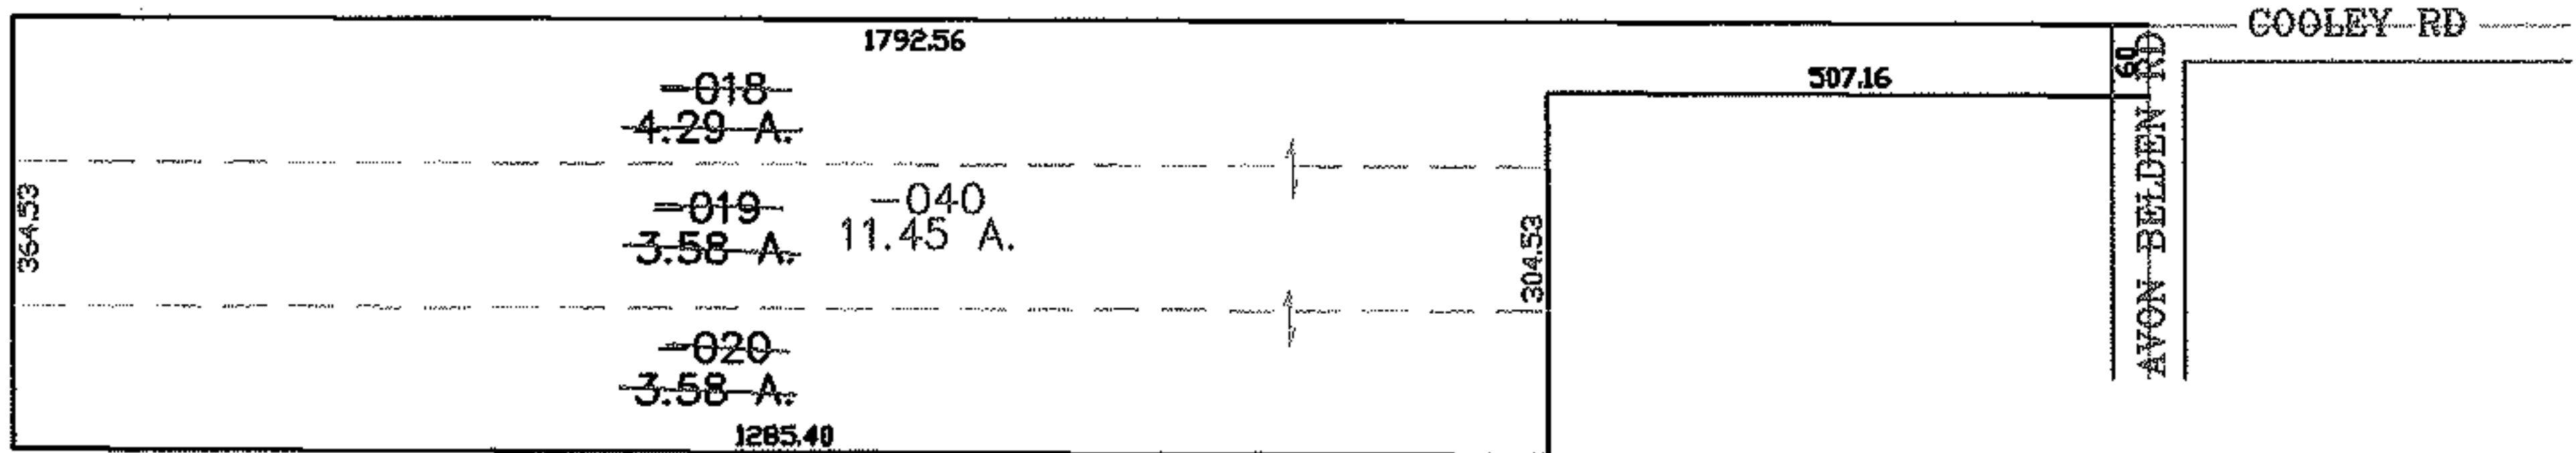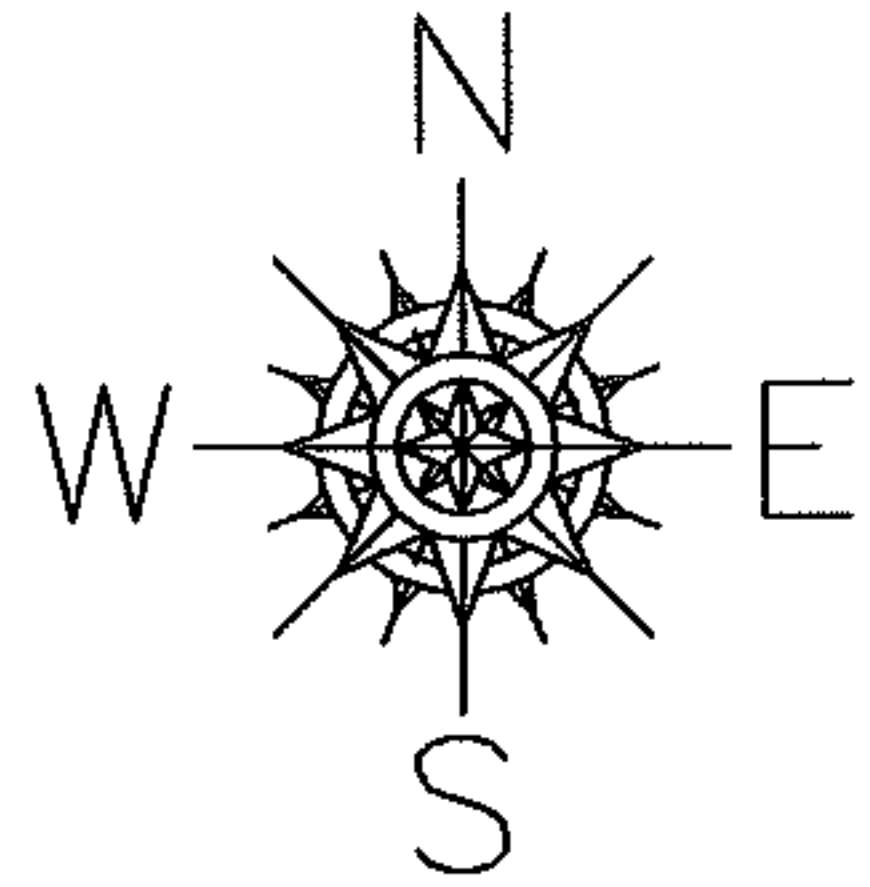

SPLITS/DEEDS PROCESSED
LORAIN COUNTY TAX MAP DEPARTMENT
 226 MIDDLE AVE. ELYRIA, OHIO

SURVEYED BY: CHRISTOPHER HIRZEL
 CLOSURE: 0.00 : 10.000
 MAP PAGE(S): 11-00-054-B
 APPROVED BY: JAH DATE: 6-20-06
 SCALE: 1" = 300 PRIOR INSTRUMENT: 2005078382