




RASTER

PARENT PARCEL: 04-00-004-102-116

CHILD PARCEL: 04-00-004-102-177 THRU -179

STARTING POINT: SIDELINE OF AVON CHESTER RD & S/L 2 OF CHESTER INDUSTRIAL PK

06-02174

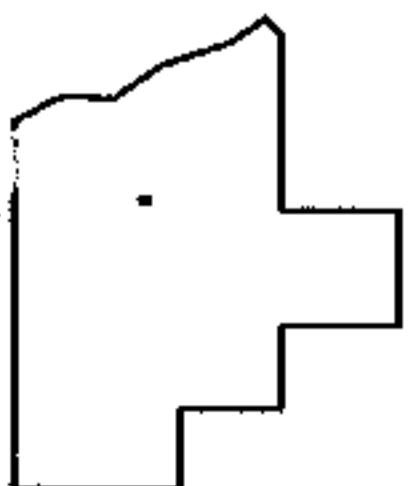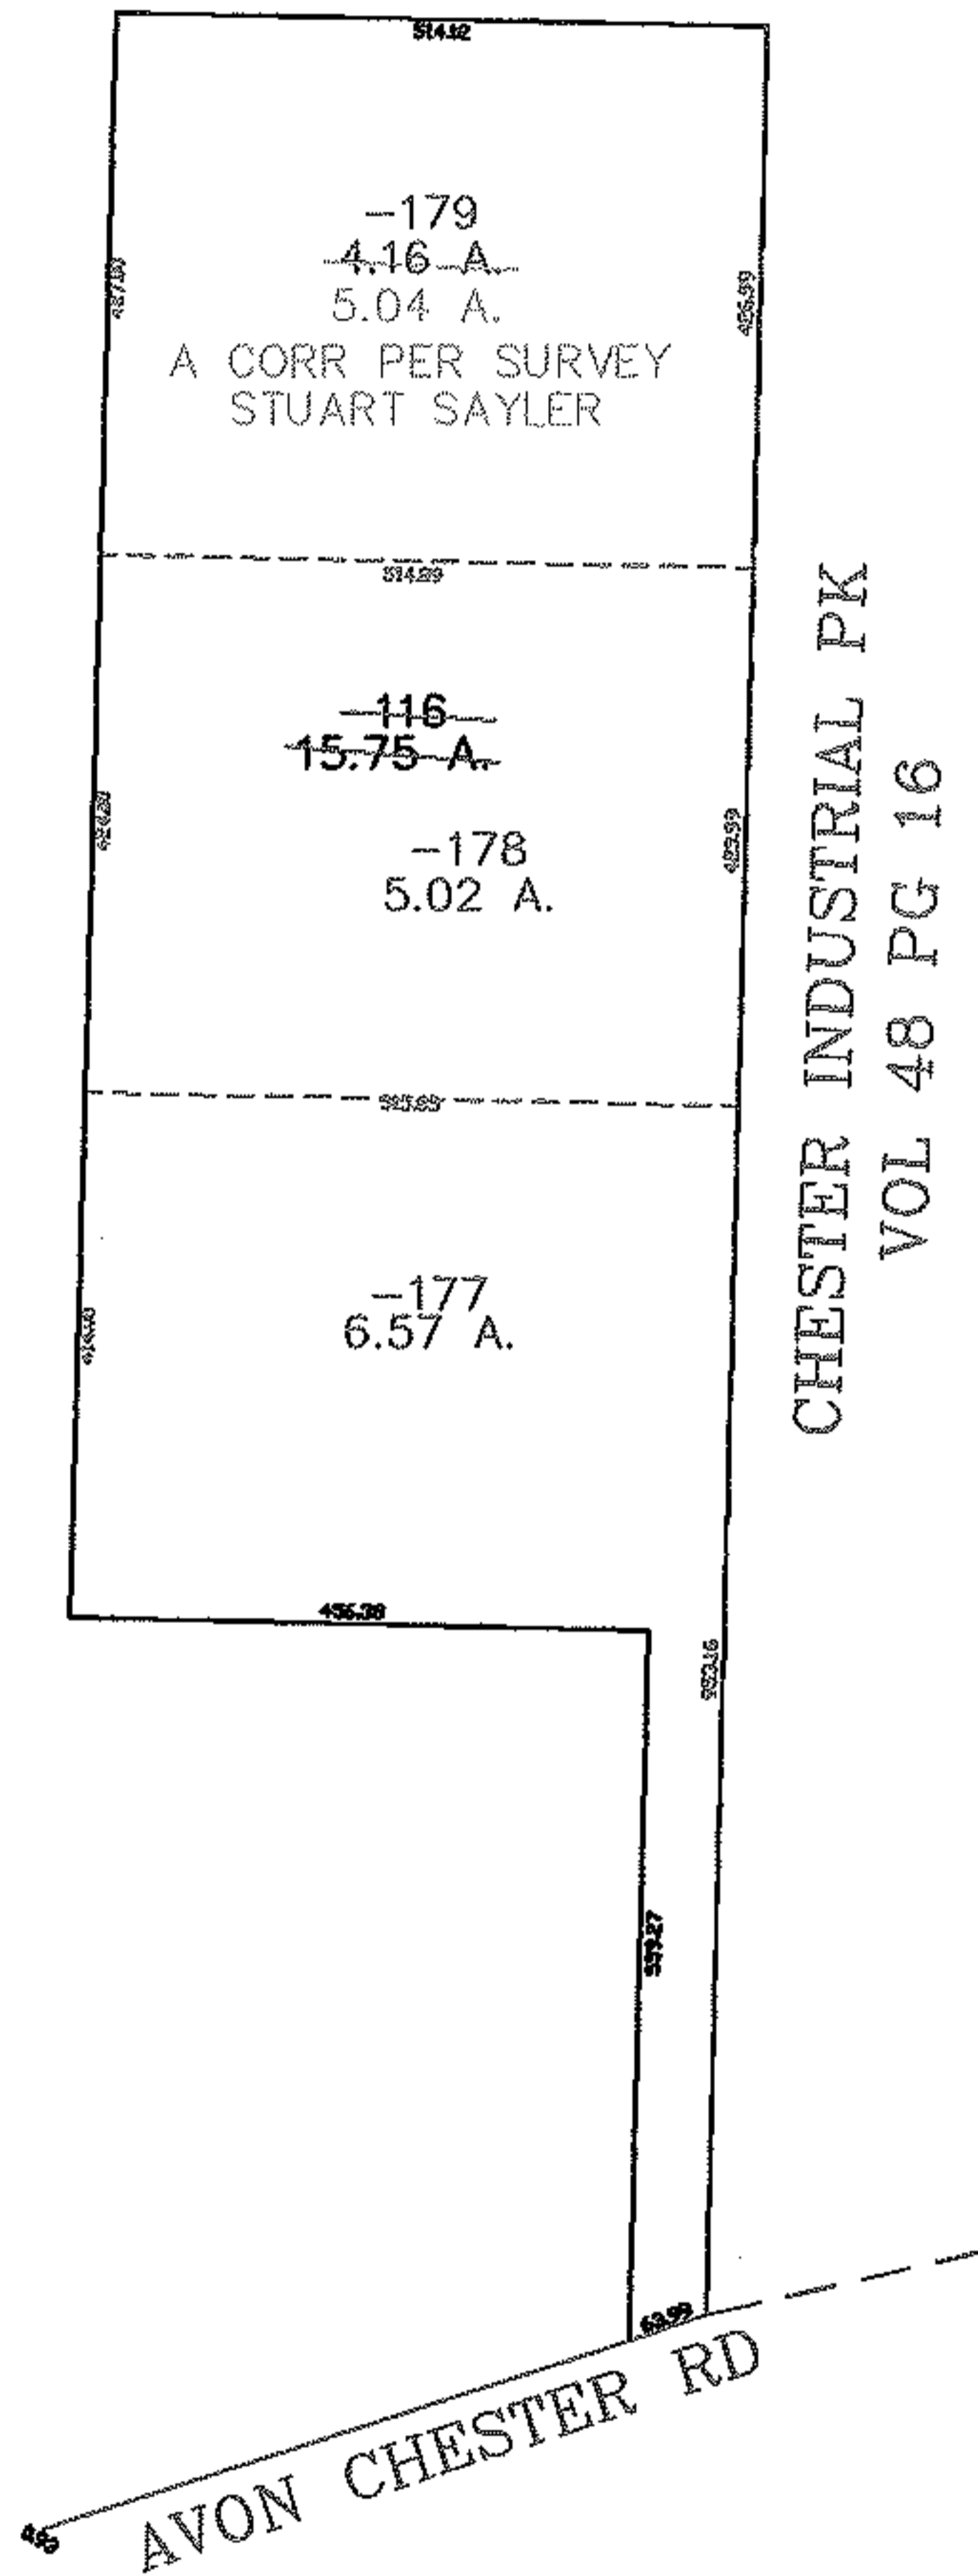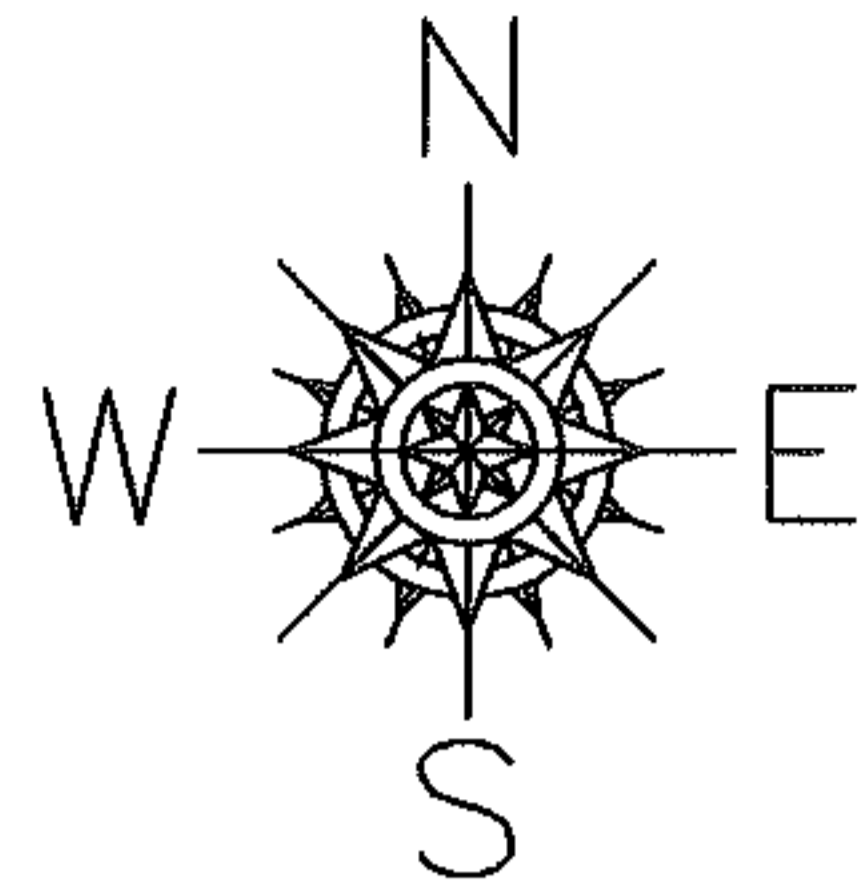

SPLITS/DEEDS PROCESSED

LORAIN COUNTY TAX MAP DEPARTMENT
226 MIDDLE AVE. ELYRIA, OHIO

SURVEYED BY: STUART SAYLER
 CLOSURE: 0.00 : 10.000
 MAP PAGE(S): 04-00-004-G
 APPROVED BY: JAH DATE: 6-22-06
 SCALE: 1" = 300 PRIOR INSTRUMENT: DV 183/695