


RASTER

PARENT PARCEL: 03-00-056-107-008

CHILD PARCEL: XX-XX-XXX-XXX-XXX

STARTING POINT: S/L 82 THRU 84 IN LARKMOOR SUB.(VOL.9 PG.20)

11-02175-C

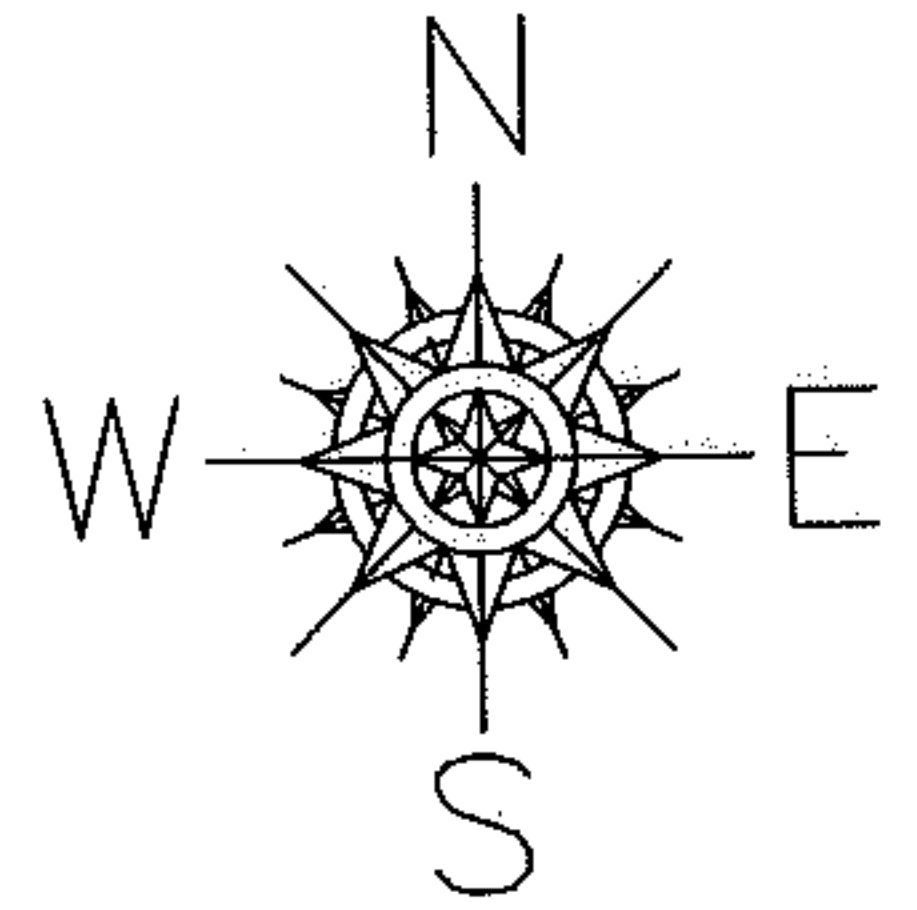

FRONTAGE AND DEPTH CORRECTION



03-00-056-107-008

52.84 X 130.01

~~52.86 X 122~~

PER PRIOR DEEDS

NEW JERSEY AVE.

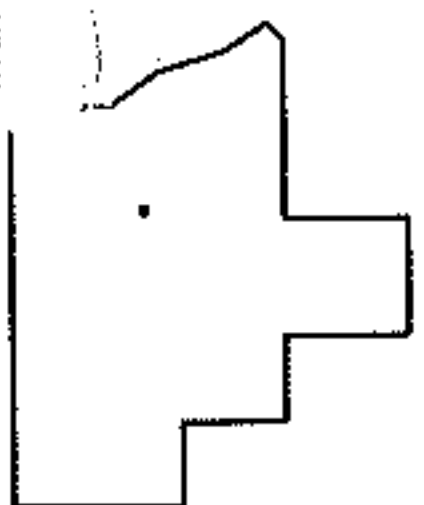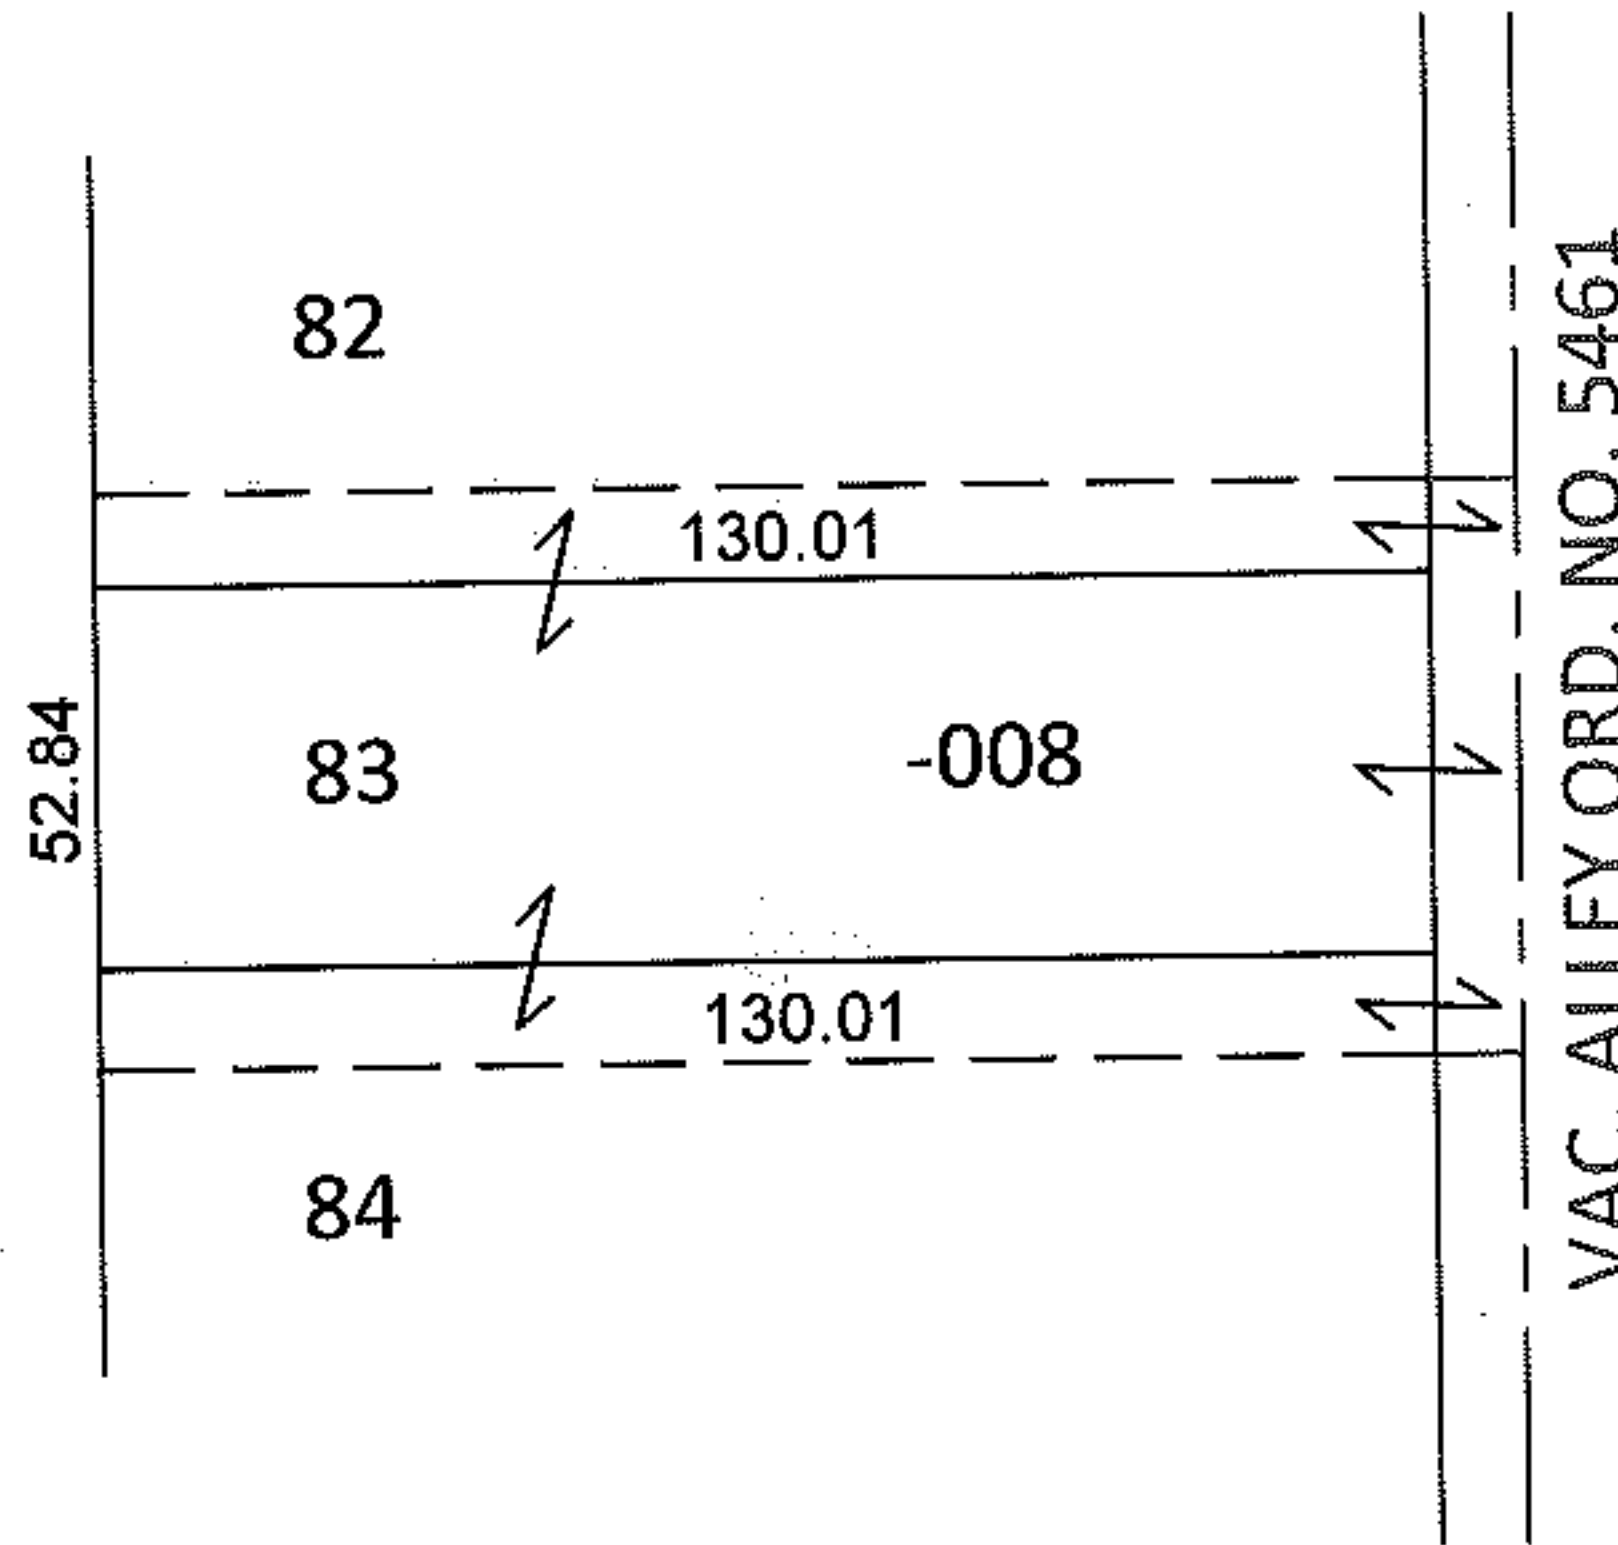

SPLITS/DEEDS PROCESSED

LORAIN COUNTY TAX MAP DEPARTMENT
226 MIDDLE AVE. ELYRIA, OHIO

SURVEYED BY: N/A

CLOSURE: N/A

MAP PAGE(S): 3-00-056-A

APPROVED BY: RRM DATE: 1-24-11

SCALE: 1"= 50' PRIOR INST.: 20010783293