




RASTER

PARENT PARCEL: 18-00-029-000-064

CHILD PARCEL: 18-00-029-000-104, -105

STARTING POINT: CENTERLINE OF COMMERCE DR & PATRIOT DR

06-02176

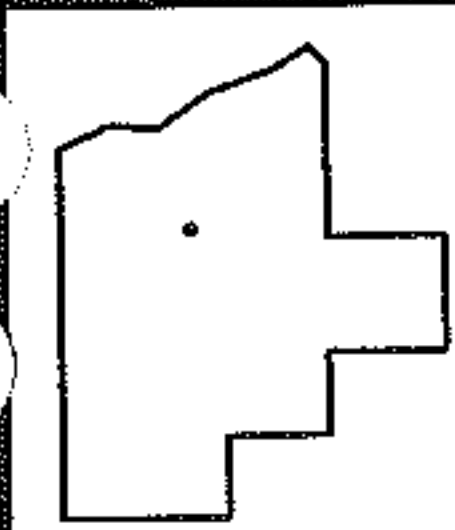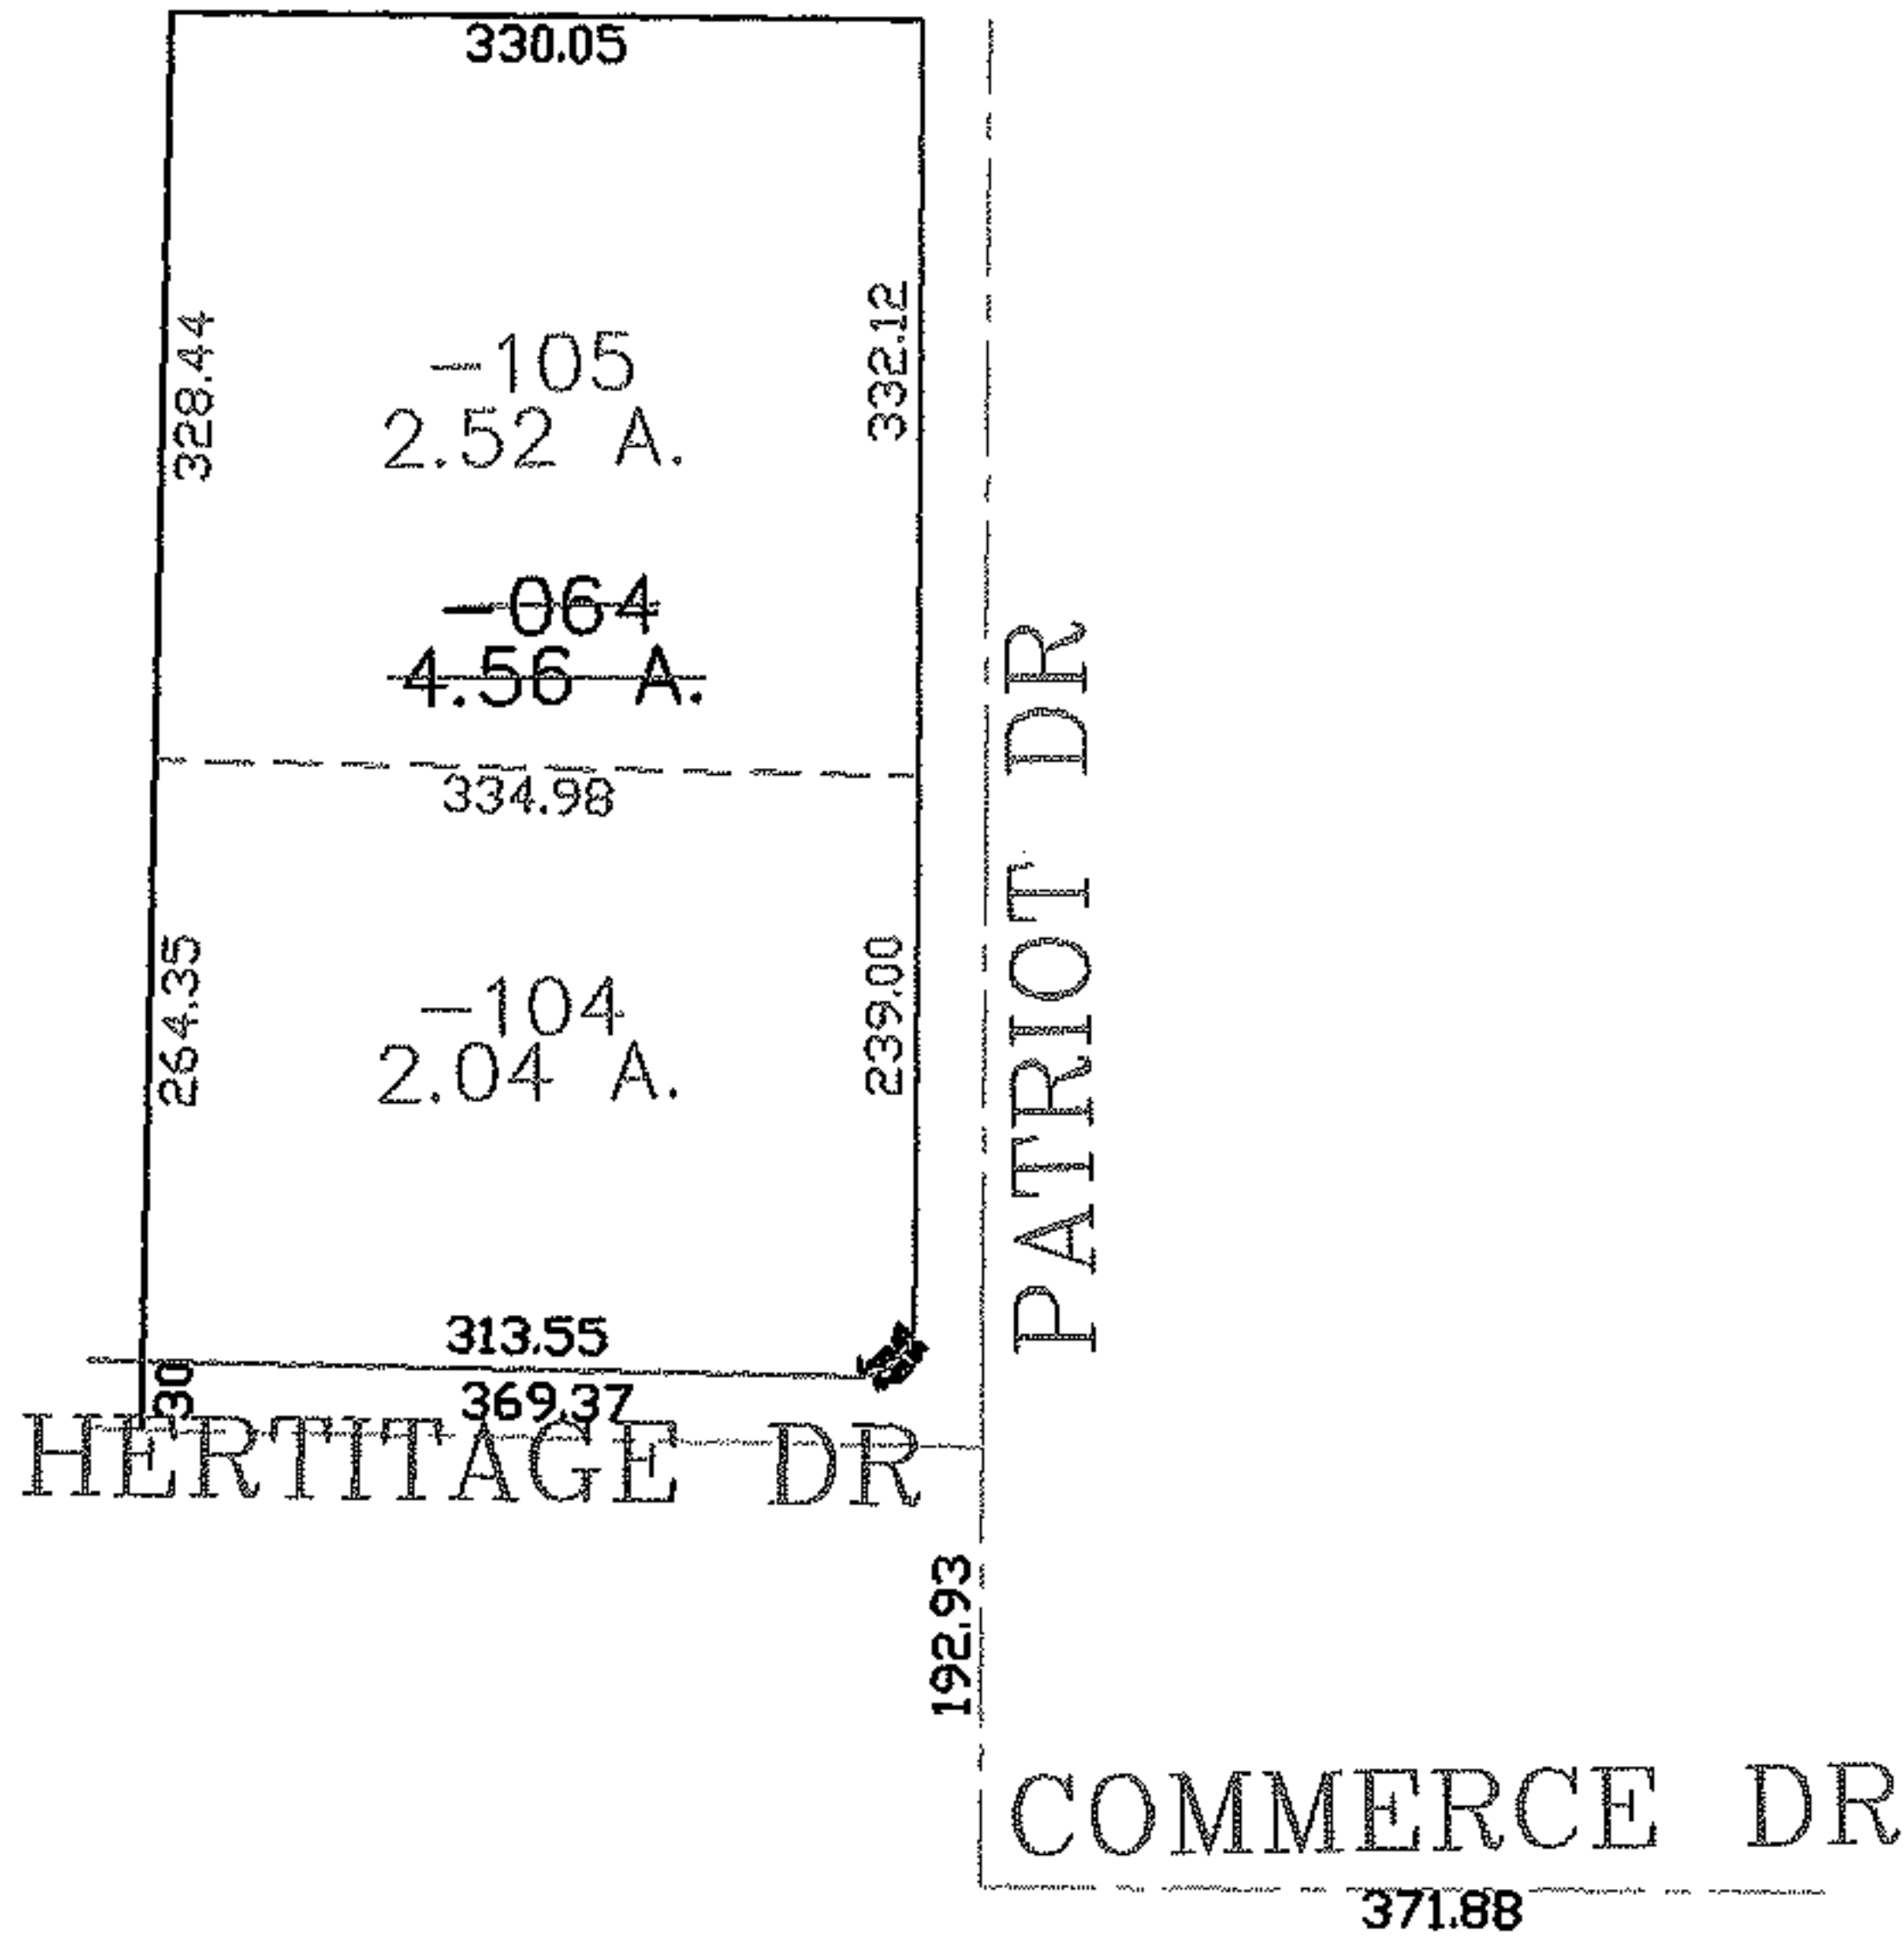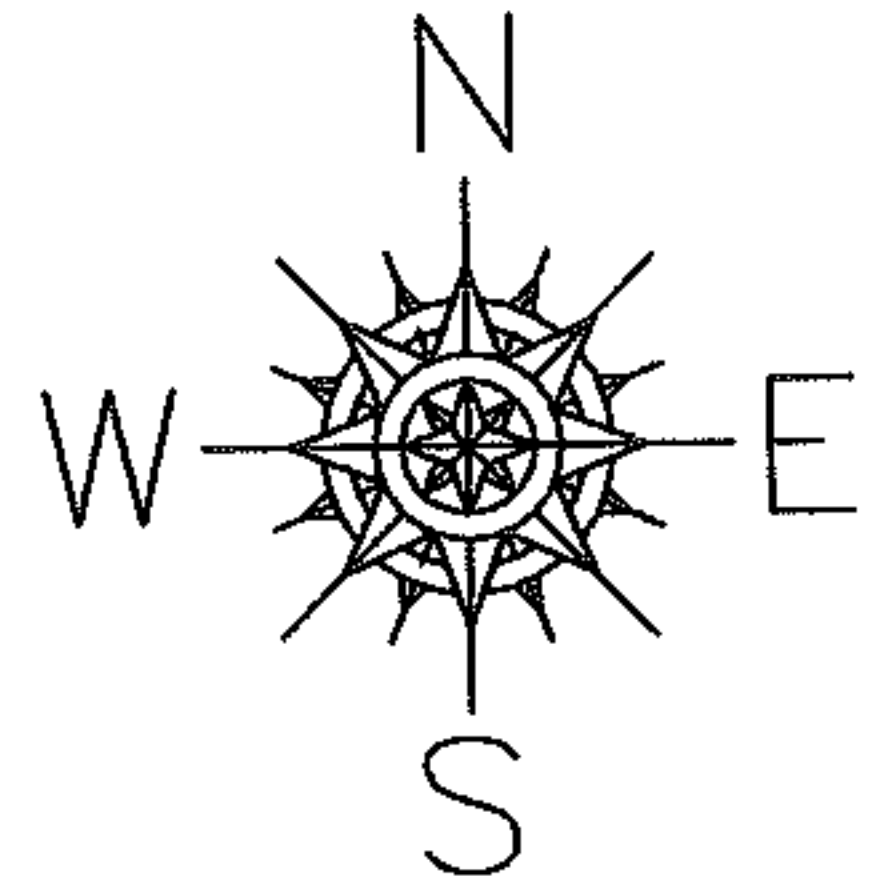

**SPLITS/DEEDS PROCESSED**  
 LORAIN COUNTY TAX MAP DEPARTMENT  
 226 MIDDLE AVE. ELYRIA, OHIO

SURVEYED BY: CHRISTOPHER HIRZEL  
 CLOSURE: 0.00 : 10.000  
 MAP PAGE(S): 18-00-029-D  
 APPROVED BY: JAH DATE: 9-19-06  
 SCALE: 1" = 200 PRIOR INSTRUMENT: PL VL 89/6