
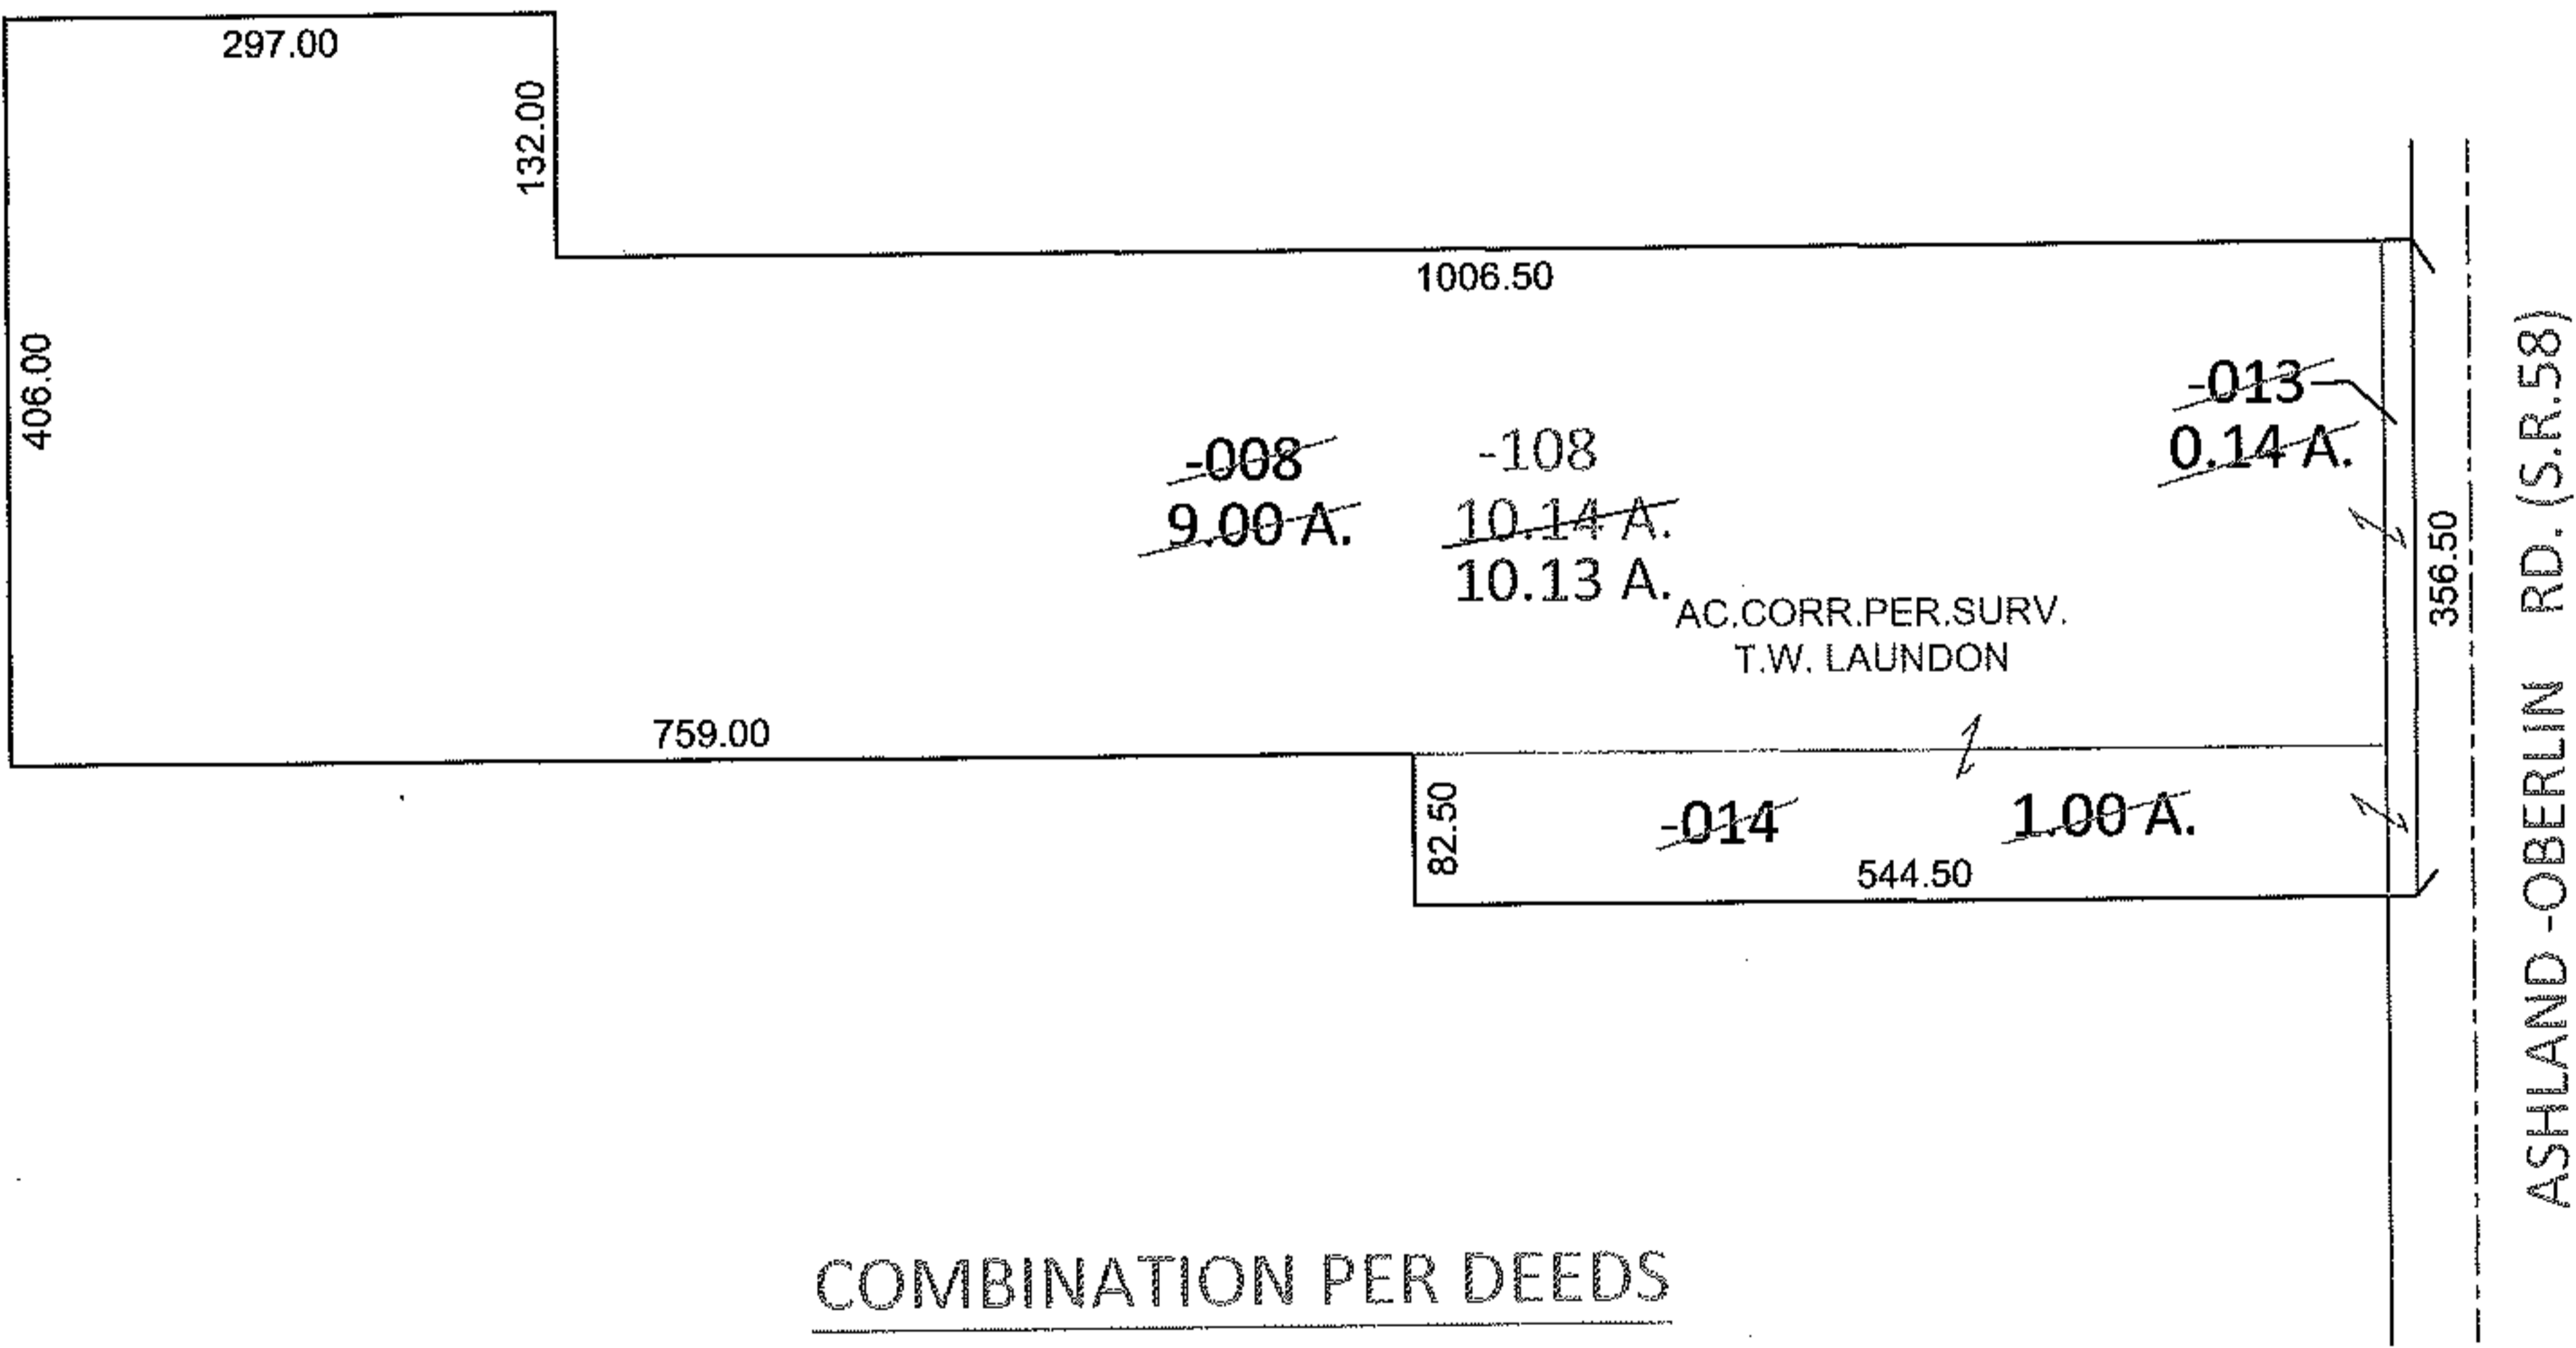



PARENT PARCEL: 18-00-029-000-008, -013, -014  
CHILD PARCEL: 18-00-029-000-108  
STARTING POINT: INTERSECTION OF WEST R.O.W. LINE OF S.R. 58 AND NORTH LINE OF LAND CONVEYED TO CLYDE RAY (DV 411/63)

11-02181-C

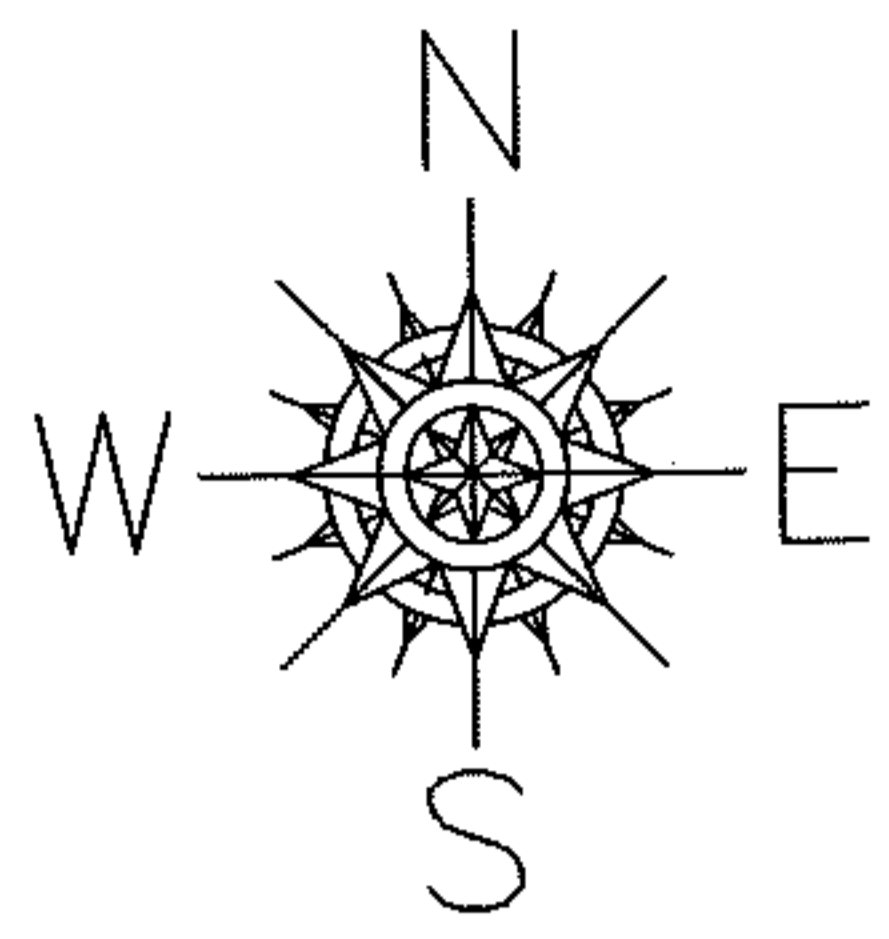

COMBINATION PER DEEDS

DV 594/74  
20030928916

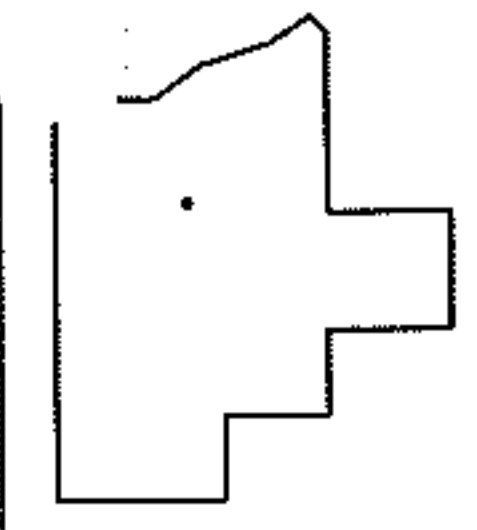

SPLITS/DEEDS PROCESSED  
LORAIN COUNTY TAX MAP DEPARTMENT  
226 MIDDLE AVE. ELYRIA, OHIO

SURVEYED BY: T.W. LAUNDON  
CLOSURE: .00:10.000  
MAP PAGE(S): 18-00-029-D  
APPROVED BY: RRM DATE: 1-4-11  
SCALE: 1"= 200 PRIOR INST.: SEE ABOVE